
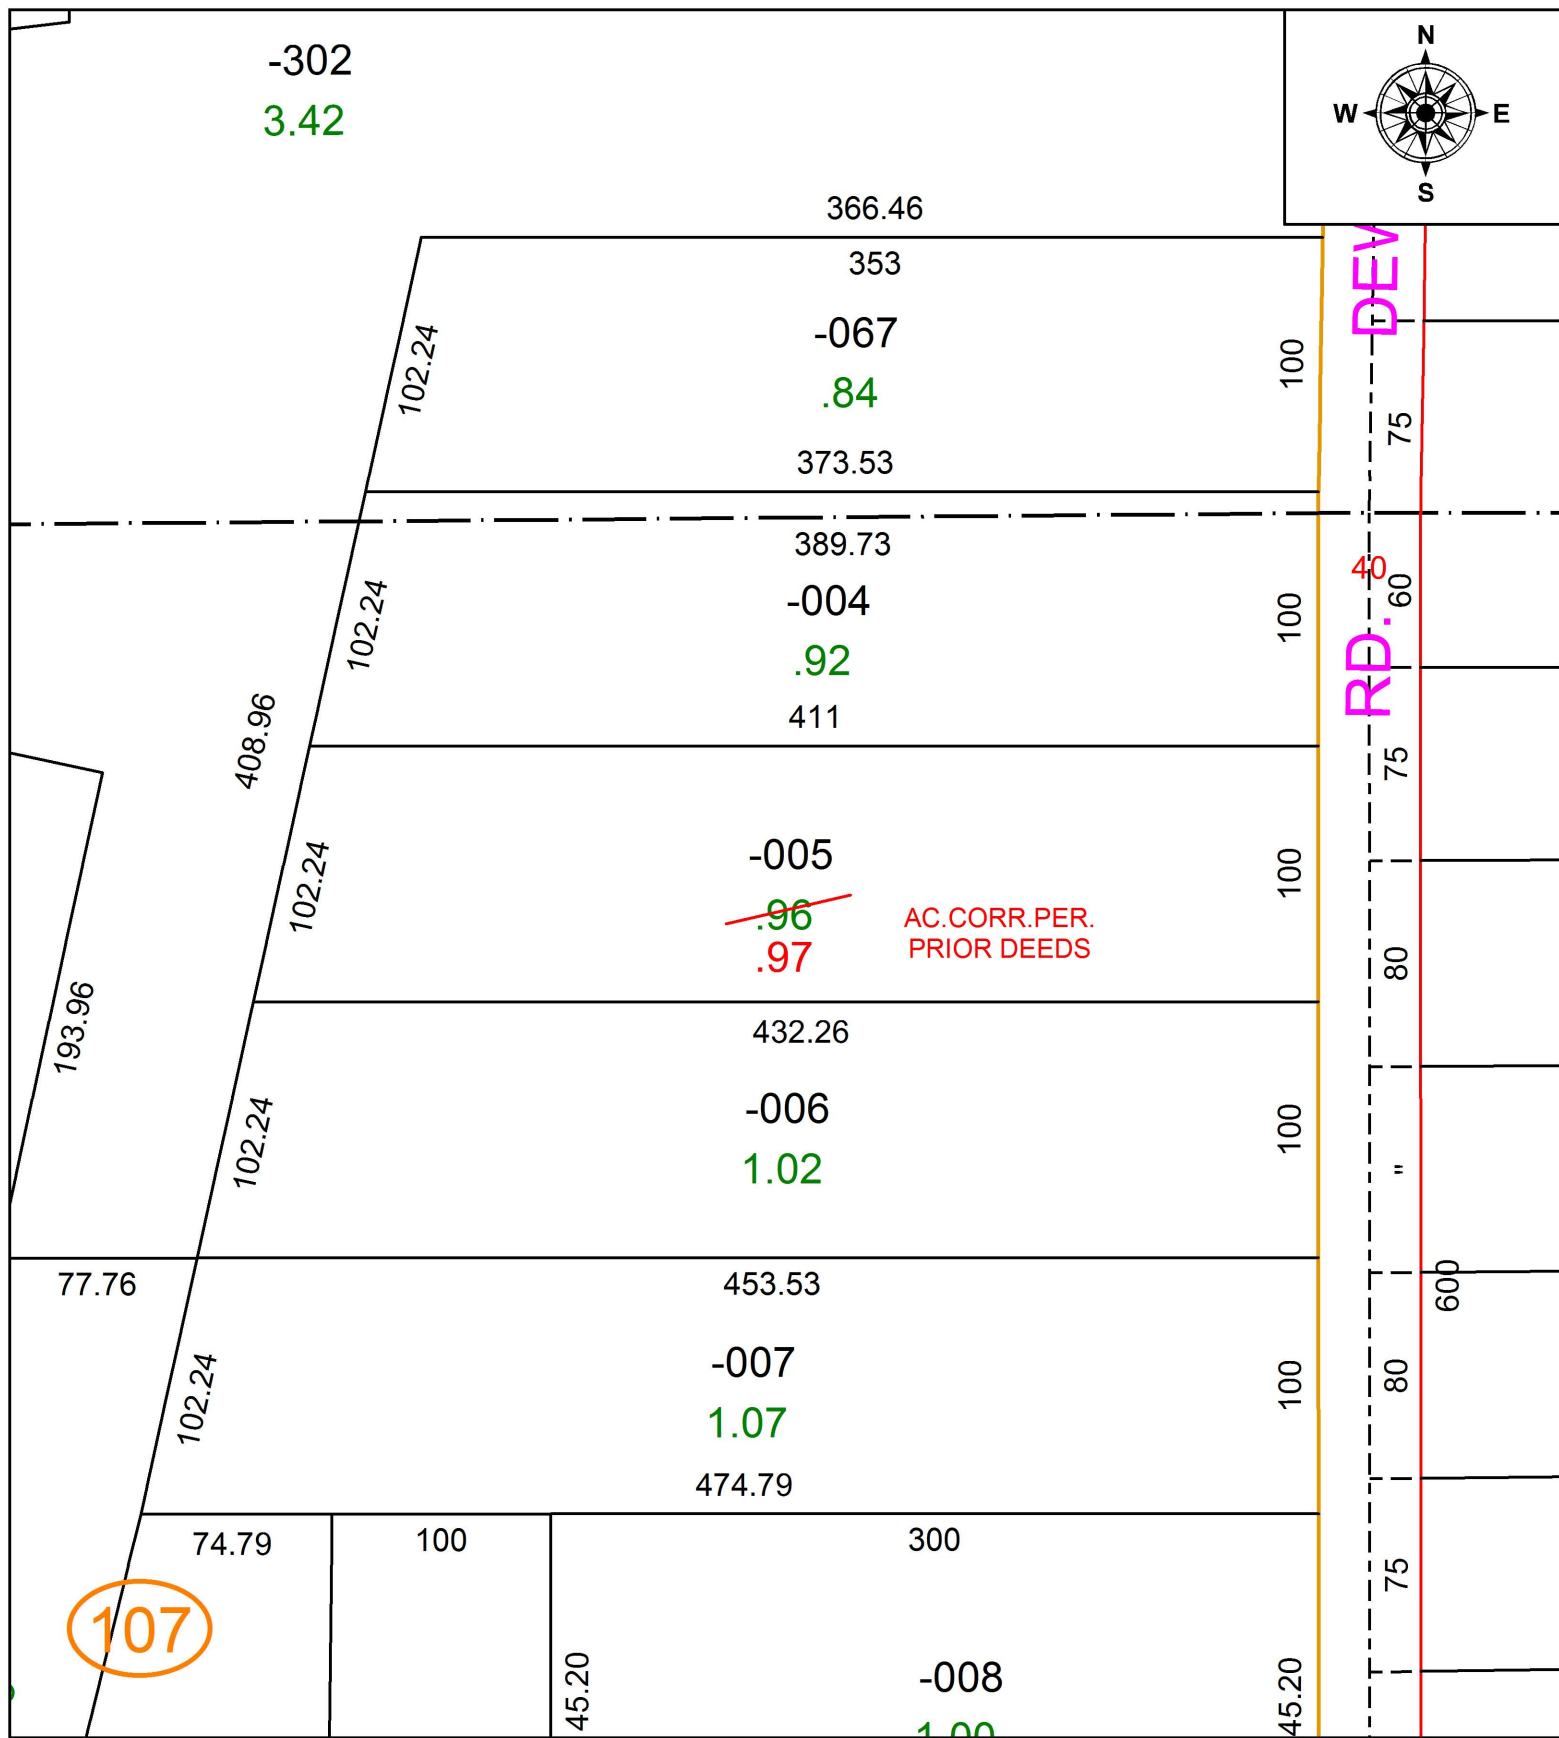


PARENT PARCEL: 10-00-006-107-005

CHILD PARCEL: XX-XX-XXX-XXX-XXX

STARTING POINT: WESTERLY LINE OF DEWHURST RD. AND C/L OF EAST RIVER RD.

16-03431-A

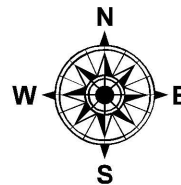

-302
3.42

366.46

353

-067

.84

373.53

389.73

-004

.92

411

-005

~~.96~~
.97

AC. CORR. PER.
PRIOR DEEDS

432.26

-006

1.02

77.76

453.53

-007

1.07

474.79

74.79

100

300


107

45.20

-008

1.00

45.20

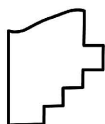

SPLITS/DEEDS PROCESSED

LORAIN COUNTY TAX MAP DEPARTMENT
226 MIDDLE AVE. ELYRIA, OH

SURVEYED BY: _____ N/A

CLOSURE: 1: 137,927

MAP PAGE(S): 10-00-006-D

APPROVED BY: RRM DATE: 4-21-16

SCALE: 1" = 75' PRIOR INSTRUMENT: 20160577591