
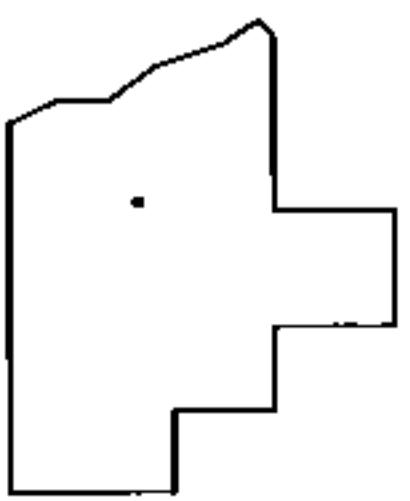
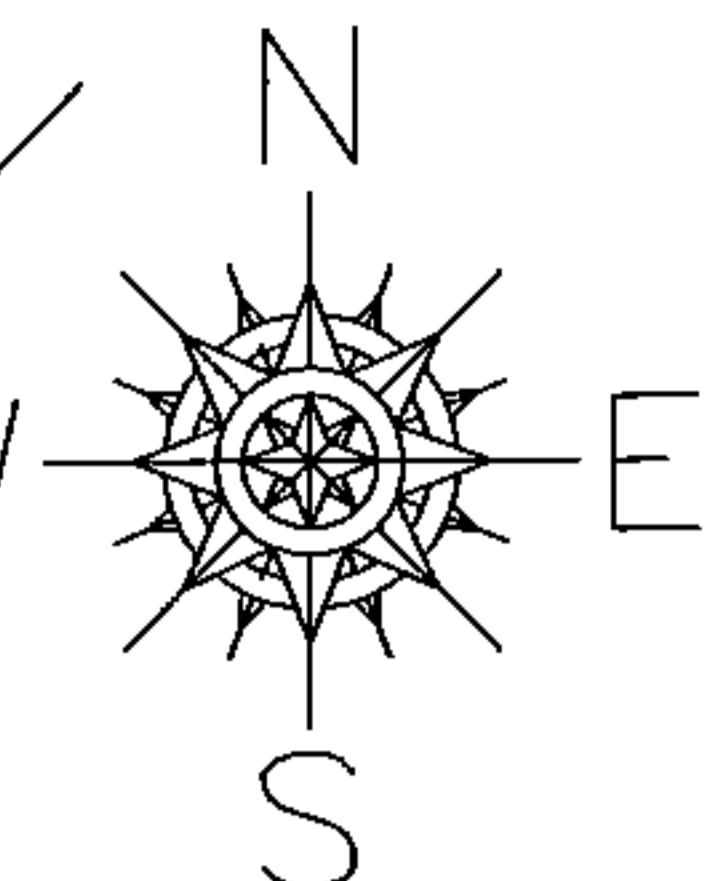


PARENT PARCEL: 07-00-004-108-099, -101, -102, -100

CHILD PARCEL: 07-00-004-108-112

STARTING POINT: CENTERLINE OF CHESTNUT RIDGE RD & LEAR NAGLE RD

15-03431

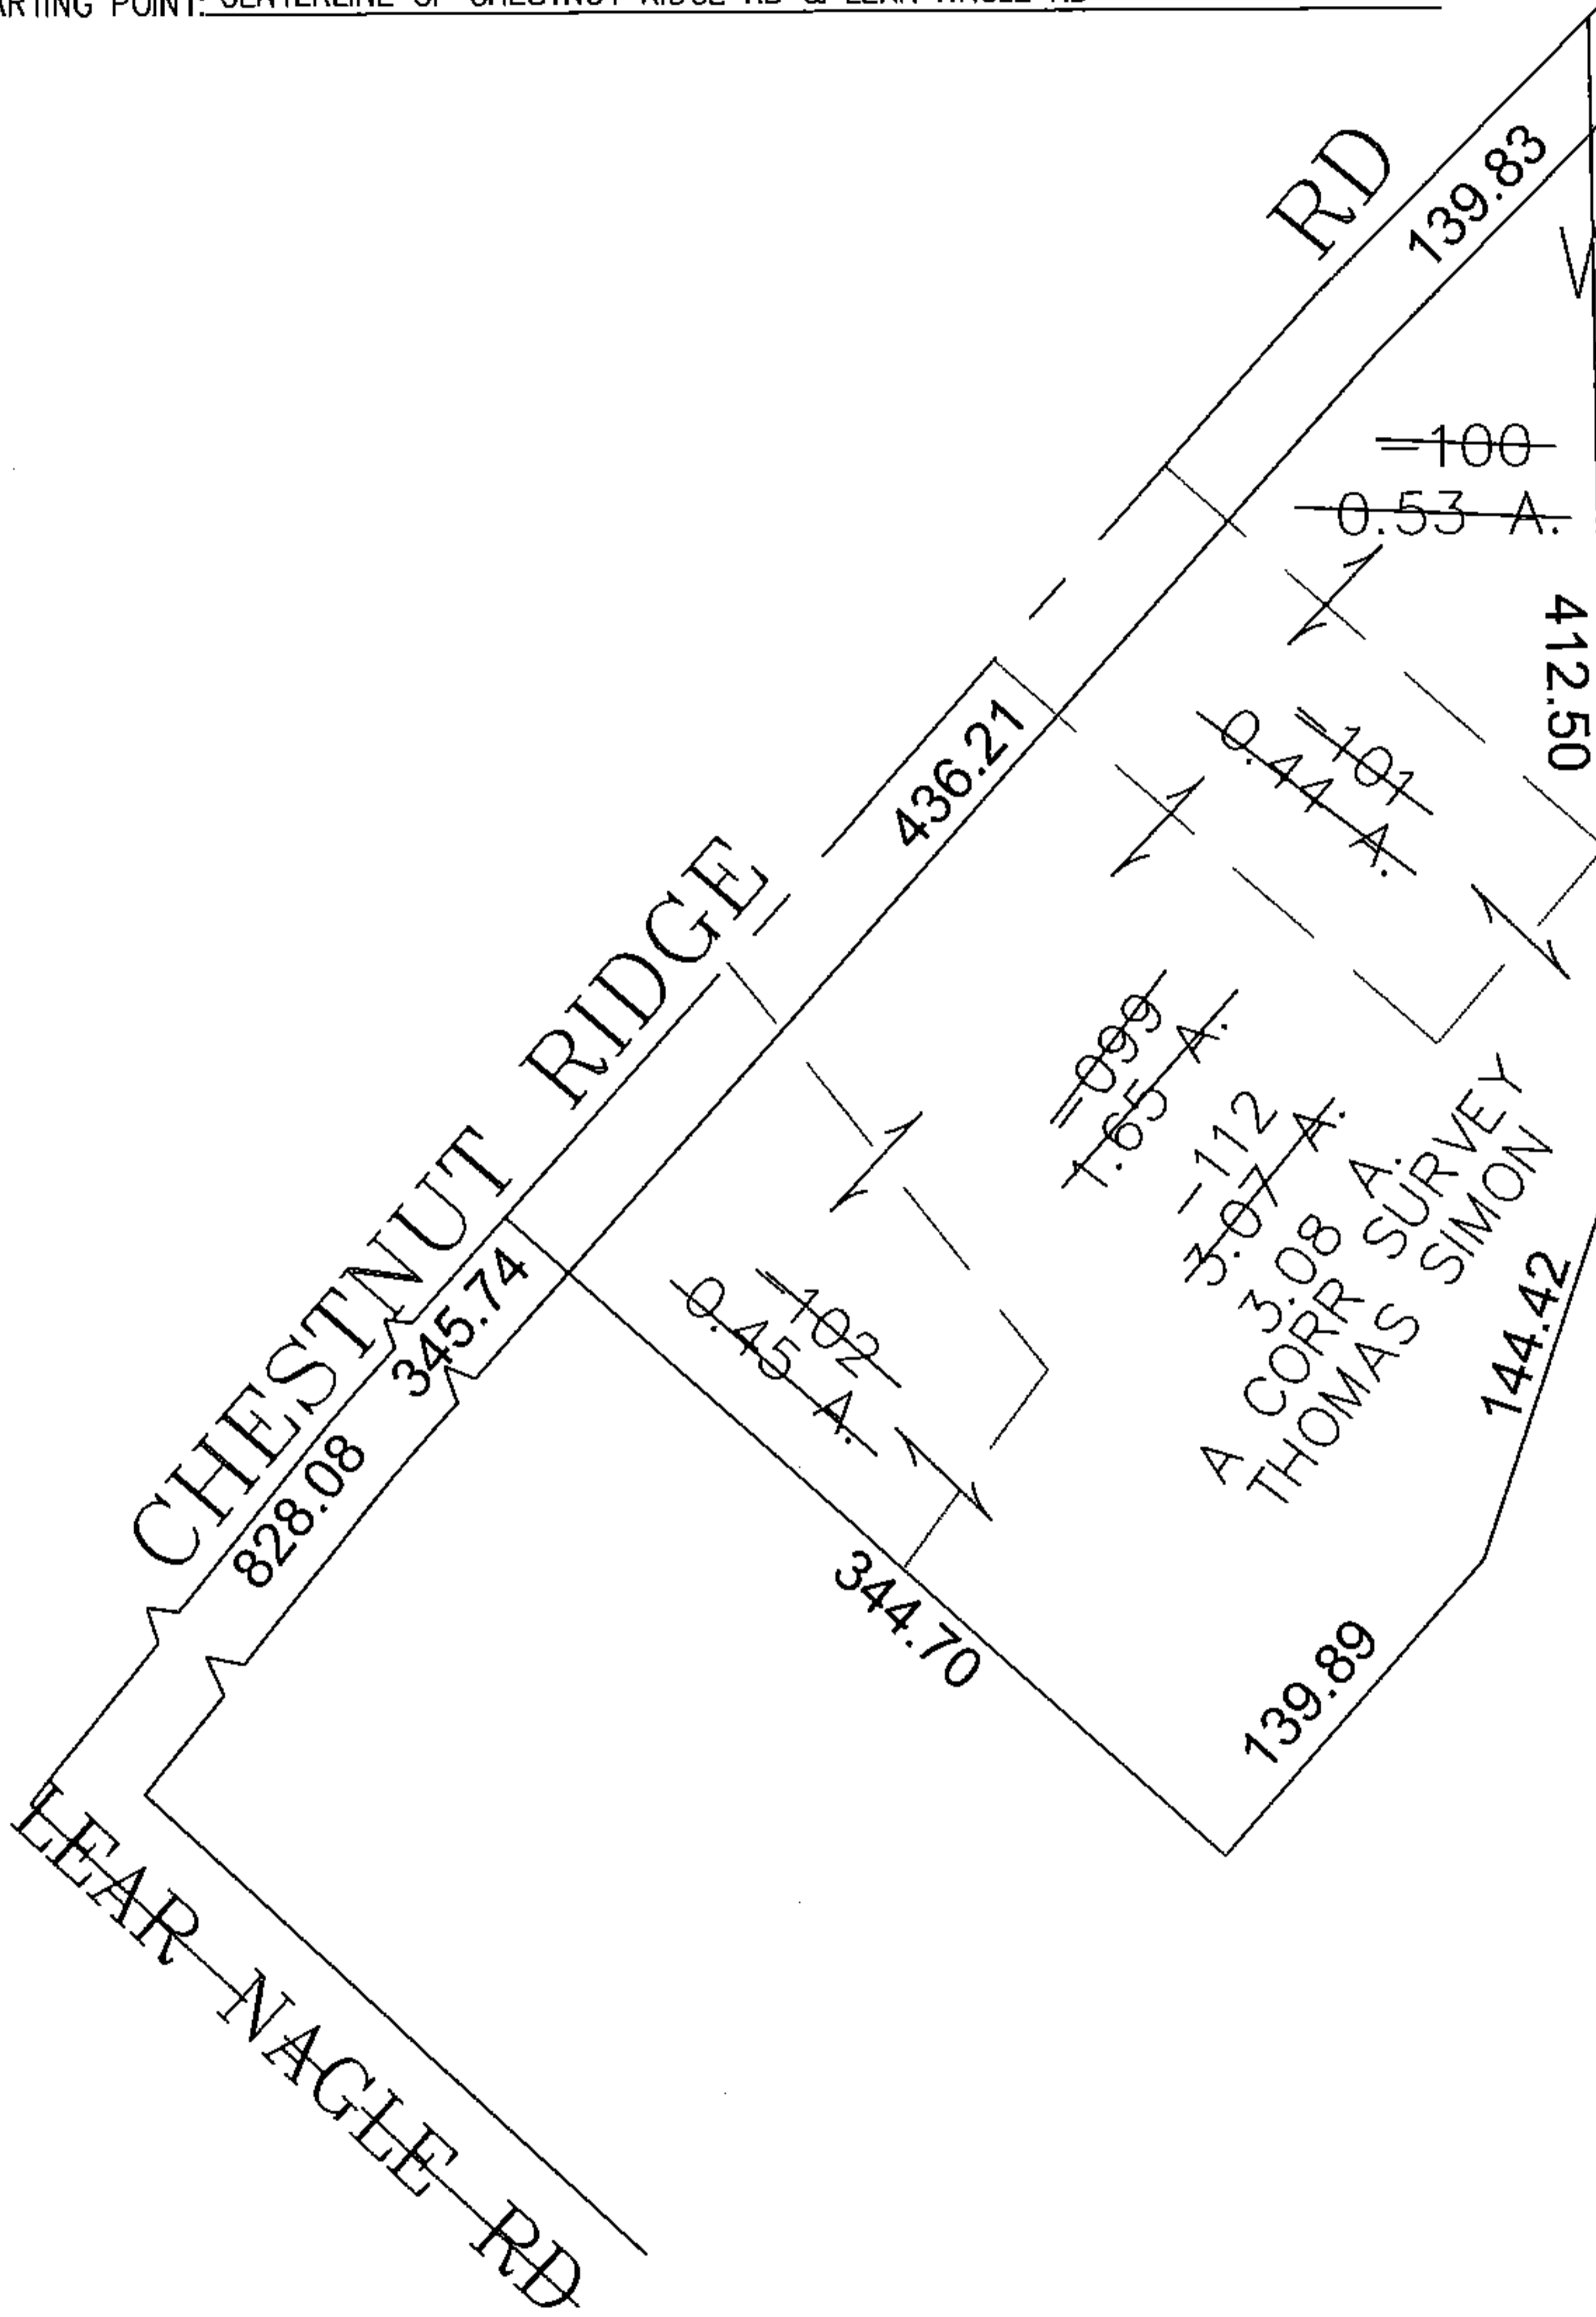

SPLITS/DEEDS PROCESSED

LORAIN COUNTY TAX MAP DEPARTMENT
226 MIDDLE AVE. ELYRIA, OHIO

SURVEYED BY: THOMAS SIMON

CLOSURE: 0.00 : 10.000

MAP PAGE(S): 07-00-004

APPROVED BY: JAH DATE: 10/7/2015

SCALE: 1" = 100 PRIOR INSTRUMENT: 20150533764