

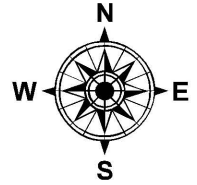


PARENT PARCEL: 21-01-013-000-002
CHILD PARCEL: XX-XX-XXX-XXX-XXX
STARTING POINT:

16-03432-A

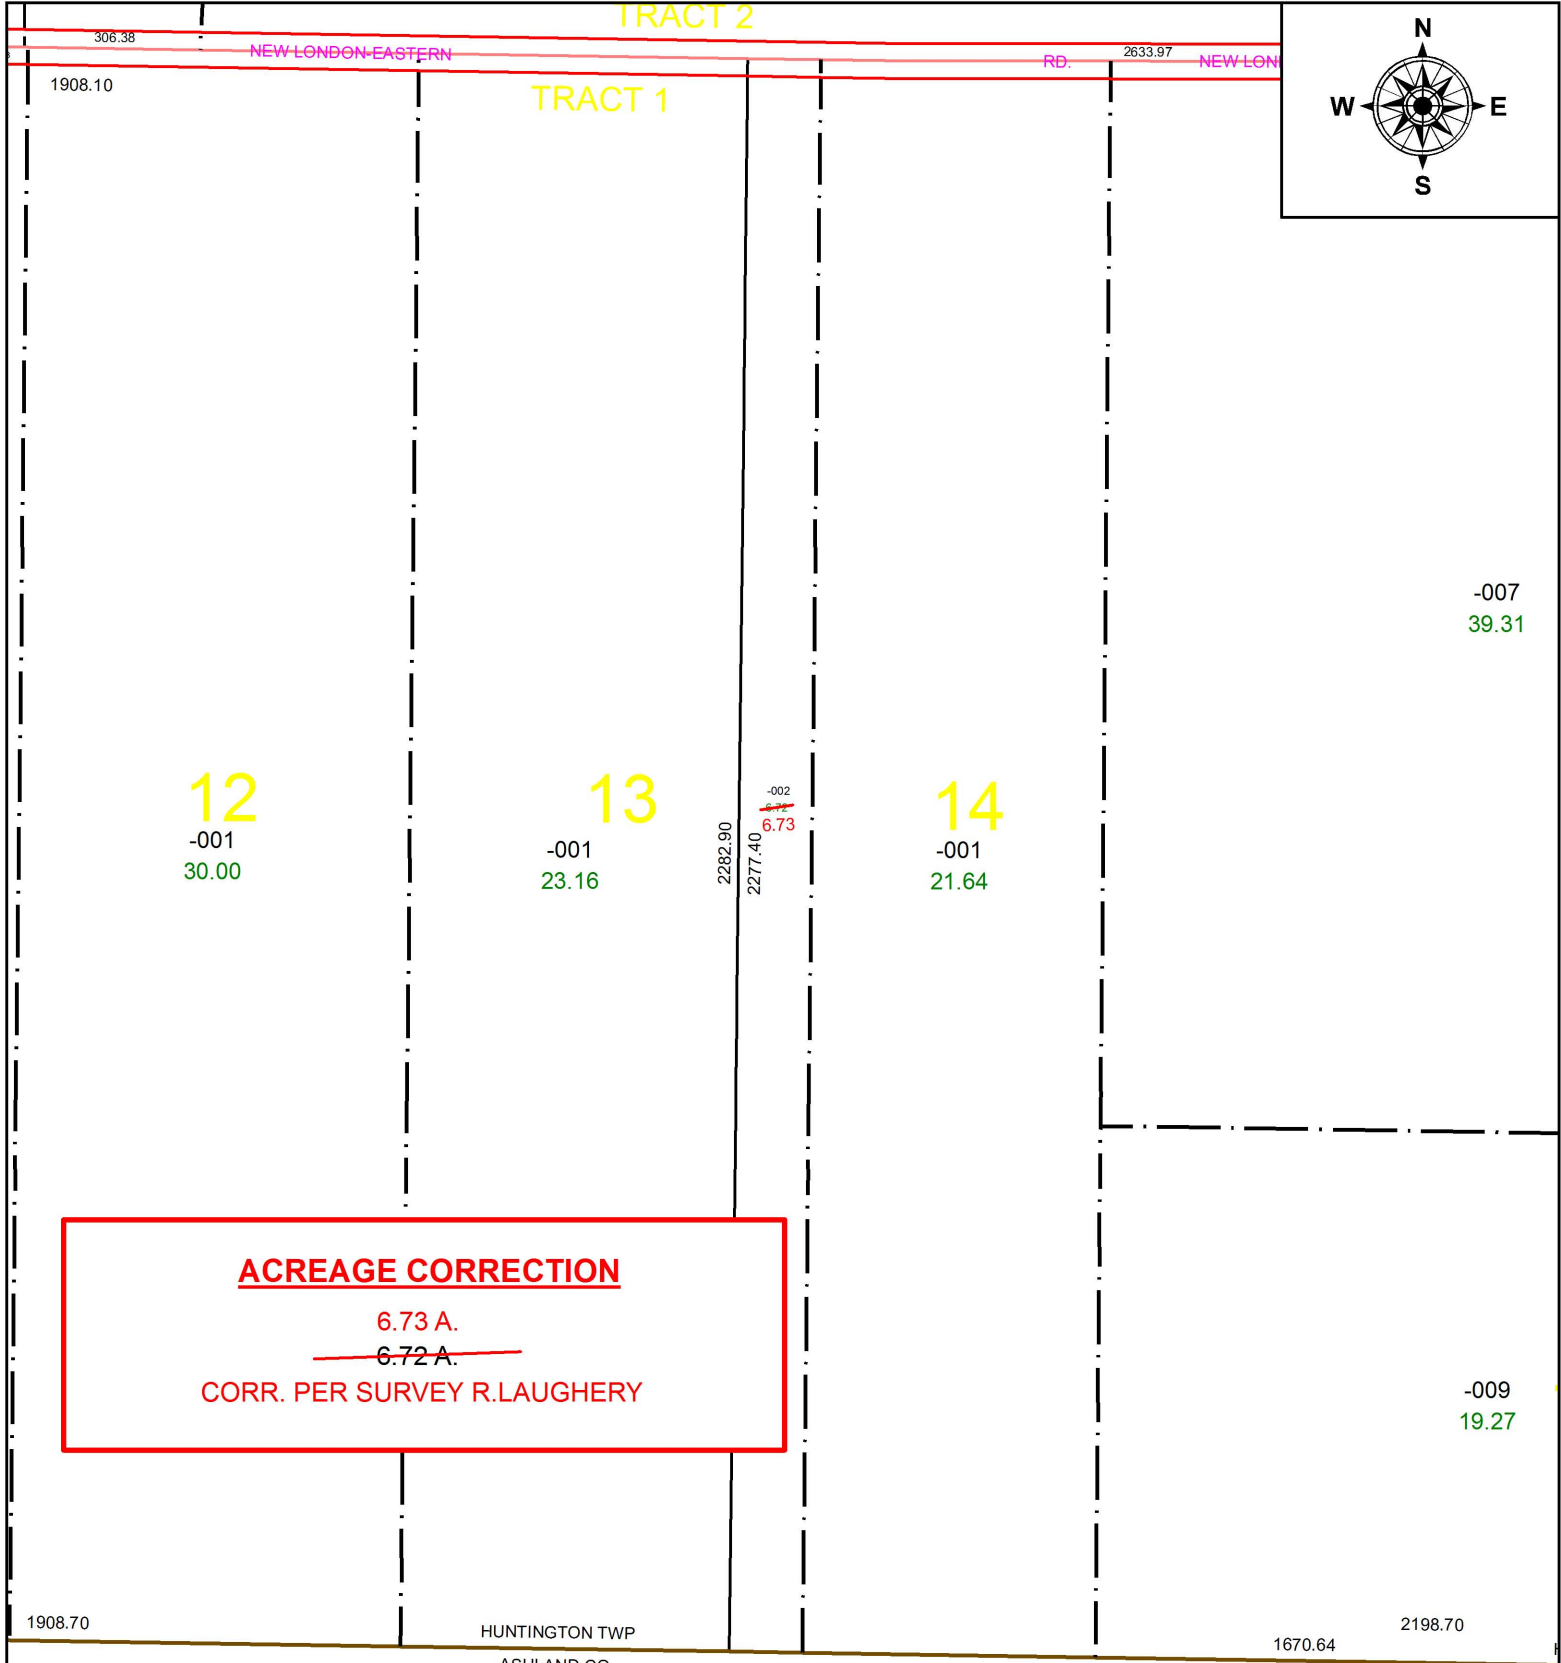

ACREAGE CORRECTION
6.73 A.
~~6.72 A.~~
CORR. PER SURVEY R. LAUGHERY

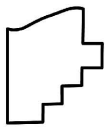

SPLITS/DEEDS PROCESSED
LORAIN COUNTY TAX MAP DEPARTMENT
226 MIDDLE AVE. ELYRIA, OH

SURVEYED BY: RONALD L. LAUGHERY
CLOSURE: N/A
MAP PAGE(S): 21-F
APPROVED BY: RRM DATE: 4-21-16
SCALE: 1" = 275 PRIOR INSTRUMENT: 20120411542