
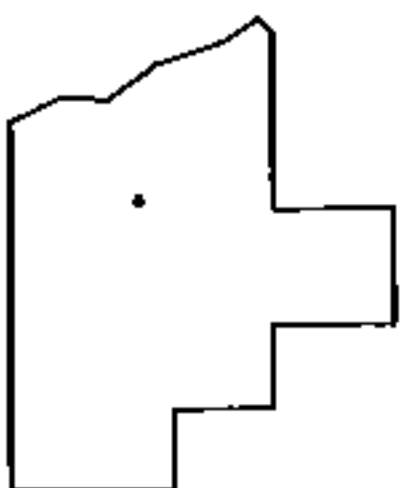
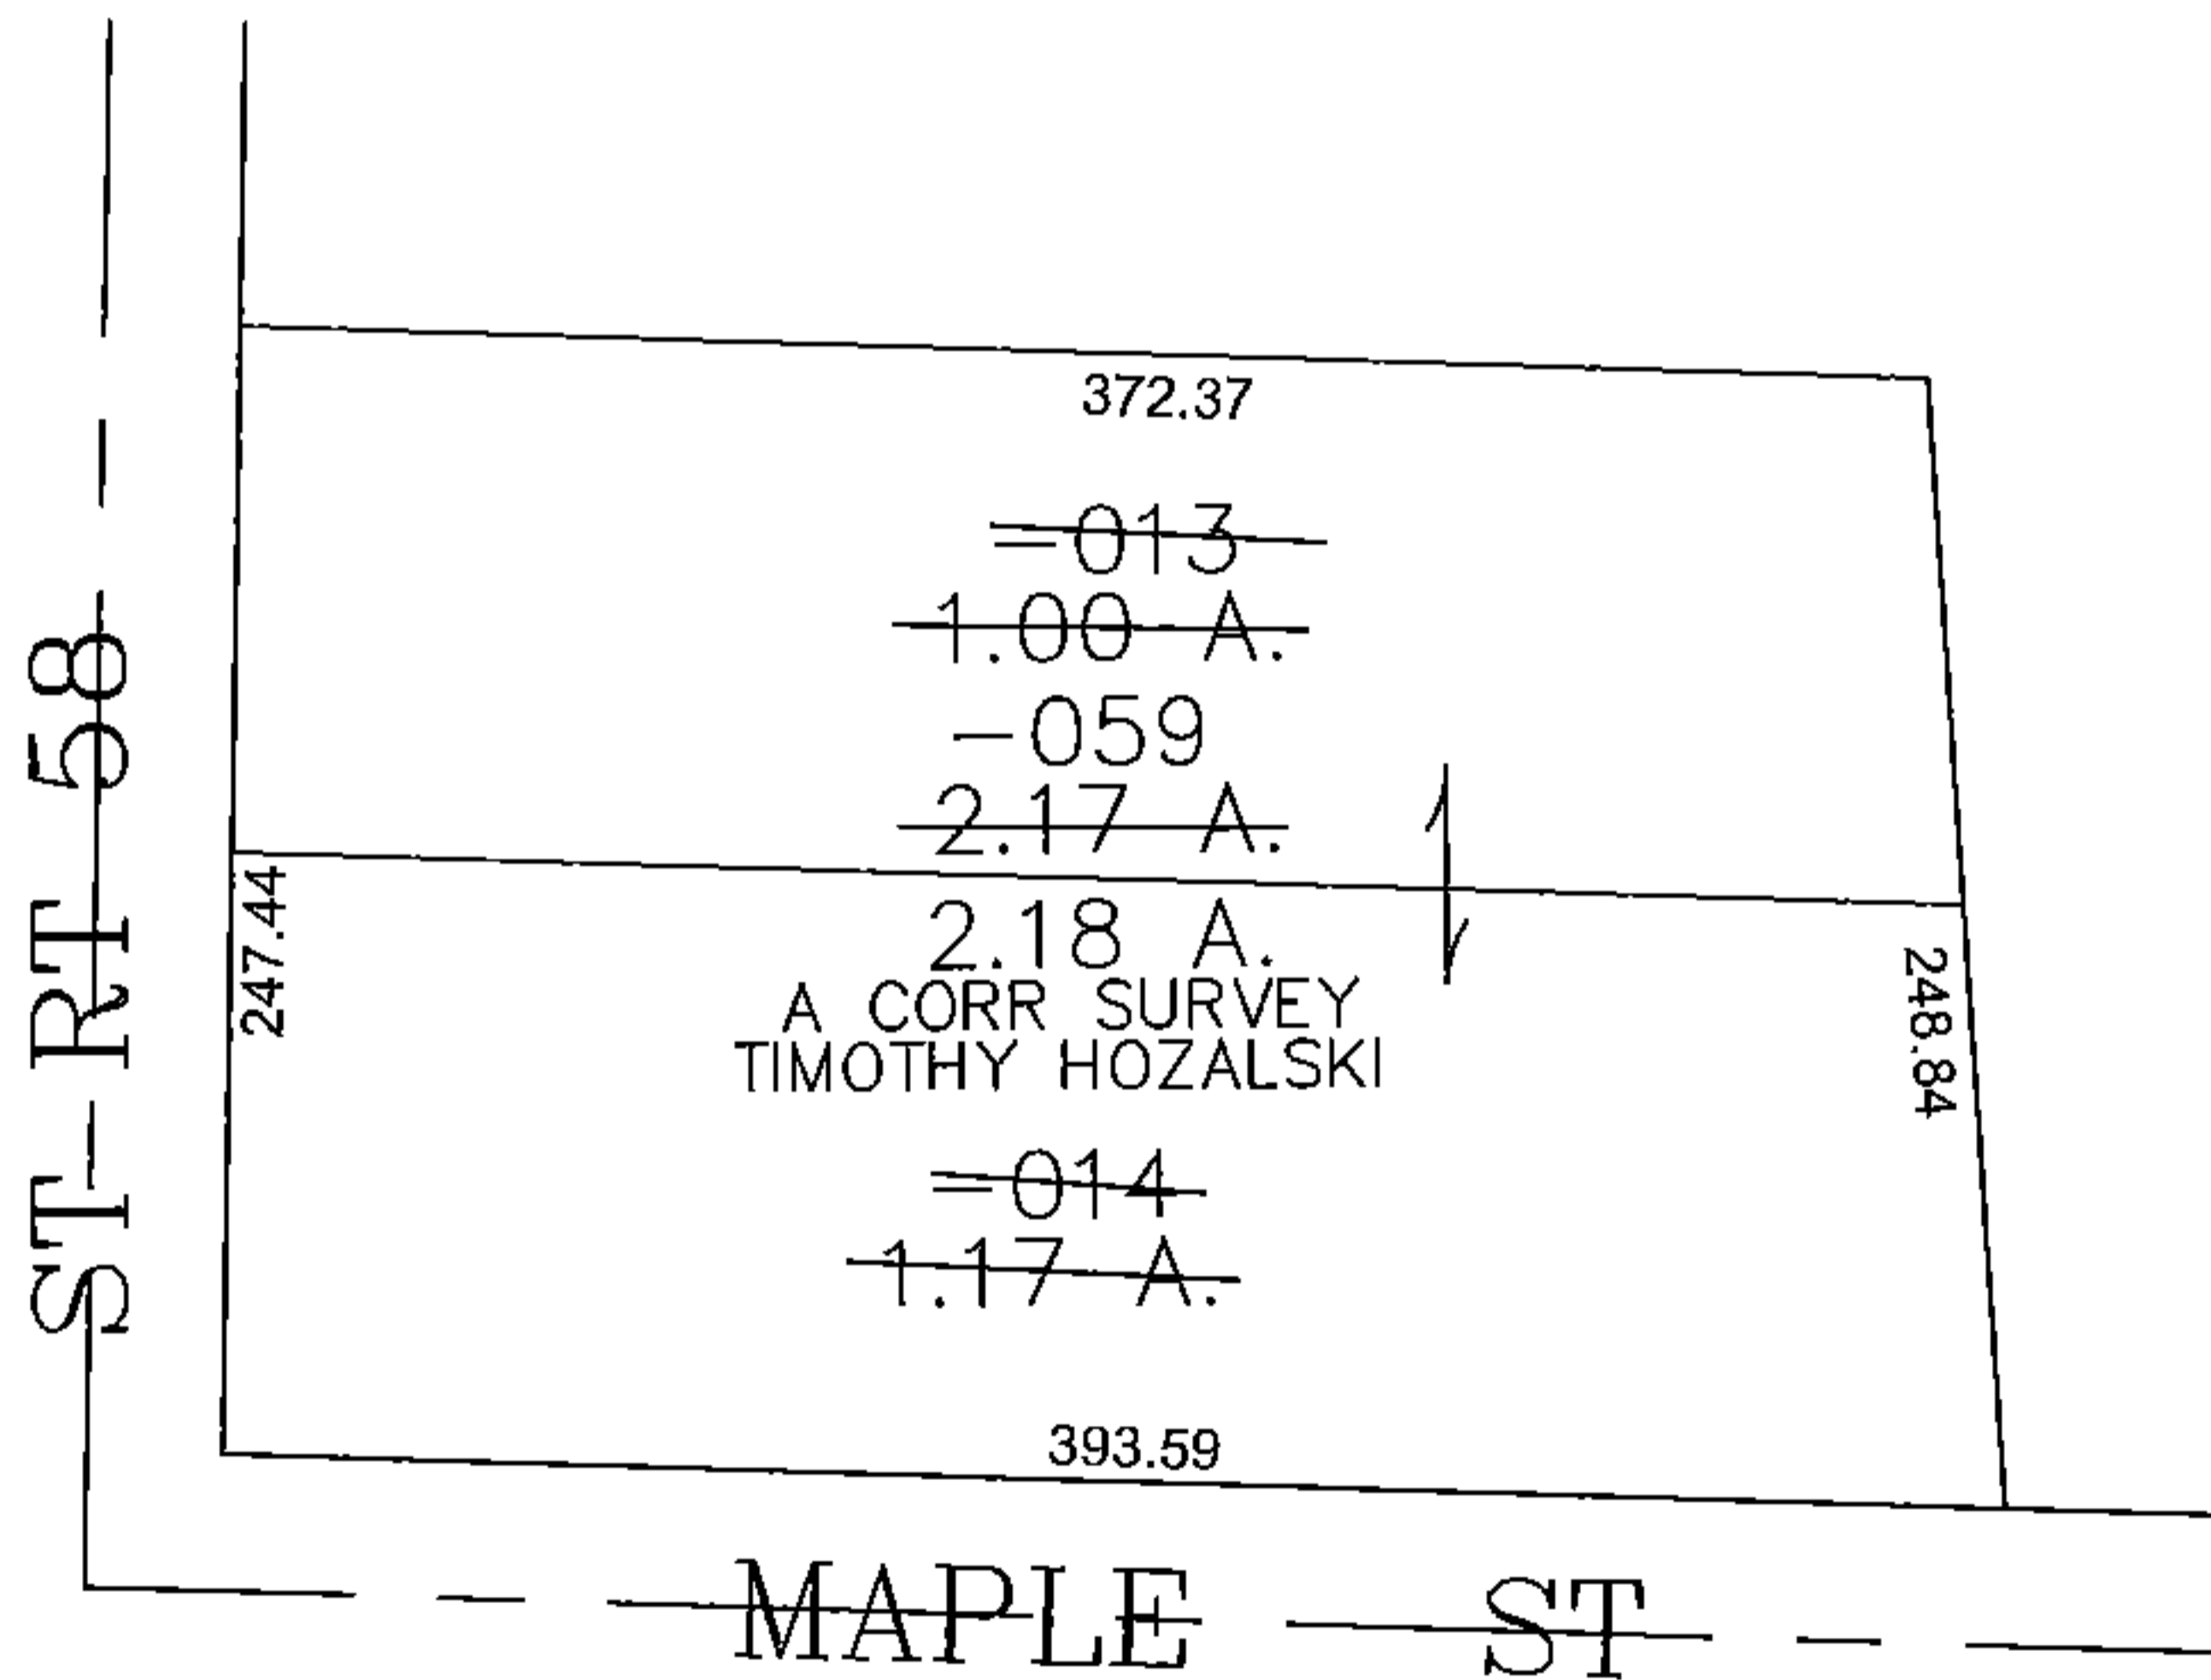


PARENT PARCEL: 09-00-066-000-013, -014

CHILD PARCEL: 09-00-066-000-059

STARTING POINT: SIDELINE OF ST RT 58 & MAPLE ST

15-03433

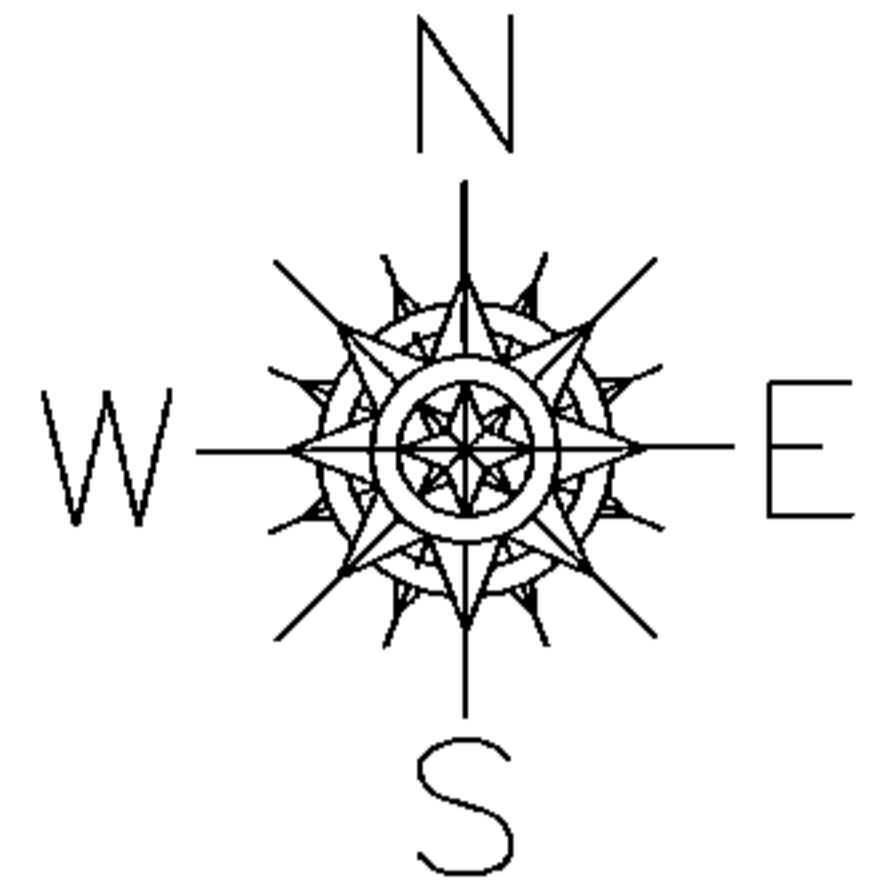

SPLITS/DEEDS PROCESSED

LORAIN COUNTY TAX MAP DEPARTMENT
226 MIDDLE AVE. ELYRIA, OHIO

SURVEYED BY: TIMOTHY HOZALSKI

CLOSURE: 0.00 : 10,000

MAP PAGE(S): 09-00-066

APPROVED BY: JAH DATE: 10-15-2015

SCALE: 1" = 100' PRIOR INSTRUMENT: 20150549818