
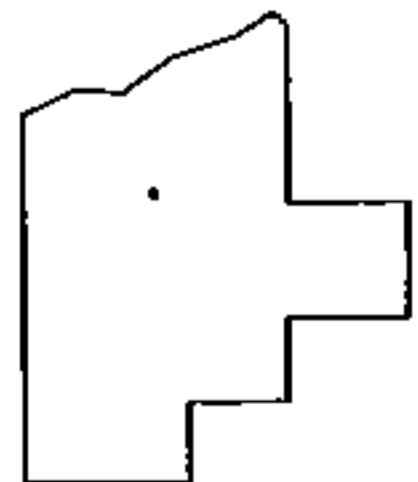
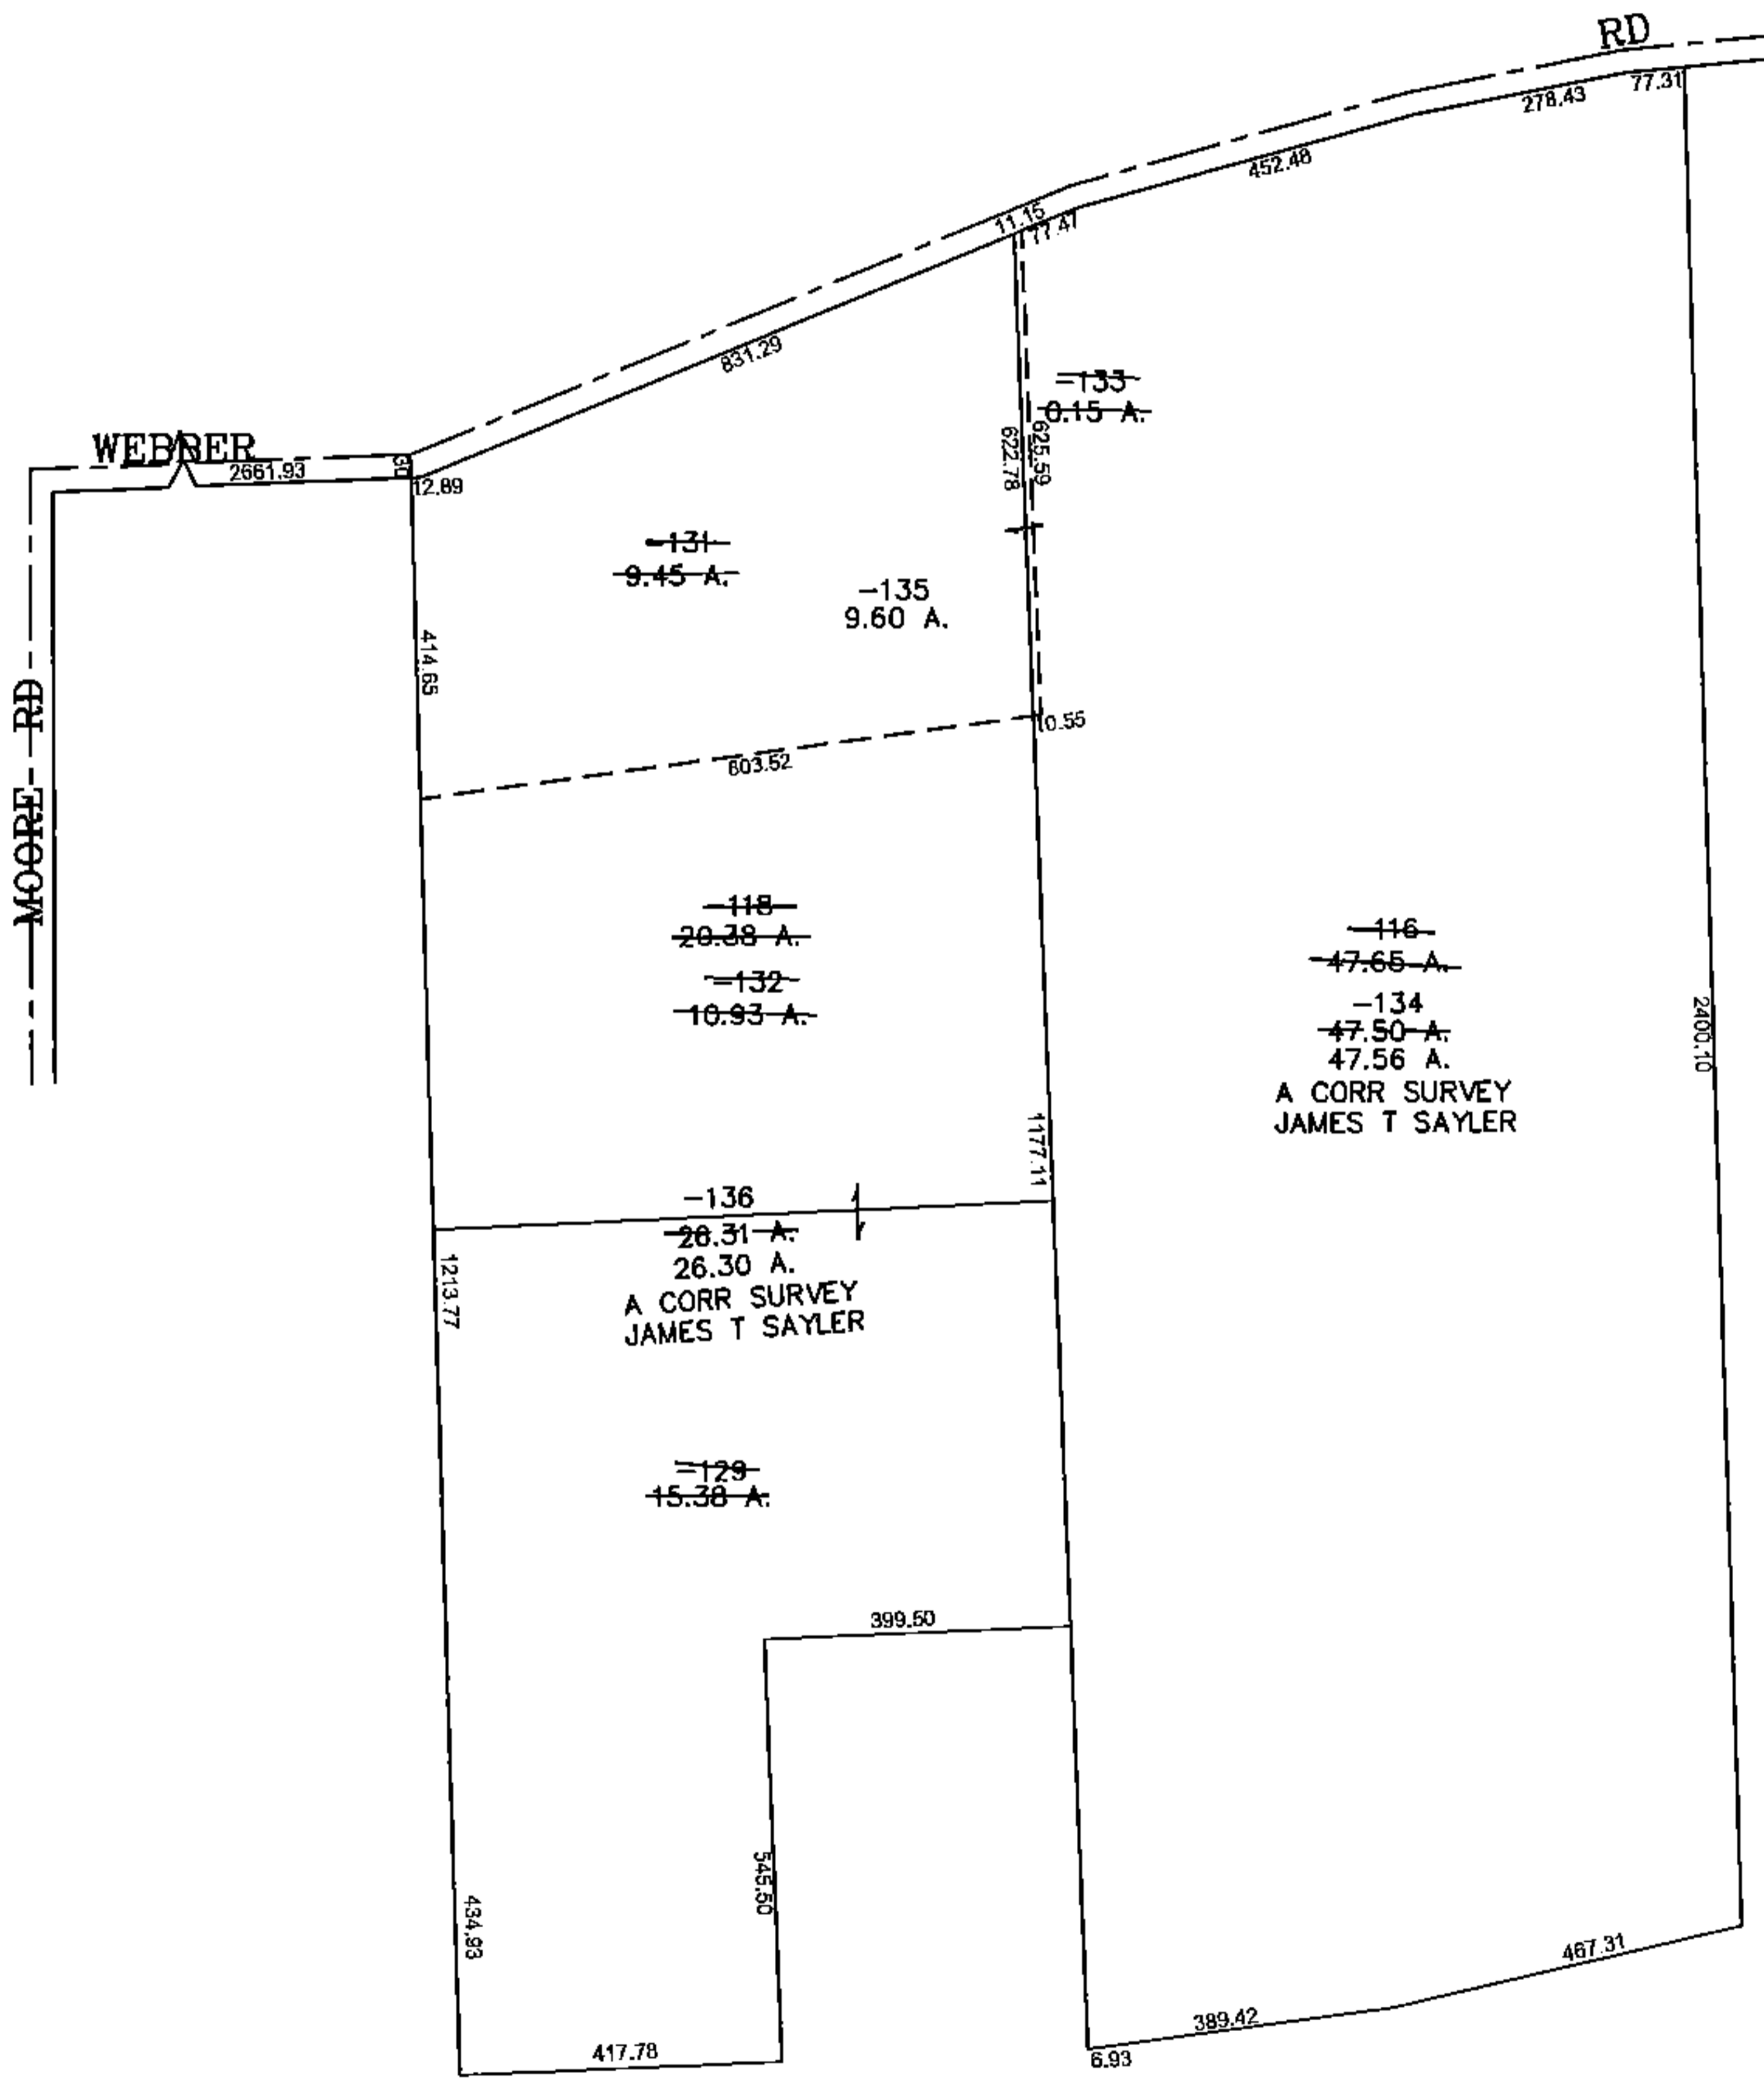


PARENT PARCEL: 04-00-008-104-118, -116, -129
 CHILD PARCEL: 04-00-008-104-131 THRU -136
 STARTING POINT: CENTERLINE OF MOORE RD & WEBBER RD

15-03434

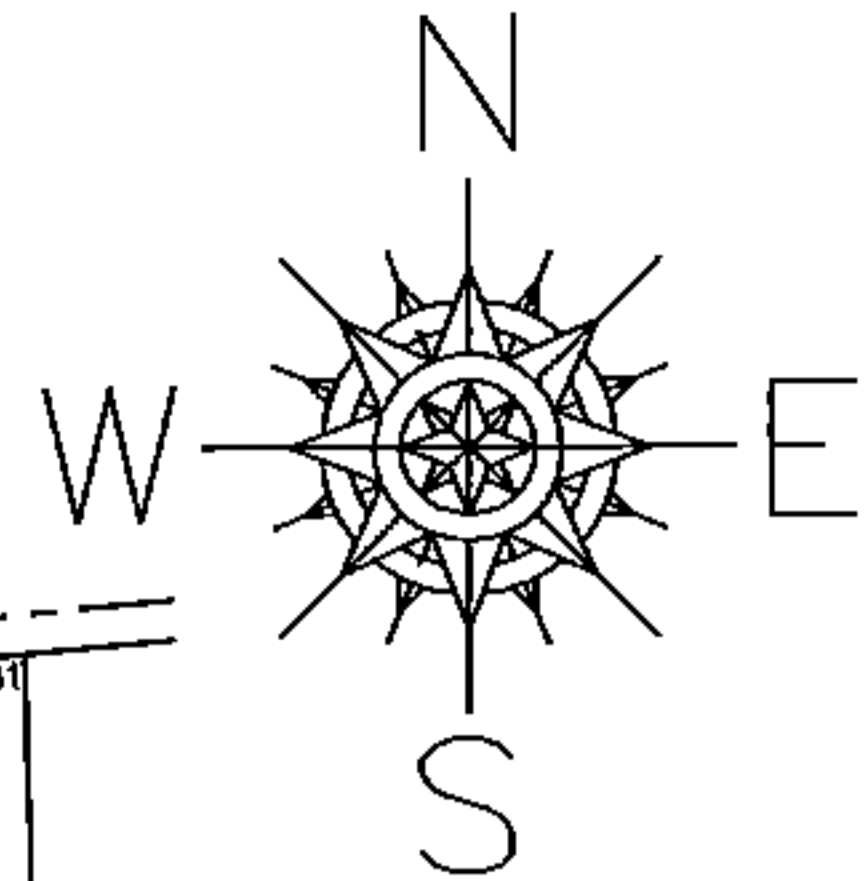

SPLITS/DEEDS PROCESSED
 LORAIN COUNTY TAX MAP DEPARTMENT
 226 MIDDLE AVE. ELYRIA, OHIO

SURVEYED BY: JAMES T SAYLER
 CLOSURE: 0.00 : 10,000
 MAP PAGE(S): 04-00-008-C,G
 APPROVED BY: JAH DATE: 10/19/2015
 SCALE: 1"= 400 PRIOR INST.: 20070207725