
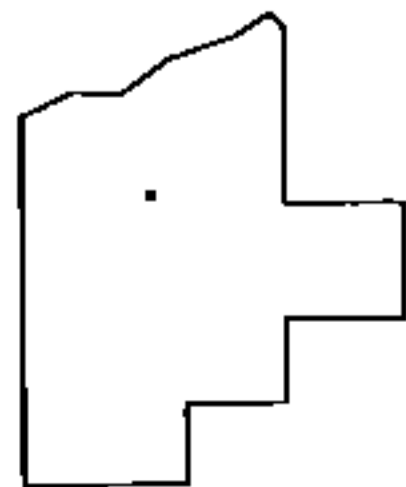
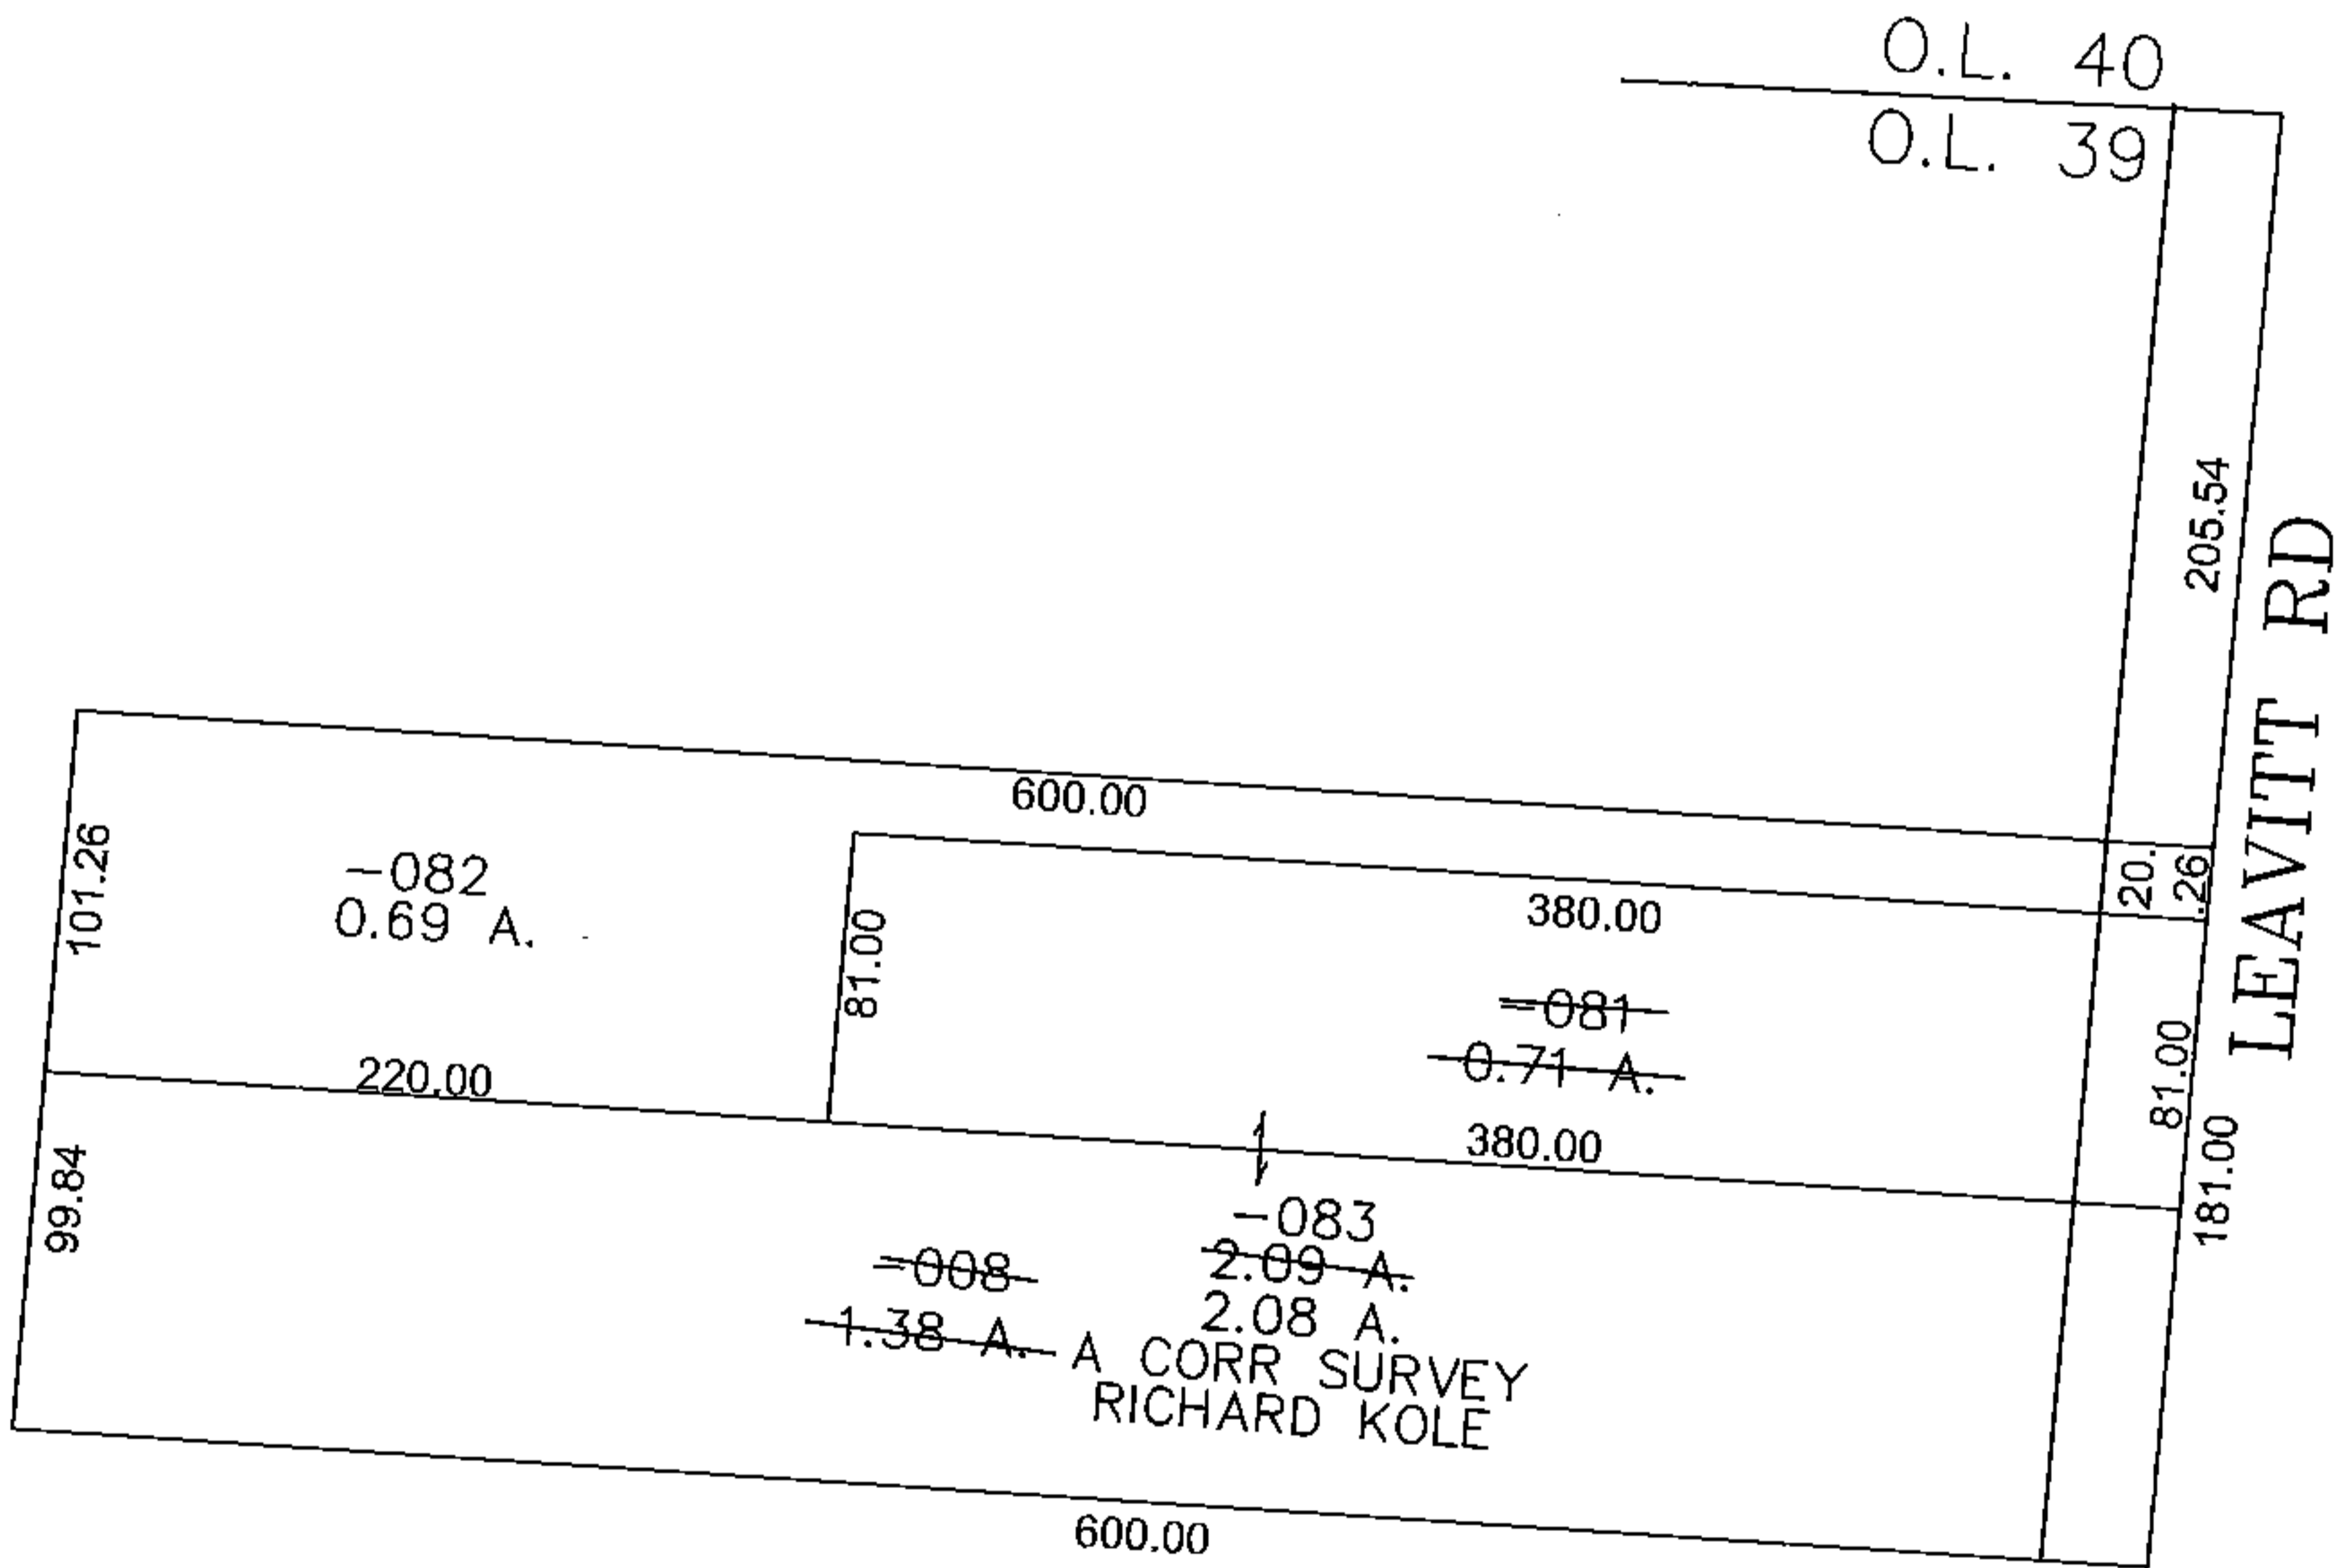


PARENT PARCEL: 05-00-039-108-008, -081
CHILD PARCEL: 05-00-039-108-083
STARTING POINT: CENTERLINE OF LEAVITT RD & O.L. 39

15-03435

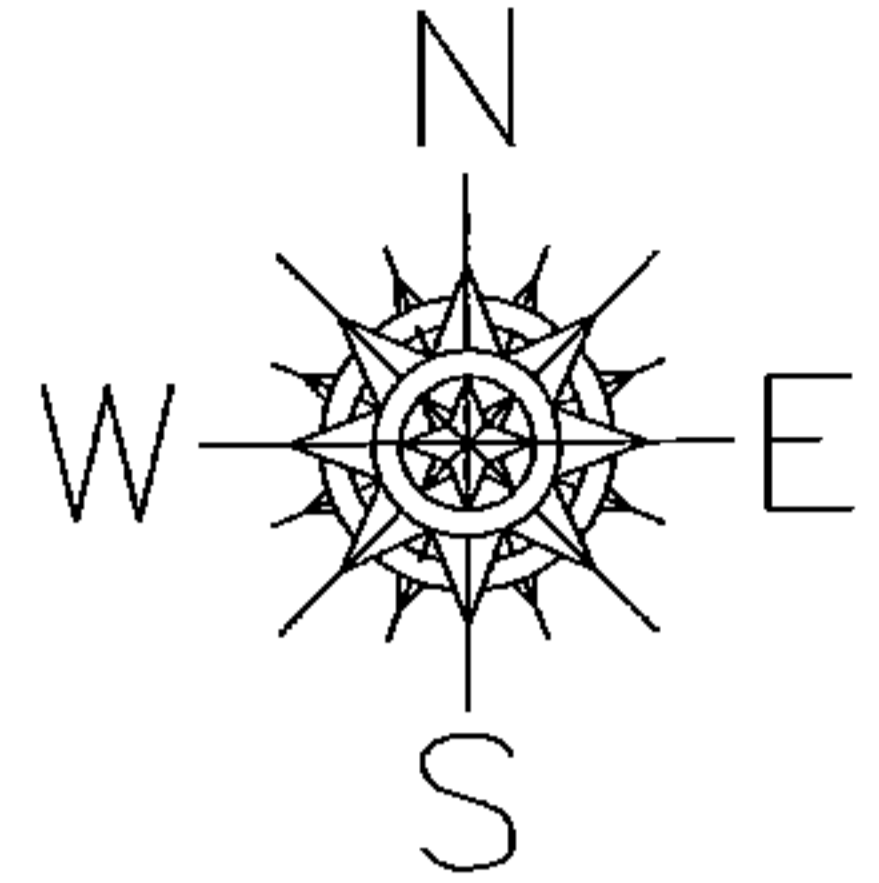

SPLITS/DEEDS PROCESSED
LORAIN COUNTY TAX MAP DEPARTMENT
226 MIDDLE AVE. ELYRIA, OHIO

SURVEYED BY: RICHARD KOLE
CLOSURE: 0.00 : 10,000
MAP PAGE(S): 05-00-039-B
APPROVED BY: JAH DATE: 10/28/2015
SCALE: 1" = 100 PRIOR INSTRUMENT: 20150554765