
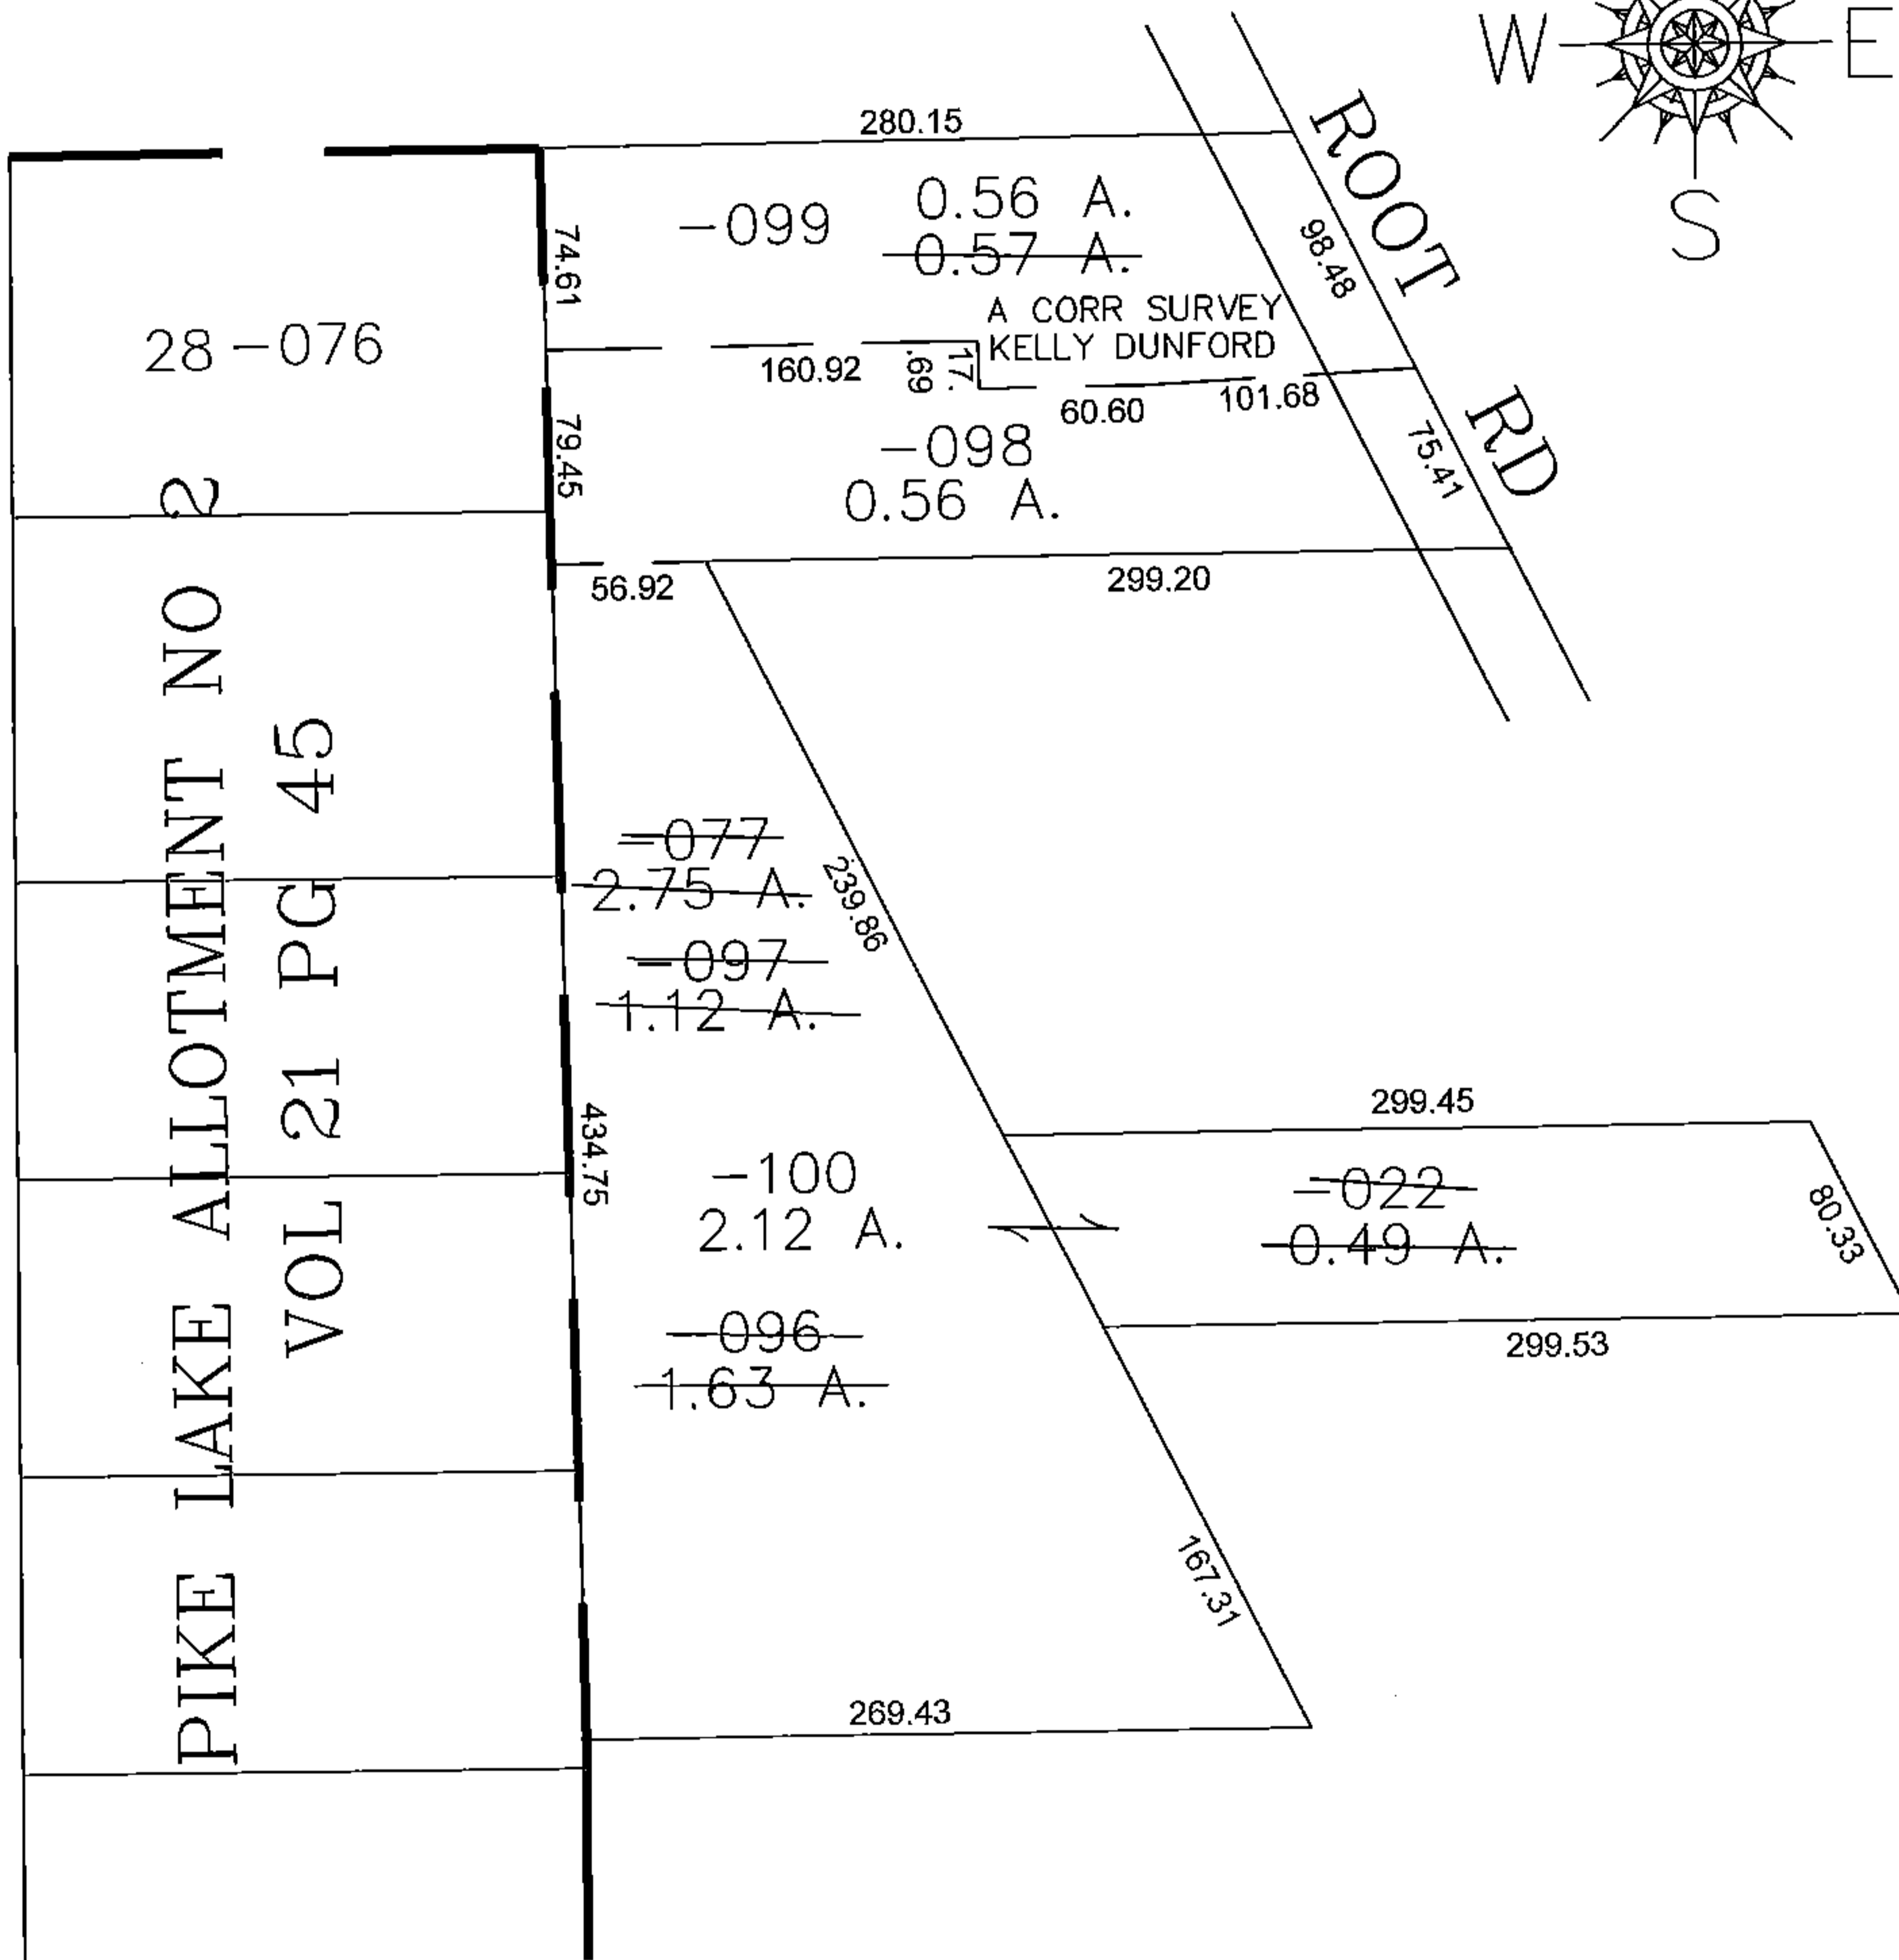


PARENT PARCEL: 07-00-022-101-077

CHILD PARCEL: 07-00-022-101-096 THRU -099

STARTING POINT: NORTHEAST CORNER OF S/L 28 IN PIKE LAKE ALLOT. NO 2

15-03441

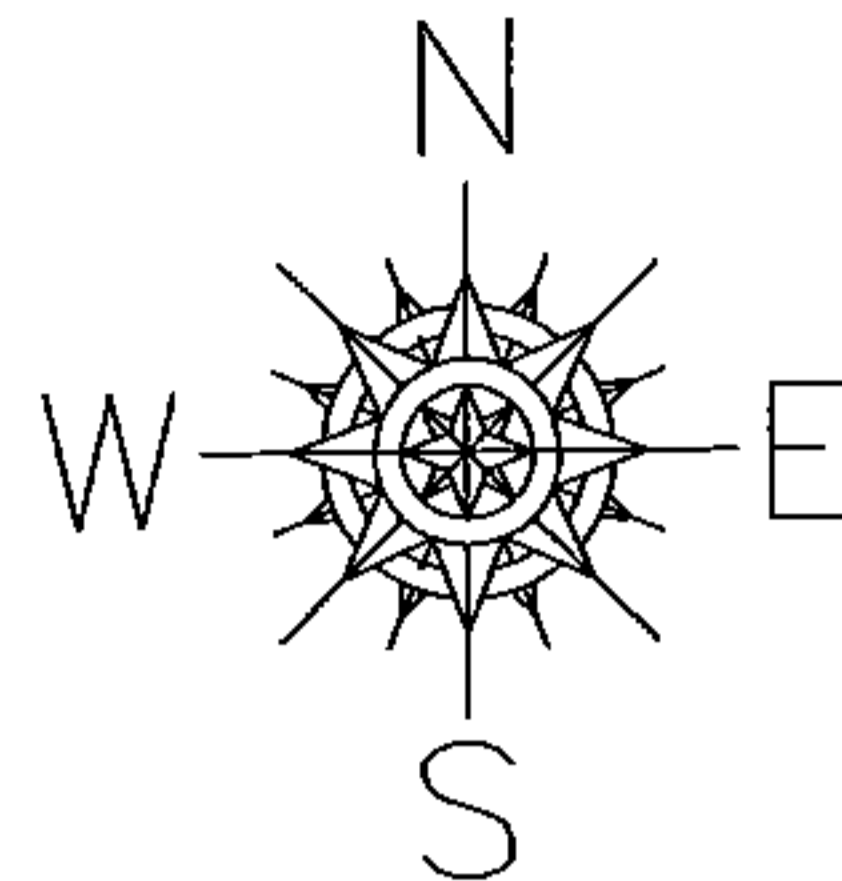

SPLITS/DEEDS PROCESSED

LORAIN COUNTY TAX MAP DEPARTMENT
226 MIDDLE AVE. ELYRIA, OHIO

SURVEYED BY: KELLY DUNFORD

CLOSURE: 0.00 : 10.000

MAP PAGE(S): 07-00-022

APPROVED BY: JAH DATE: 11/16/2015

SCALE: 1" = 100 PRIOR INSTRUMENT: 20130480220