
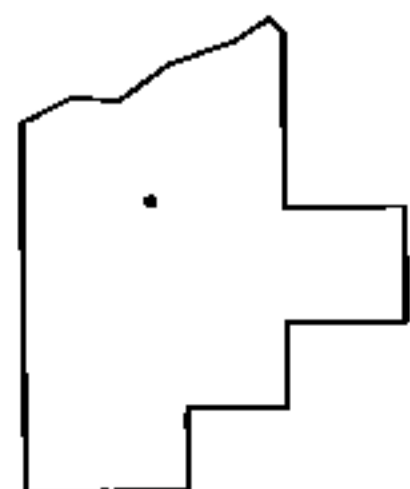
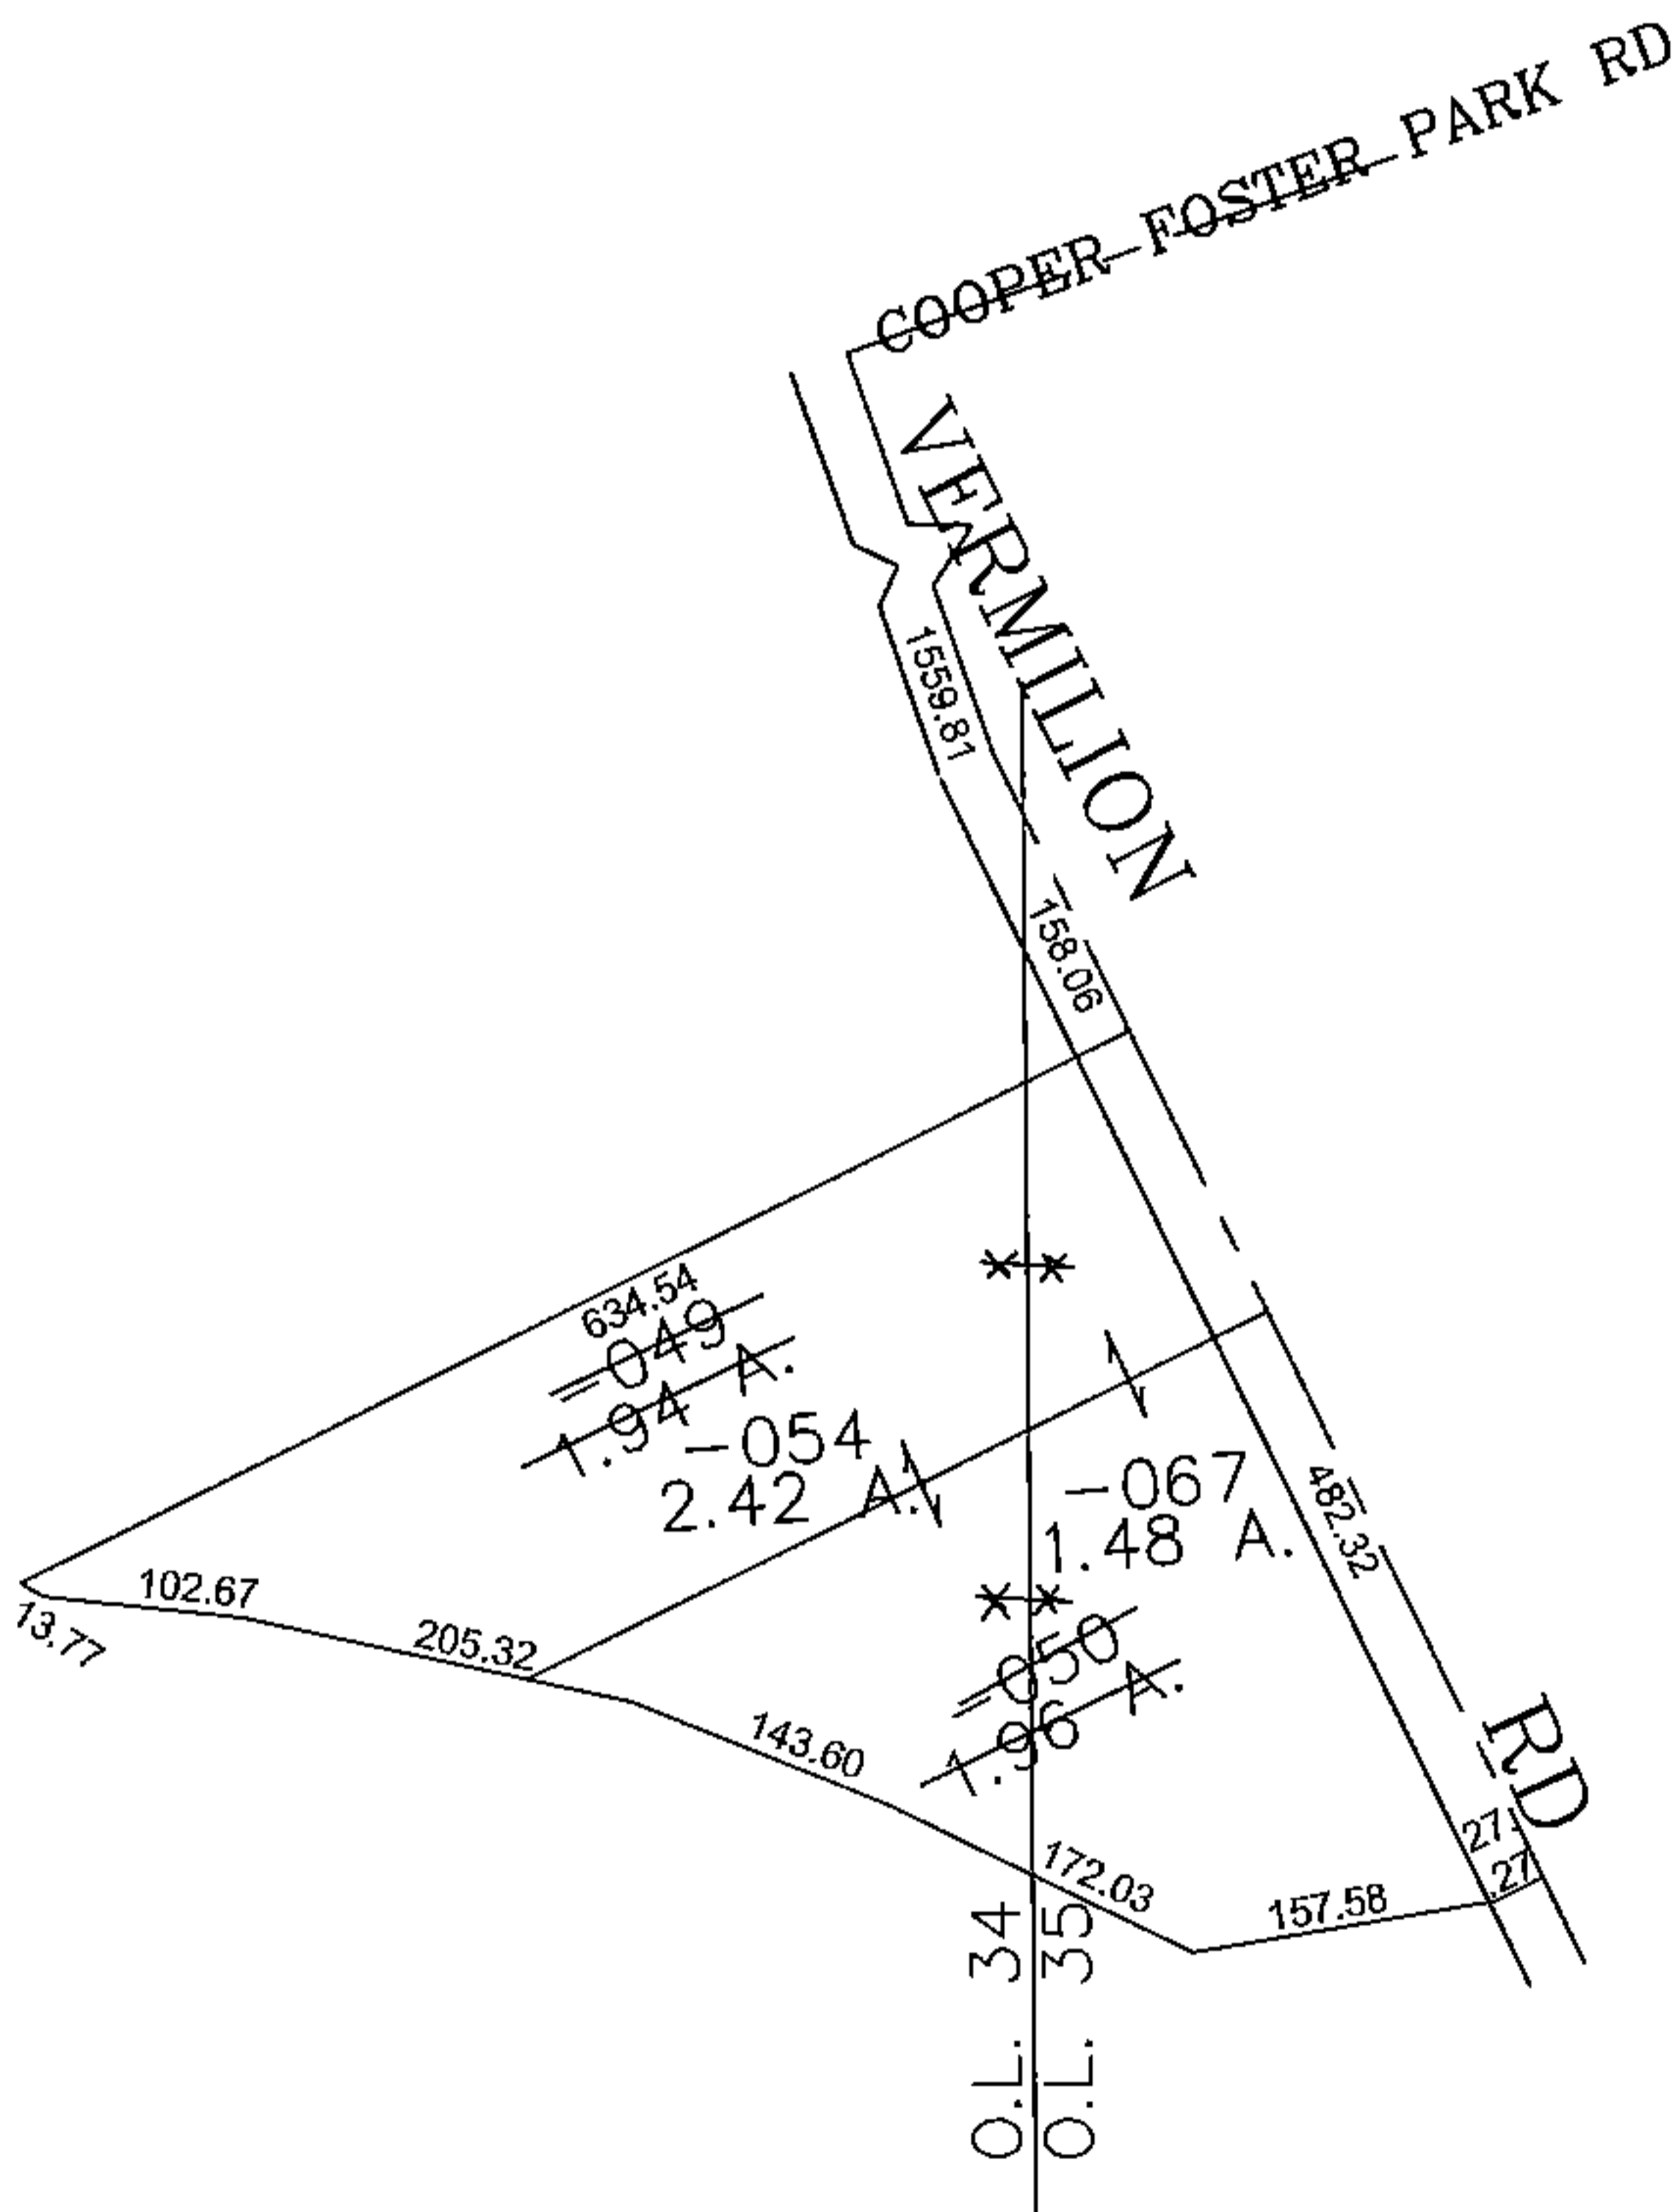


PARENT PARCEL: 01-00-034-000-049, 01-00-035-000-050

CHILD PARCEL: 01-00-034-000-054, 01-00-035-000-067

STARTING POINT: CENTERLINE OF VERMILION RD & COOPER FOSTER PARK RD

15-03442

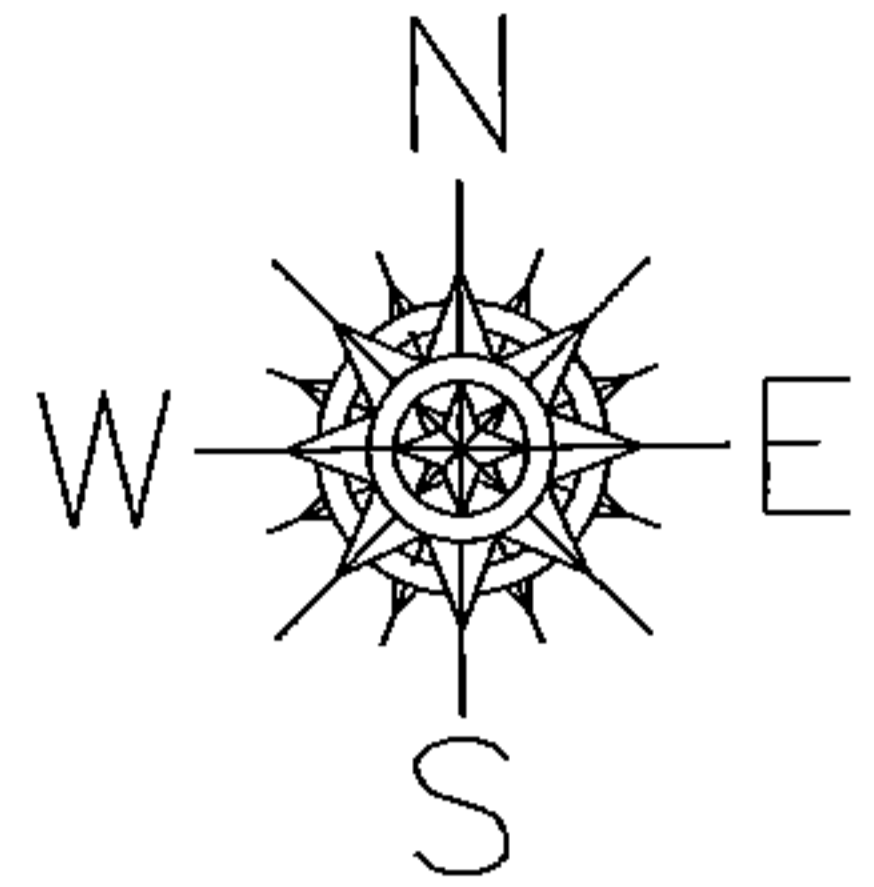

SPLITS/DEEDS PROCESSED
 LORAIN COUNTY TAX MAP DEPARTMENT
 226 MIDDLE AVE. ELYRIA, OHIO

SURVEYED BY: THOMAS SIMON
 CLOSURE: 0.00 : 10,000
 MAP PAGE(S): 01-00-034
 APPROVED BY: JAH DATE: 11/18/2015
 SCALE: 1" = 200' PRIOR INSTRUMENT: 20020804918