

PARENT PARCEL: 09-00-083-101-037



CHILD PARCEL: 09-00-083-101-037, -085

STARTING POINT: S/L 21 IN CLARKWOOD SUB.

16-03446-C

ADD TO DUPLICATE


09-00-083-101-085
5 X 98.60
IN THE NAME OF CLARK BROS INC
PER PLAT VOLUME 24 PG. 63
NEVER DEEDED OUT

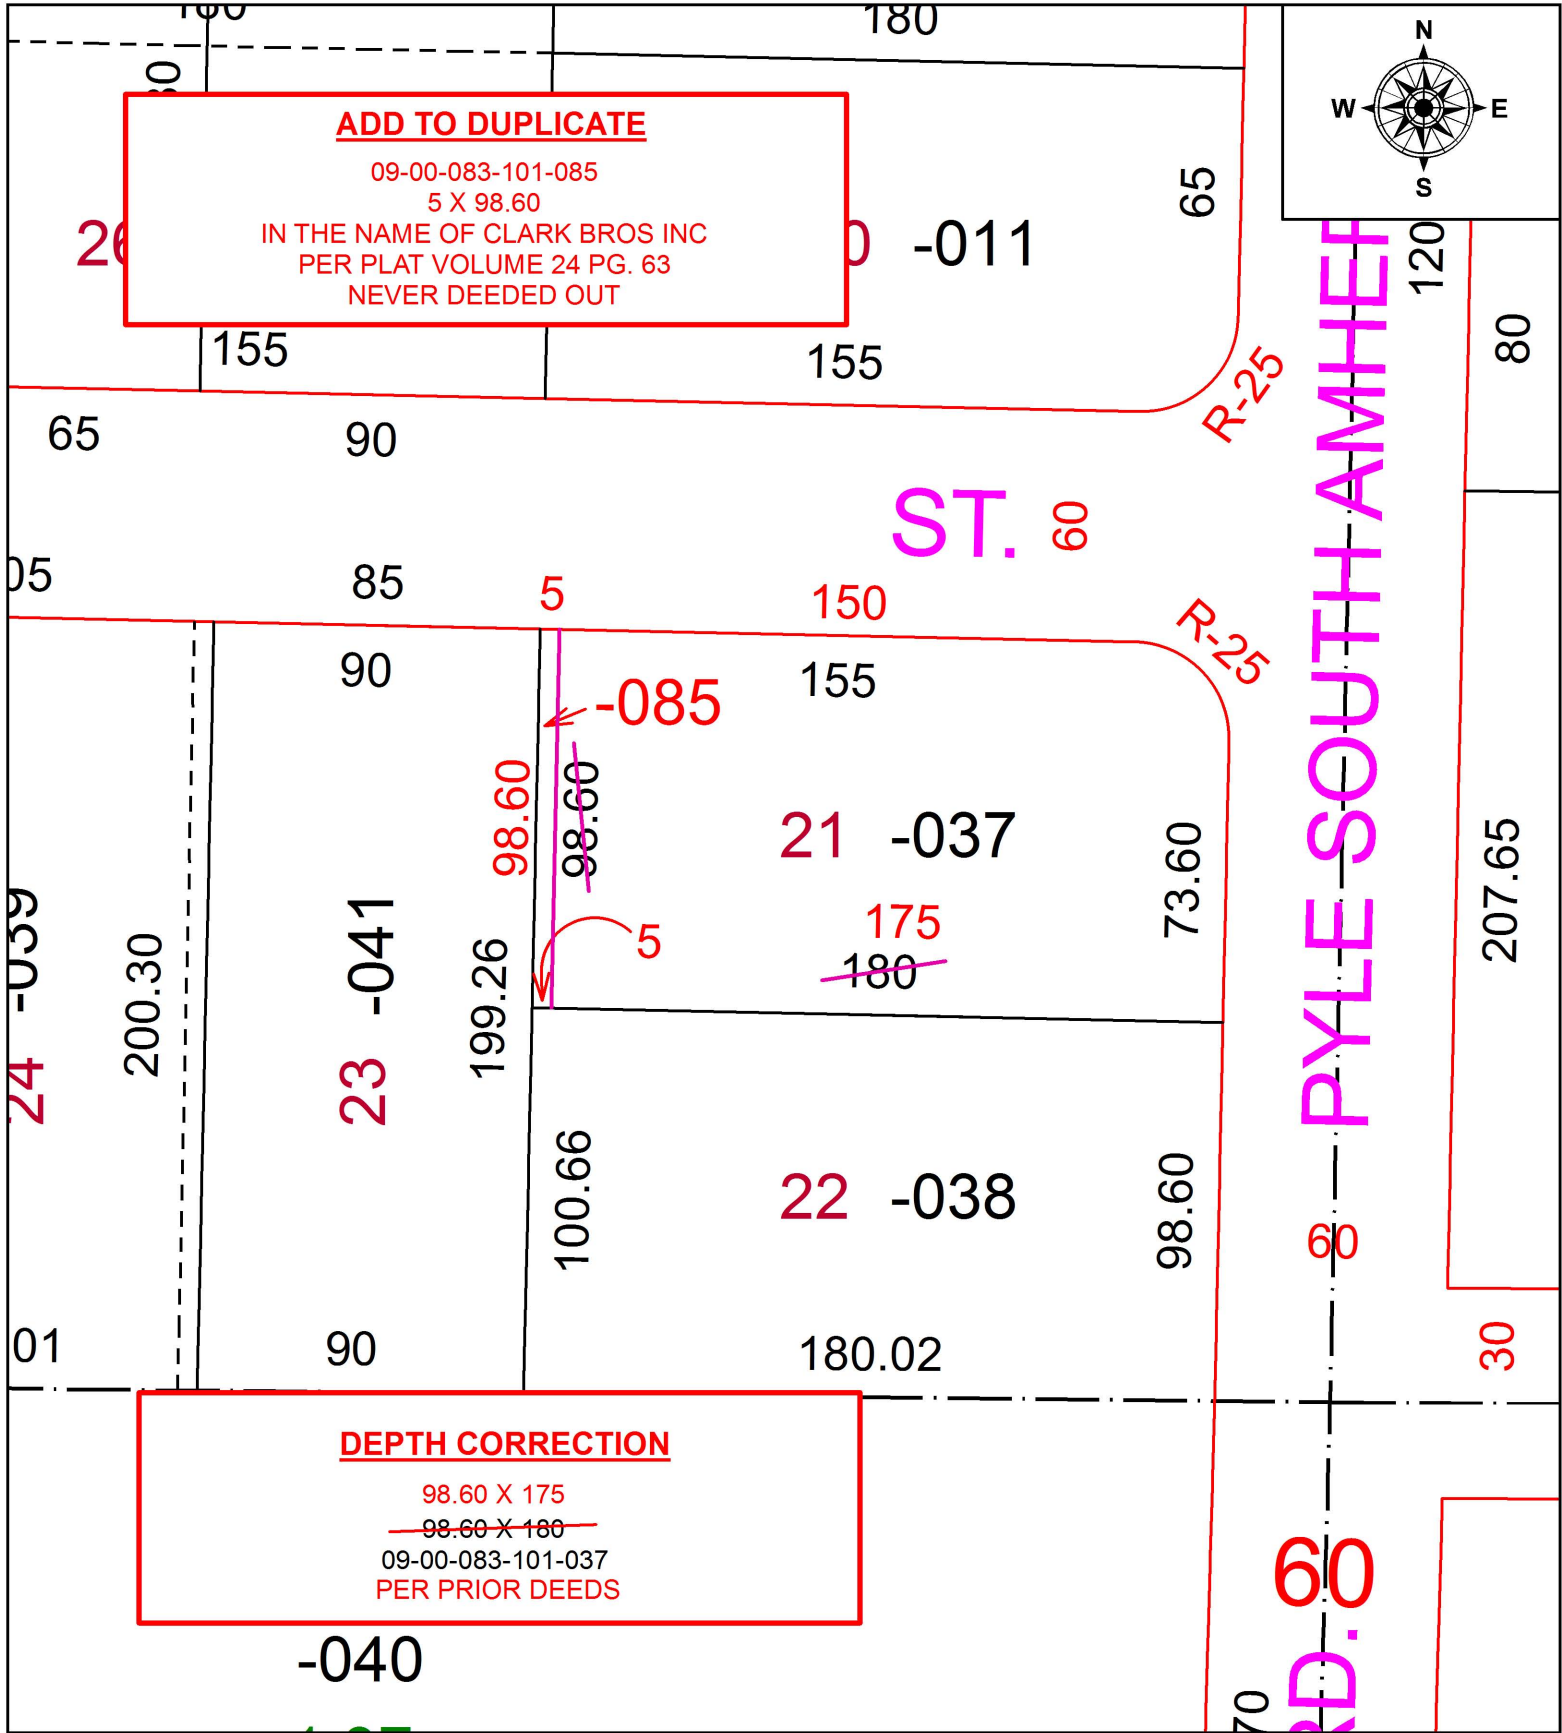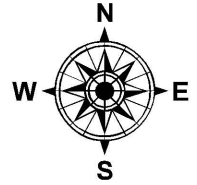

DEPTH CORRECTION

98.60 X 175
~~98.60 X 180~~
09-00-083-101-037
PER PRIOR DEEDS

-040

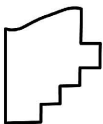

SPLITS/DEEDS PROCESSED
LORAIN COUNTY TAX MAP DEPARTMENT
226 MIDDLE AVE. ELYRIA, OH

SURVEYED BY: _____ N/A
CLOSURE: _____ N/A
MAP PAGE(S): 9-00-083-B
APPROVED BY: RRM DATE: 5-5-16
SCALE: 1" = 50' PRIOR INSTRUMENT: PV. 24 PG.63