
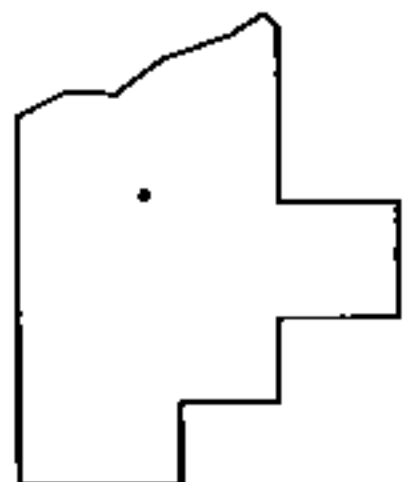
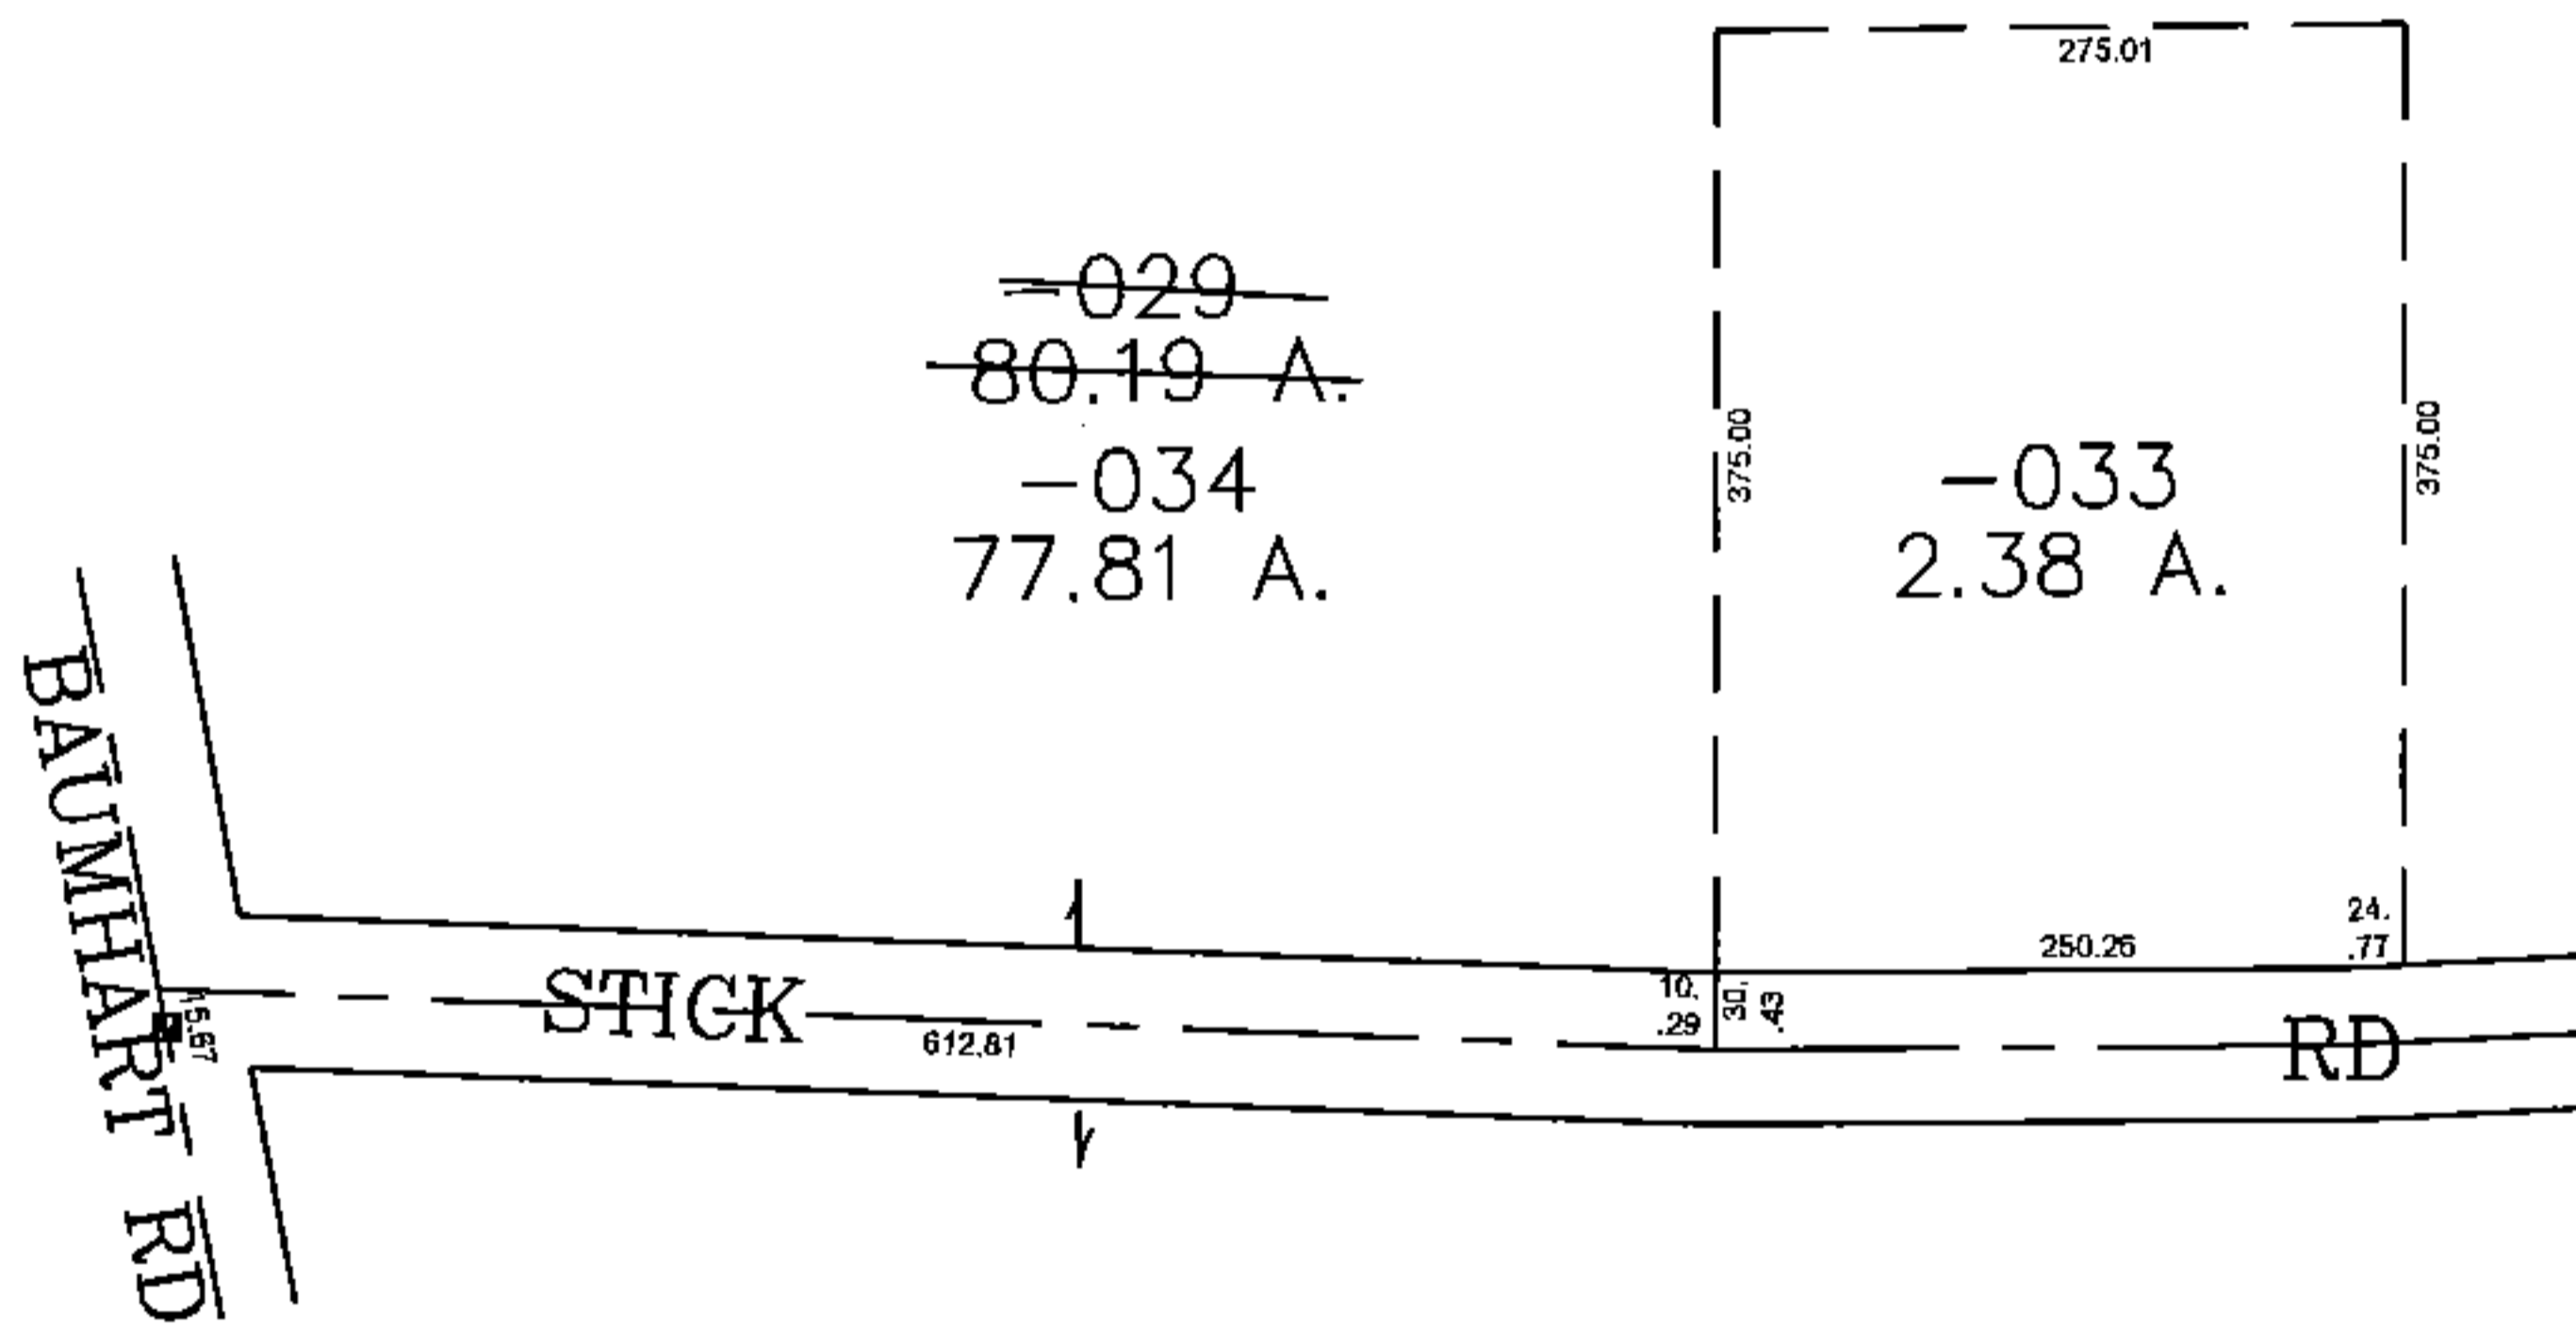


PARENT PARCEL: 01-00-074-000-029

CHILD PARCEL: 01-00-074-000-033, -034

STARTING POINT: CENTERLINE OF BAUMHART RD & STICK RD

15-03447

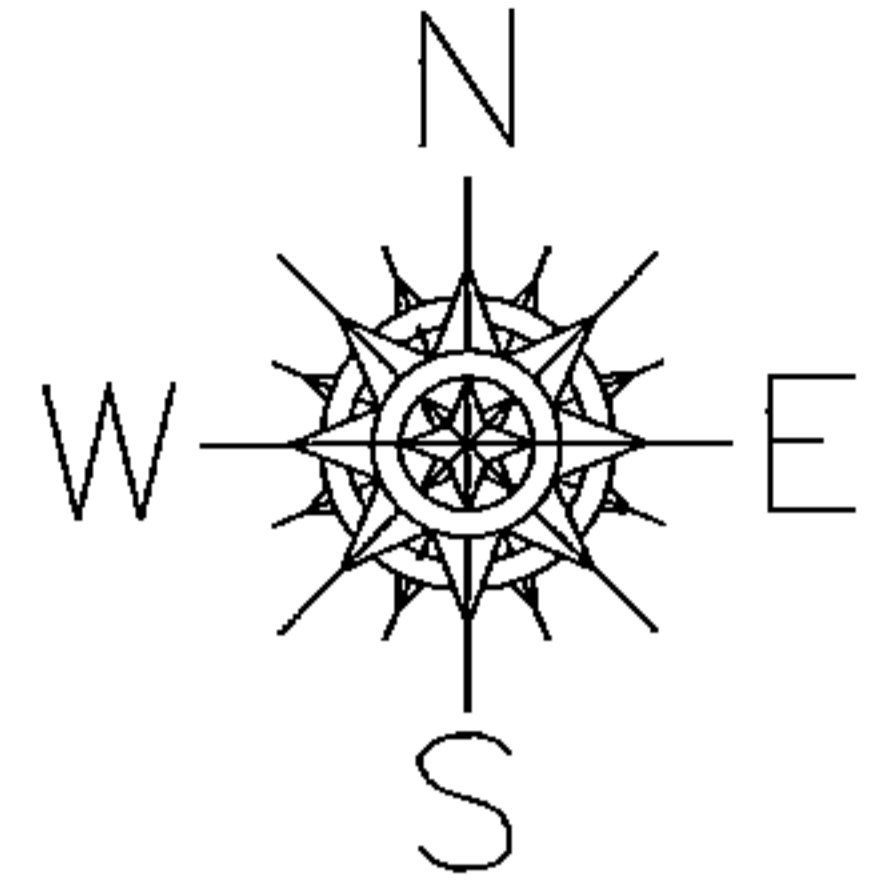

**SPLITS/DEEDS PROCESSED**  
 LORAIN COUNTY TAX MAP DEPARTMENT  
 226 MIDDLE AVE. ELYRIA, OHIO

SURVEYED BY: SEAN BOLLAND  
 CLOSURE: 0.00 : 10.000  
 MAP PAGE(S): 01-00-074-A  
 APPROVED BY: JAH DATE: 12/7/2015  
 SCALE: 1" = 200 PRIOR INSTRUMENT: 20020850031