


PARENT PARCEL: 04-00-016-101-002, -030, -048


CHILD PARCEL: 04-00-016-101-215

STARTING POINT: INTERSECTION OF C/L OF AVON BELDEN RD. AND C/L OF RAILROAD

16-03449-C

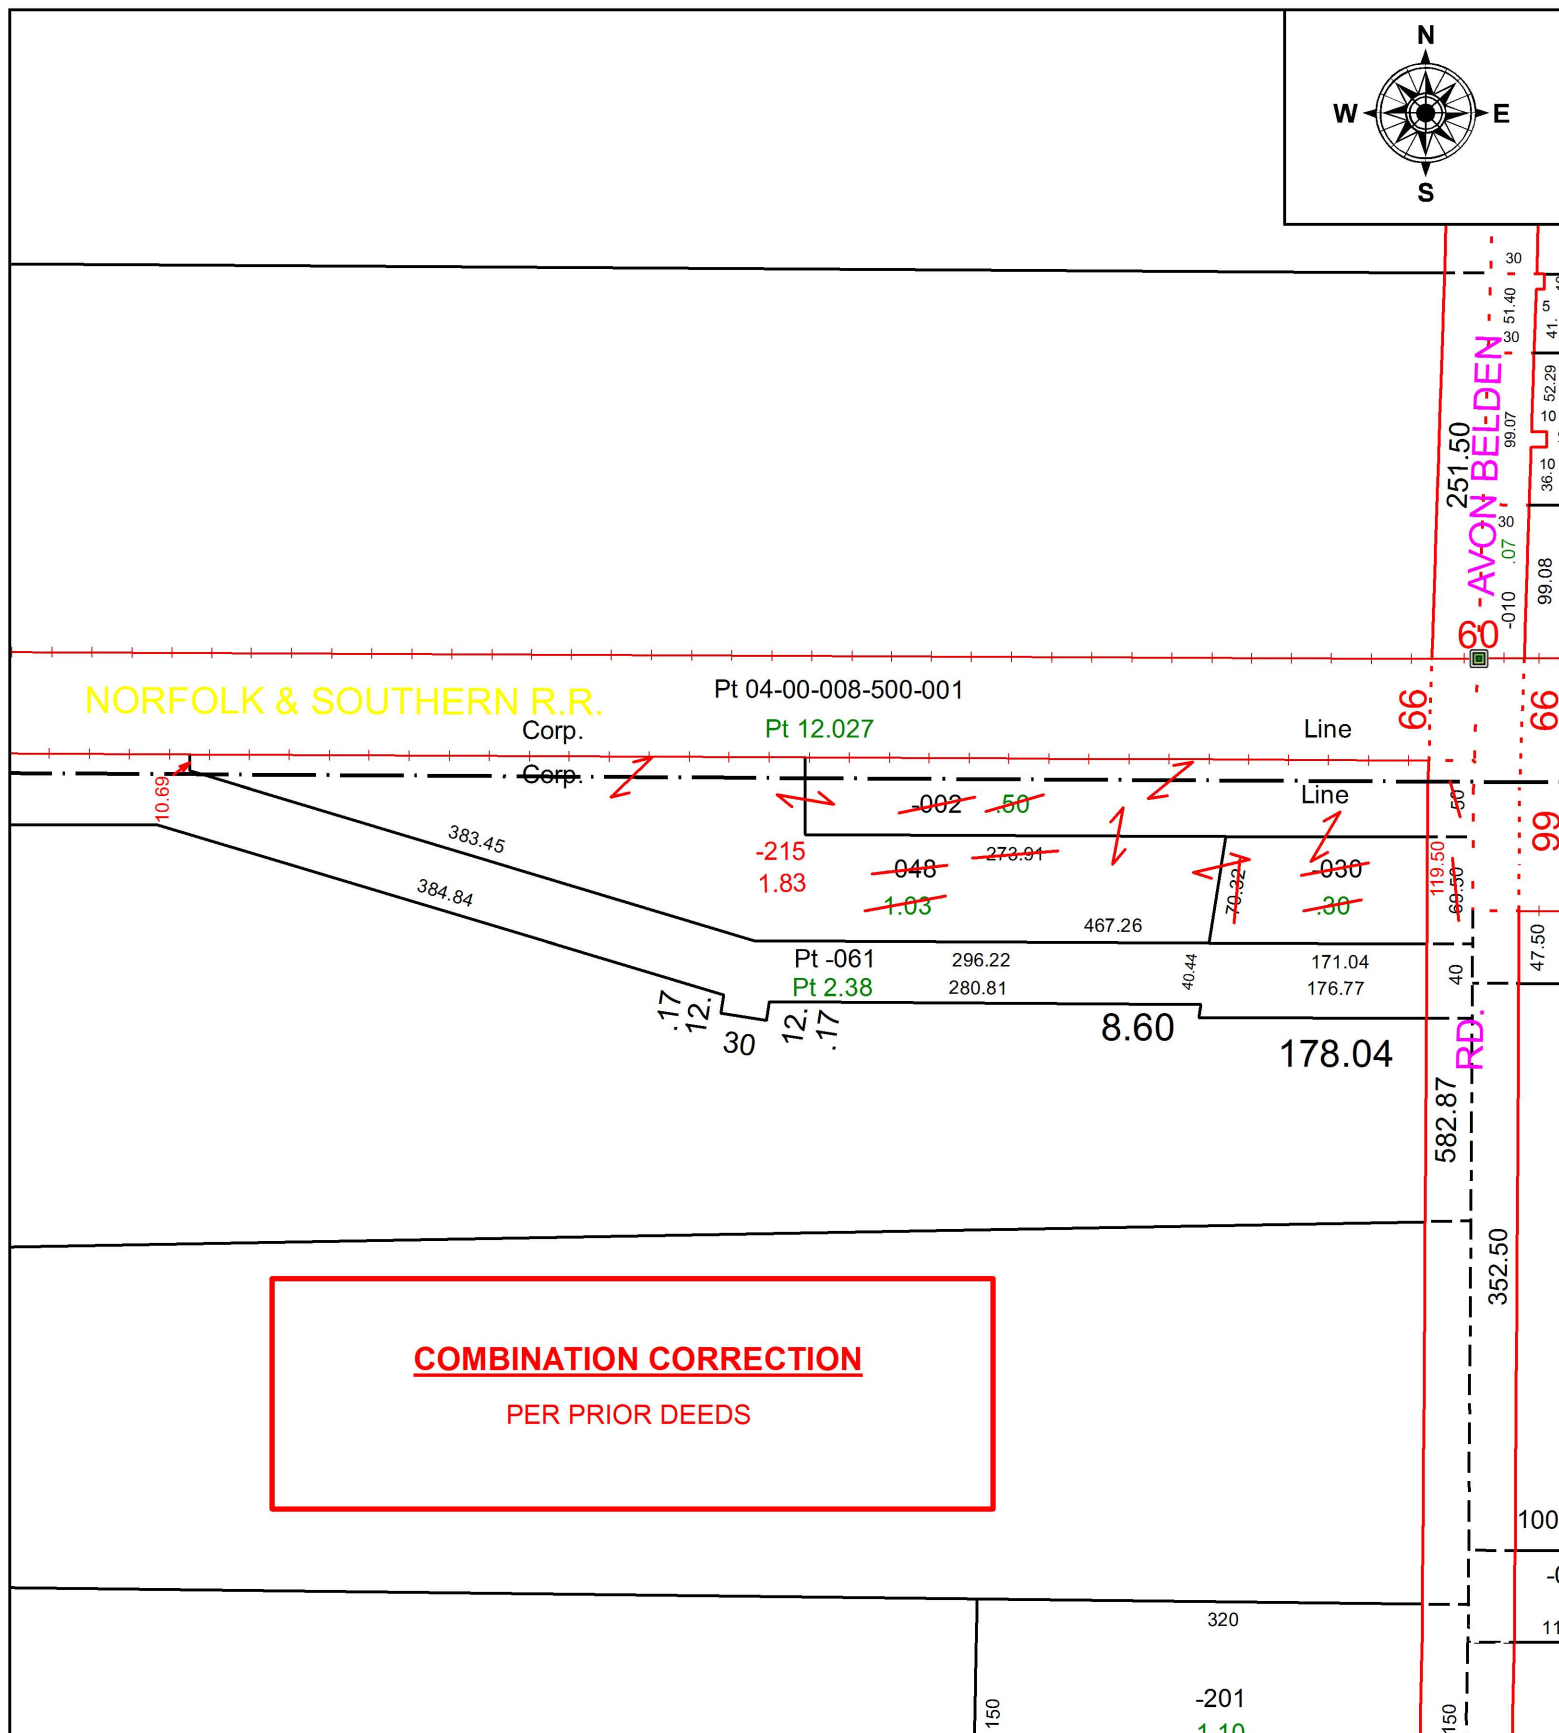

COMBINATION CORRECTION
PER PRIOR DEEDS

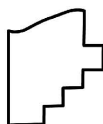

SPLITS/DEEDS PROCESSED
LORAIN COUNTY TAX MAP DEPARTMENT
226 MIDDLE AVE. ELYRIA, OH

SURVEYED BY: N/A
CLOSURE: N/A
MAP PAGE(S): 4-00-016-B
APPROVED BY: RRM DATE: 5-16-16
SCALE: 1" = 125 PRIORITY INSTRUMENT: 20150563609