


PARENT PARCEL: 07-00-016-112-044


CHILD PARCEL: XX-XX-XXX-XXX-XXX

STARTING POINT: SOUTHEAST CORNER OF S/L 184 IN WIL LOU ACRES SUB. NO 4

16-03451-D

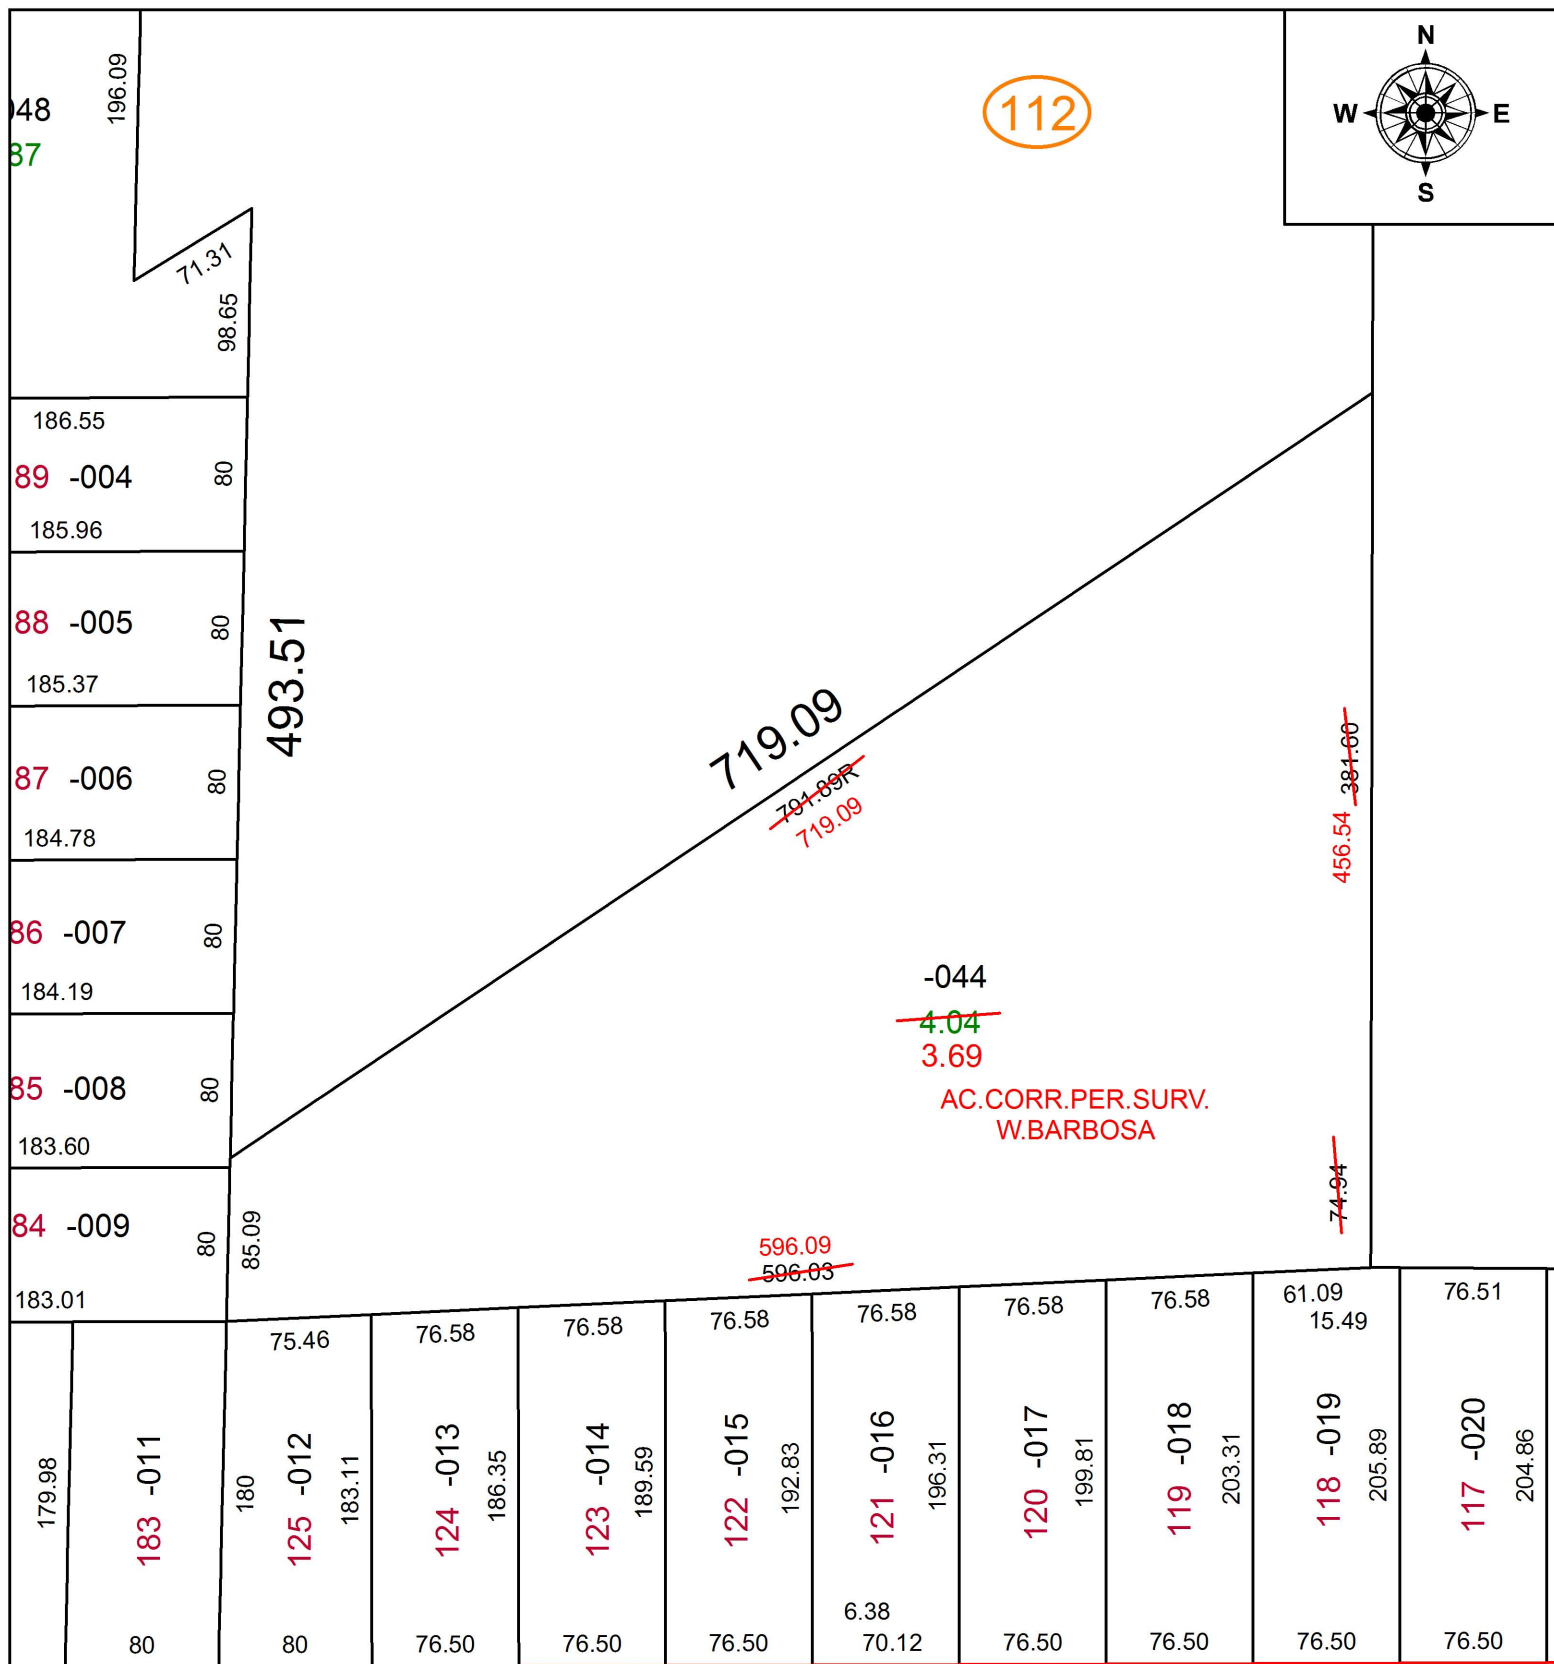

181.69  
NA

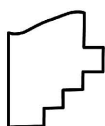

**SPLITS/DEEDS PROCESSED**  
LORAIN COUNTY TAX MAP DEPARTMENT  
226 MIDDLE AVE. ELYRIA, OH

SURVEYED BY: WILFREDO BARBOSA  
CLOSURE: 1: 1,192,364  
MAP PAGE(S): 7-00-016-B  
APPROVED BY: RRM DATE: 5-17-16  
SCALE: 1" = 100 PRIOR INSTRUMENT: 20130462488