


PARENT PARCEL: 14-00-080-000-013



CHILD PARCEL: 14-00-080-000-017, -018

STARTING POINT: CENTERLINE OF ST RT 303 & O.L. 80

15-03451

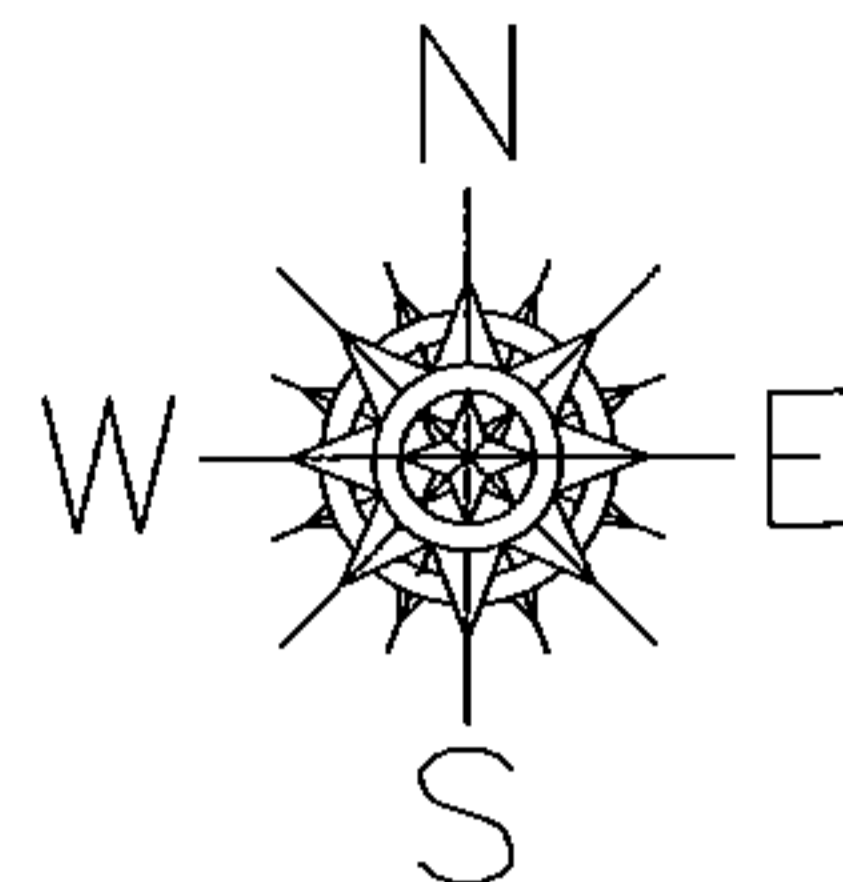

~~-013~~
~~42.87 A.~~
-018
40.22 A.

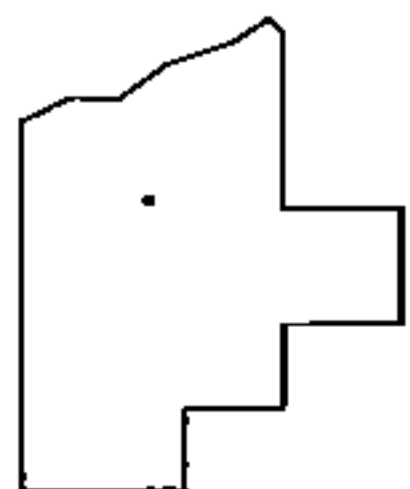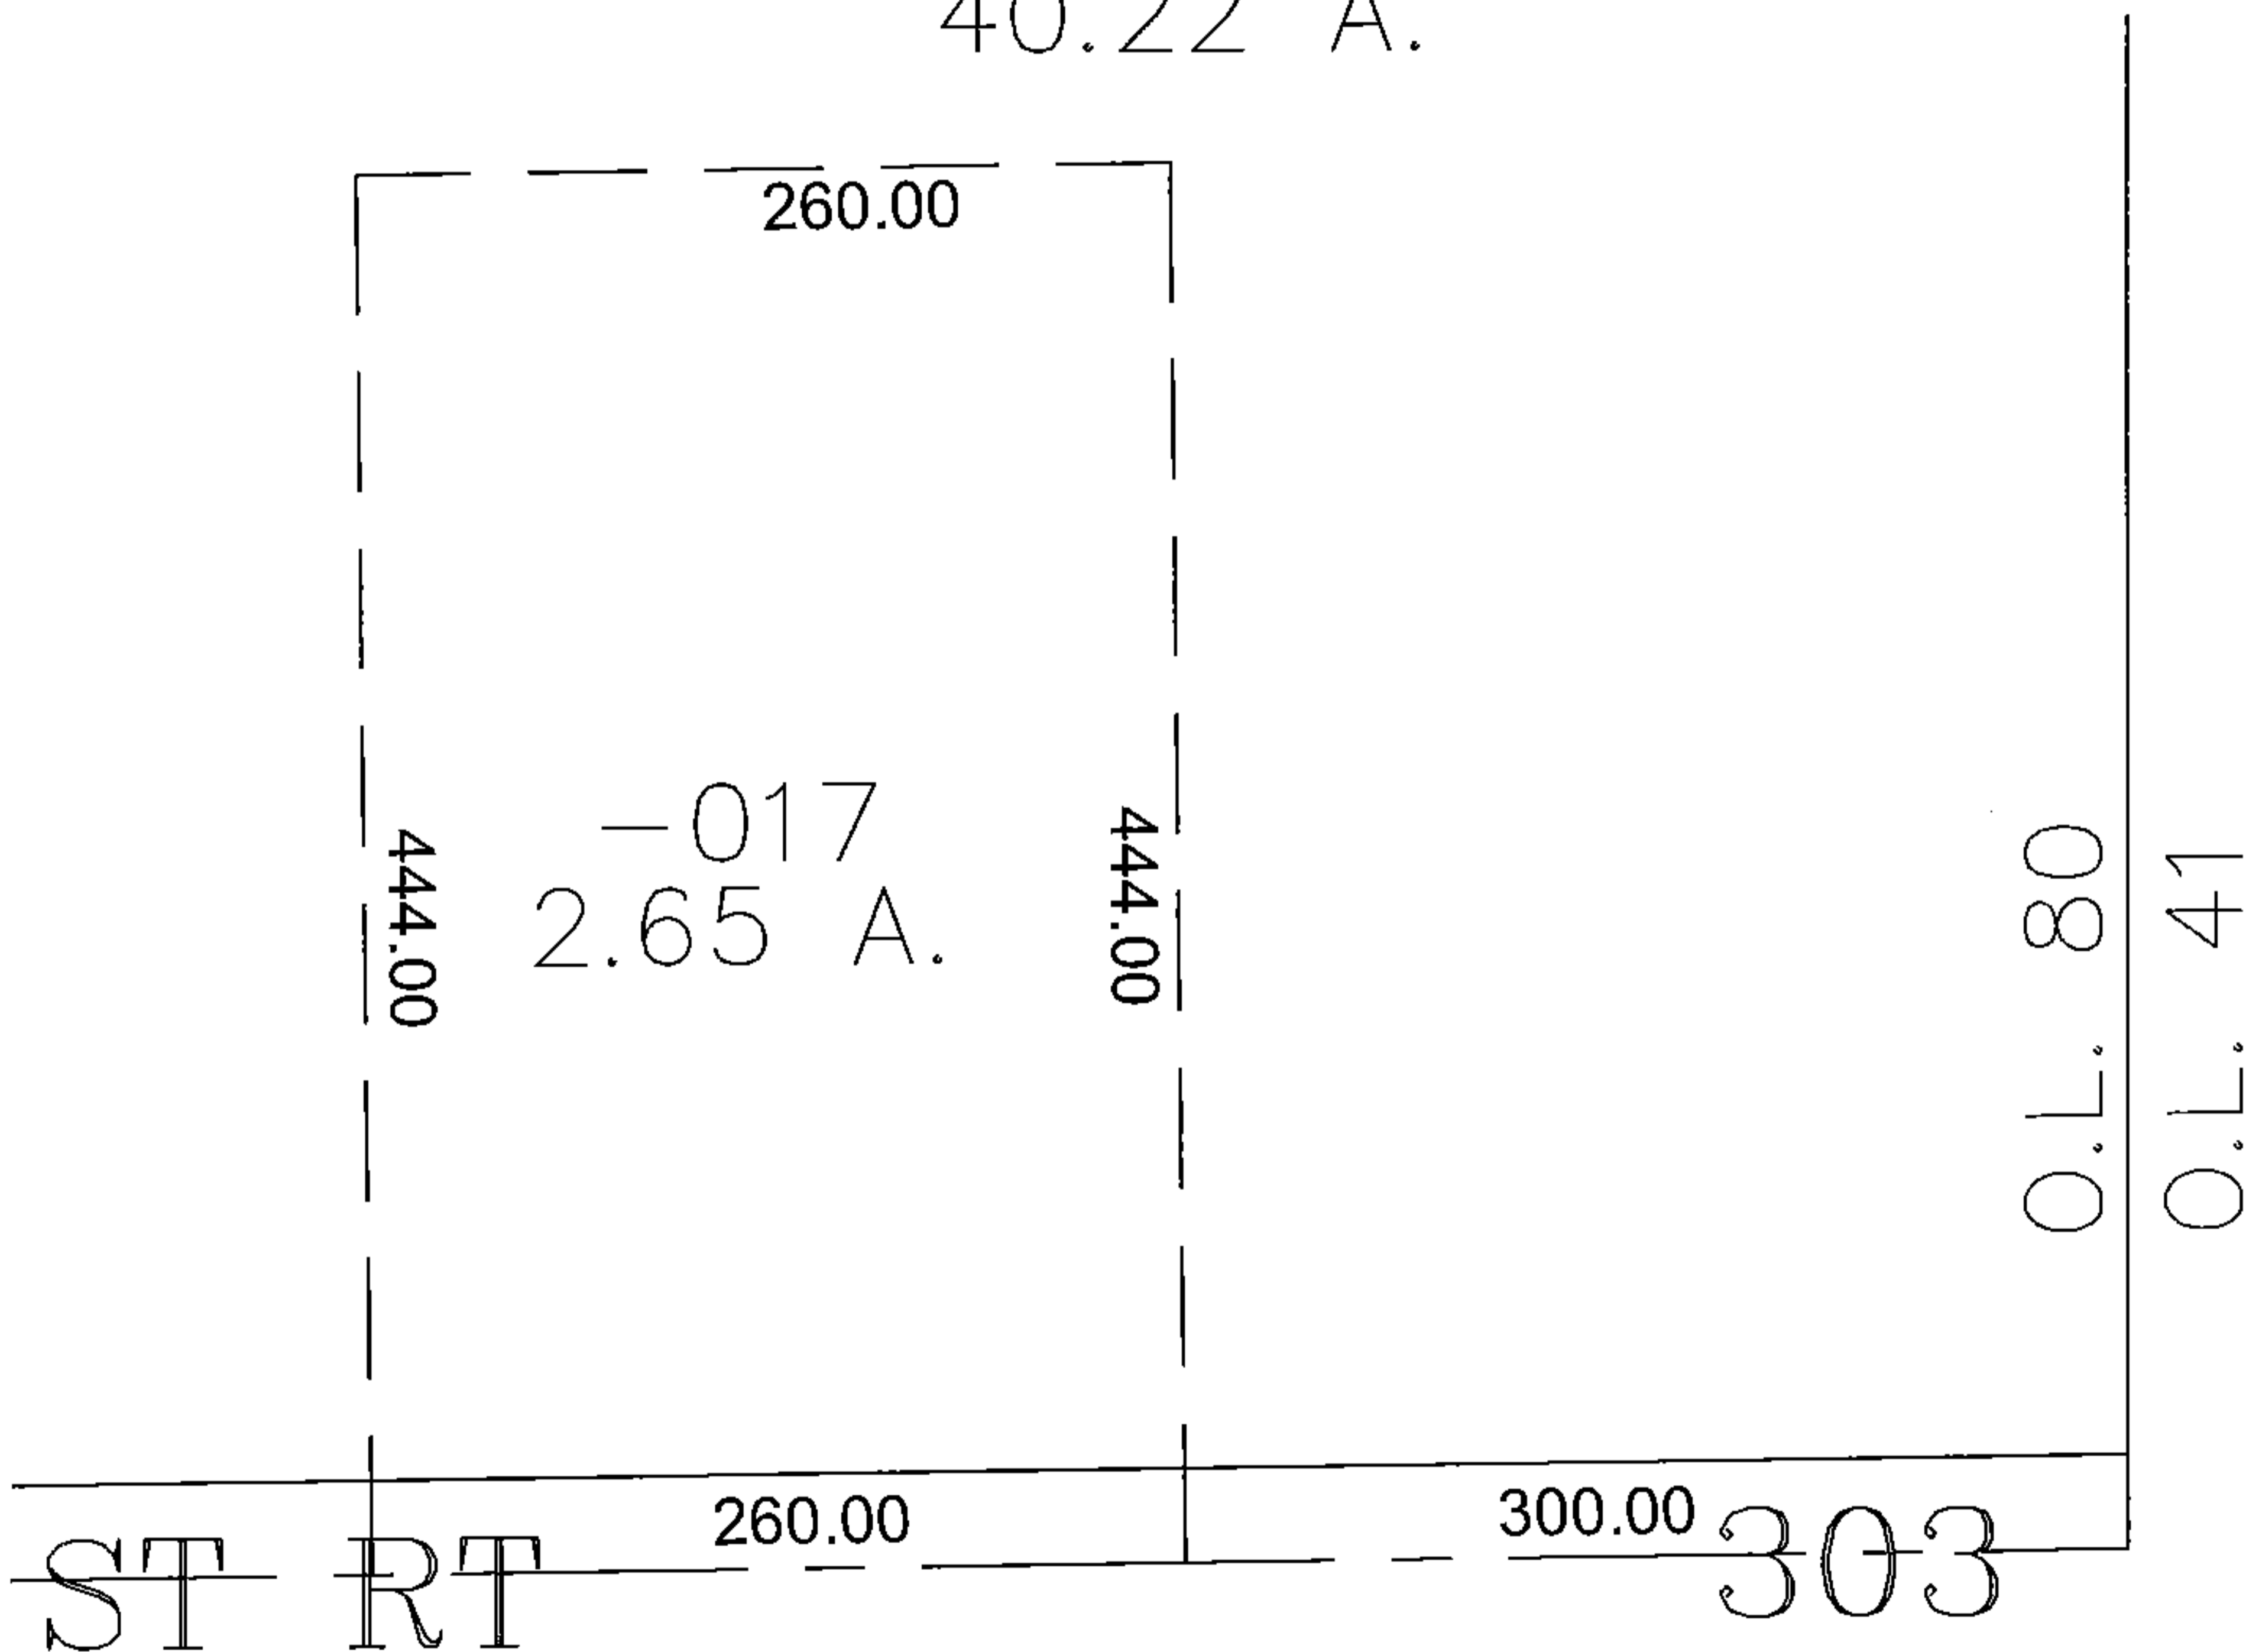

SPLITS/DEEDS PROCESSED

LORAIN COUNTY TAX MAP DEPARTMENT
226 MIDDLE AVE. ELYRIA, OHIO

SURVEYED BY: XXXXXXXXXXXX

CLOSURE: XXXXXX

MAP PAGE(S): XX-XX-XXX

APPROVED BY: XXX DATE: XX/XX/XX

SCALE: 1" = 100 PRIOR INSTRUMENT: DV XXXX/XXX