

PARENT PARCEL: 11-00-071-000-078

CHILD PARCEL: 11-00-071-000-106 & -107

16-03452-U

STARTING POINT: PARCEL # 1 - CL OF CHESTNUT RIDGE RD. & N.W. CORNER OF HONEY (DV 420/184) & PARCEL # 2 - N.W. CORNER OF LEYDIG (DV 1046/700)

### UNCOMBINATION

~~11-00-071-000-078~~  
~~2.58 A.~~

11-00-071-000-106  
0.88 A.




PER DV. 1046/700

&

11-00-071-000-107

1.70 A.

PER DV. 1372/449

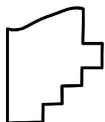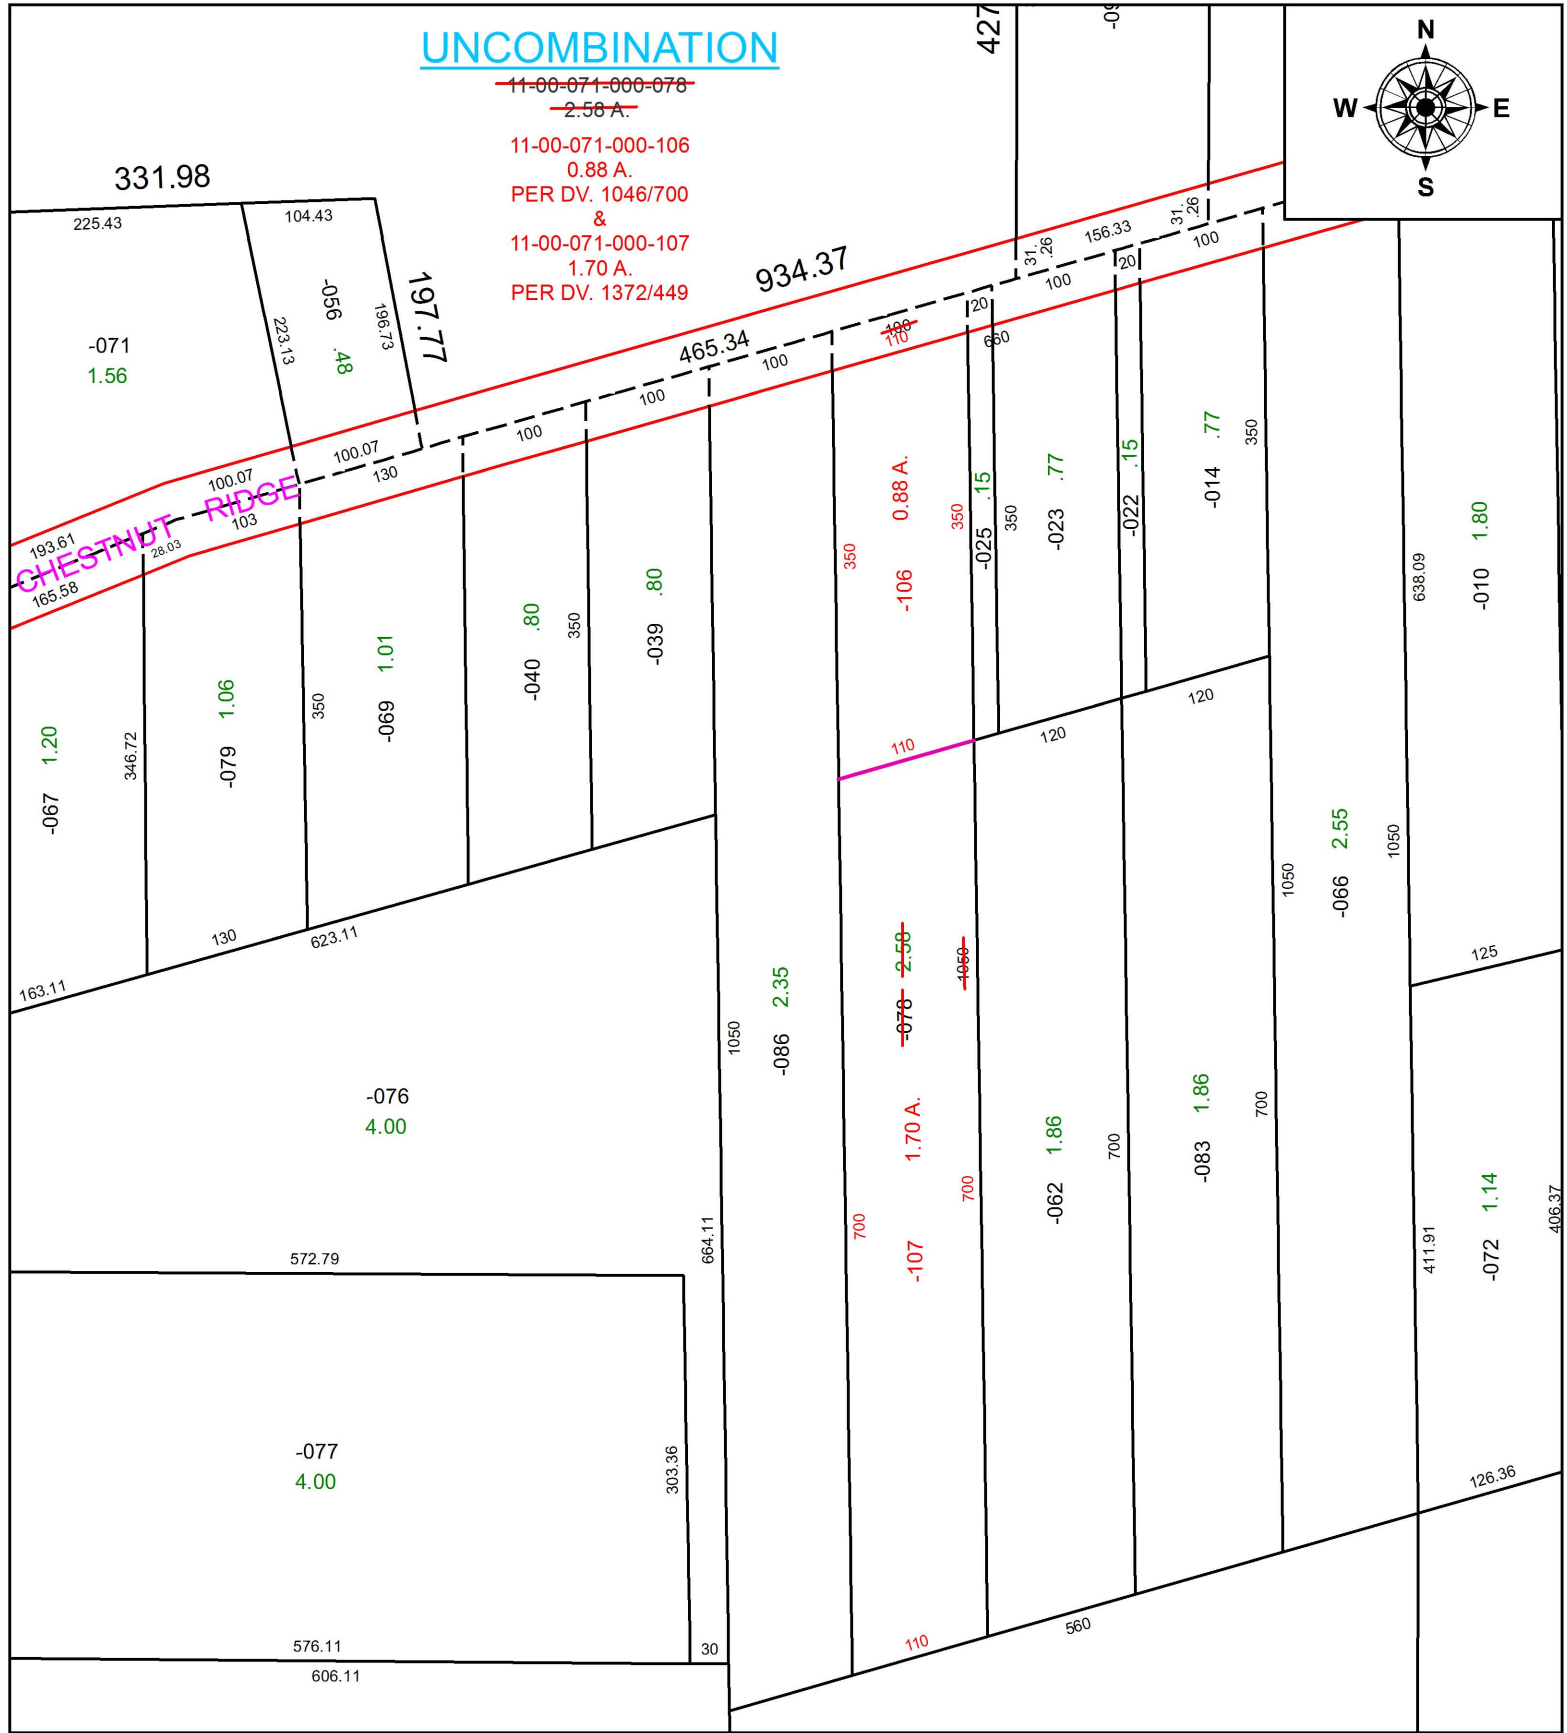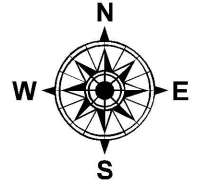

**SPLITS/DEEDS PROCESSED**  
LORAIN COUNTY TAX MAP DEPARTMENT  
226 MIDDLE AVE. ELYRIA, OH

SURVEYED BY: NA  
CLOSURE: 1: 10,000  
MAP PAGE(S): 11-00-071  
APPROVED BY: TJS DATE: 5/18/16  
SCALE: 1" = 150 PRIOR INSTRUMENT: DV XXXX/XXXX