
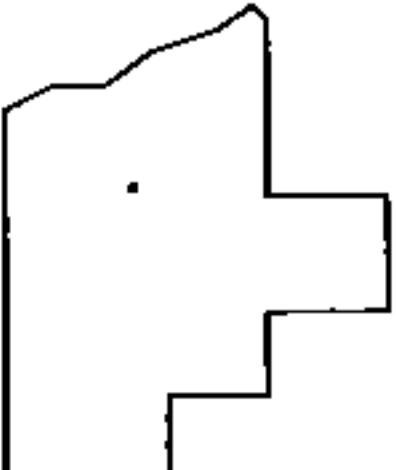


PARENT PARCEL: 02-03-005-103-004

CHILD PARCEL: 02-03-005-103-007 TRHU -010

STARTING POINT: CENTERLINE OF KOLBE RD & O.L. 5

15-03452

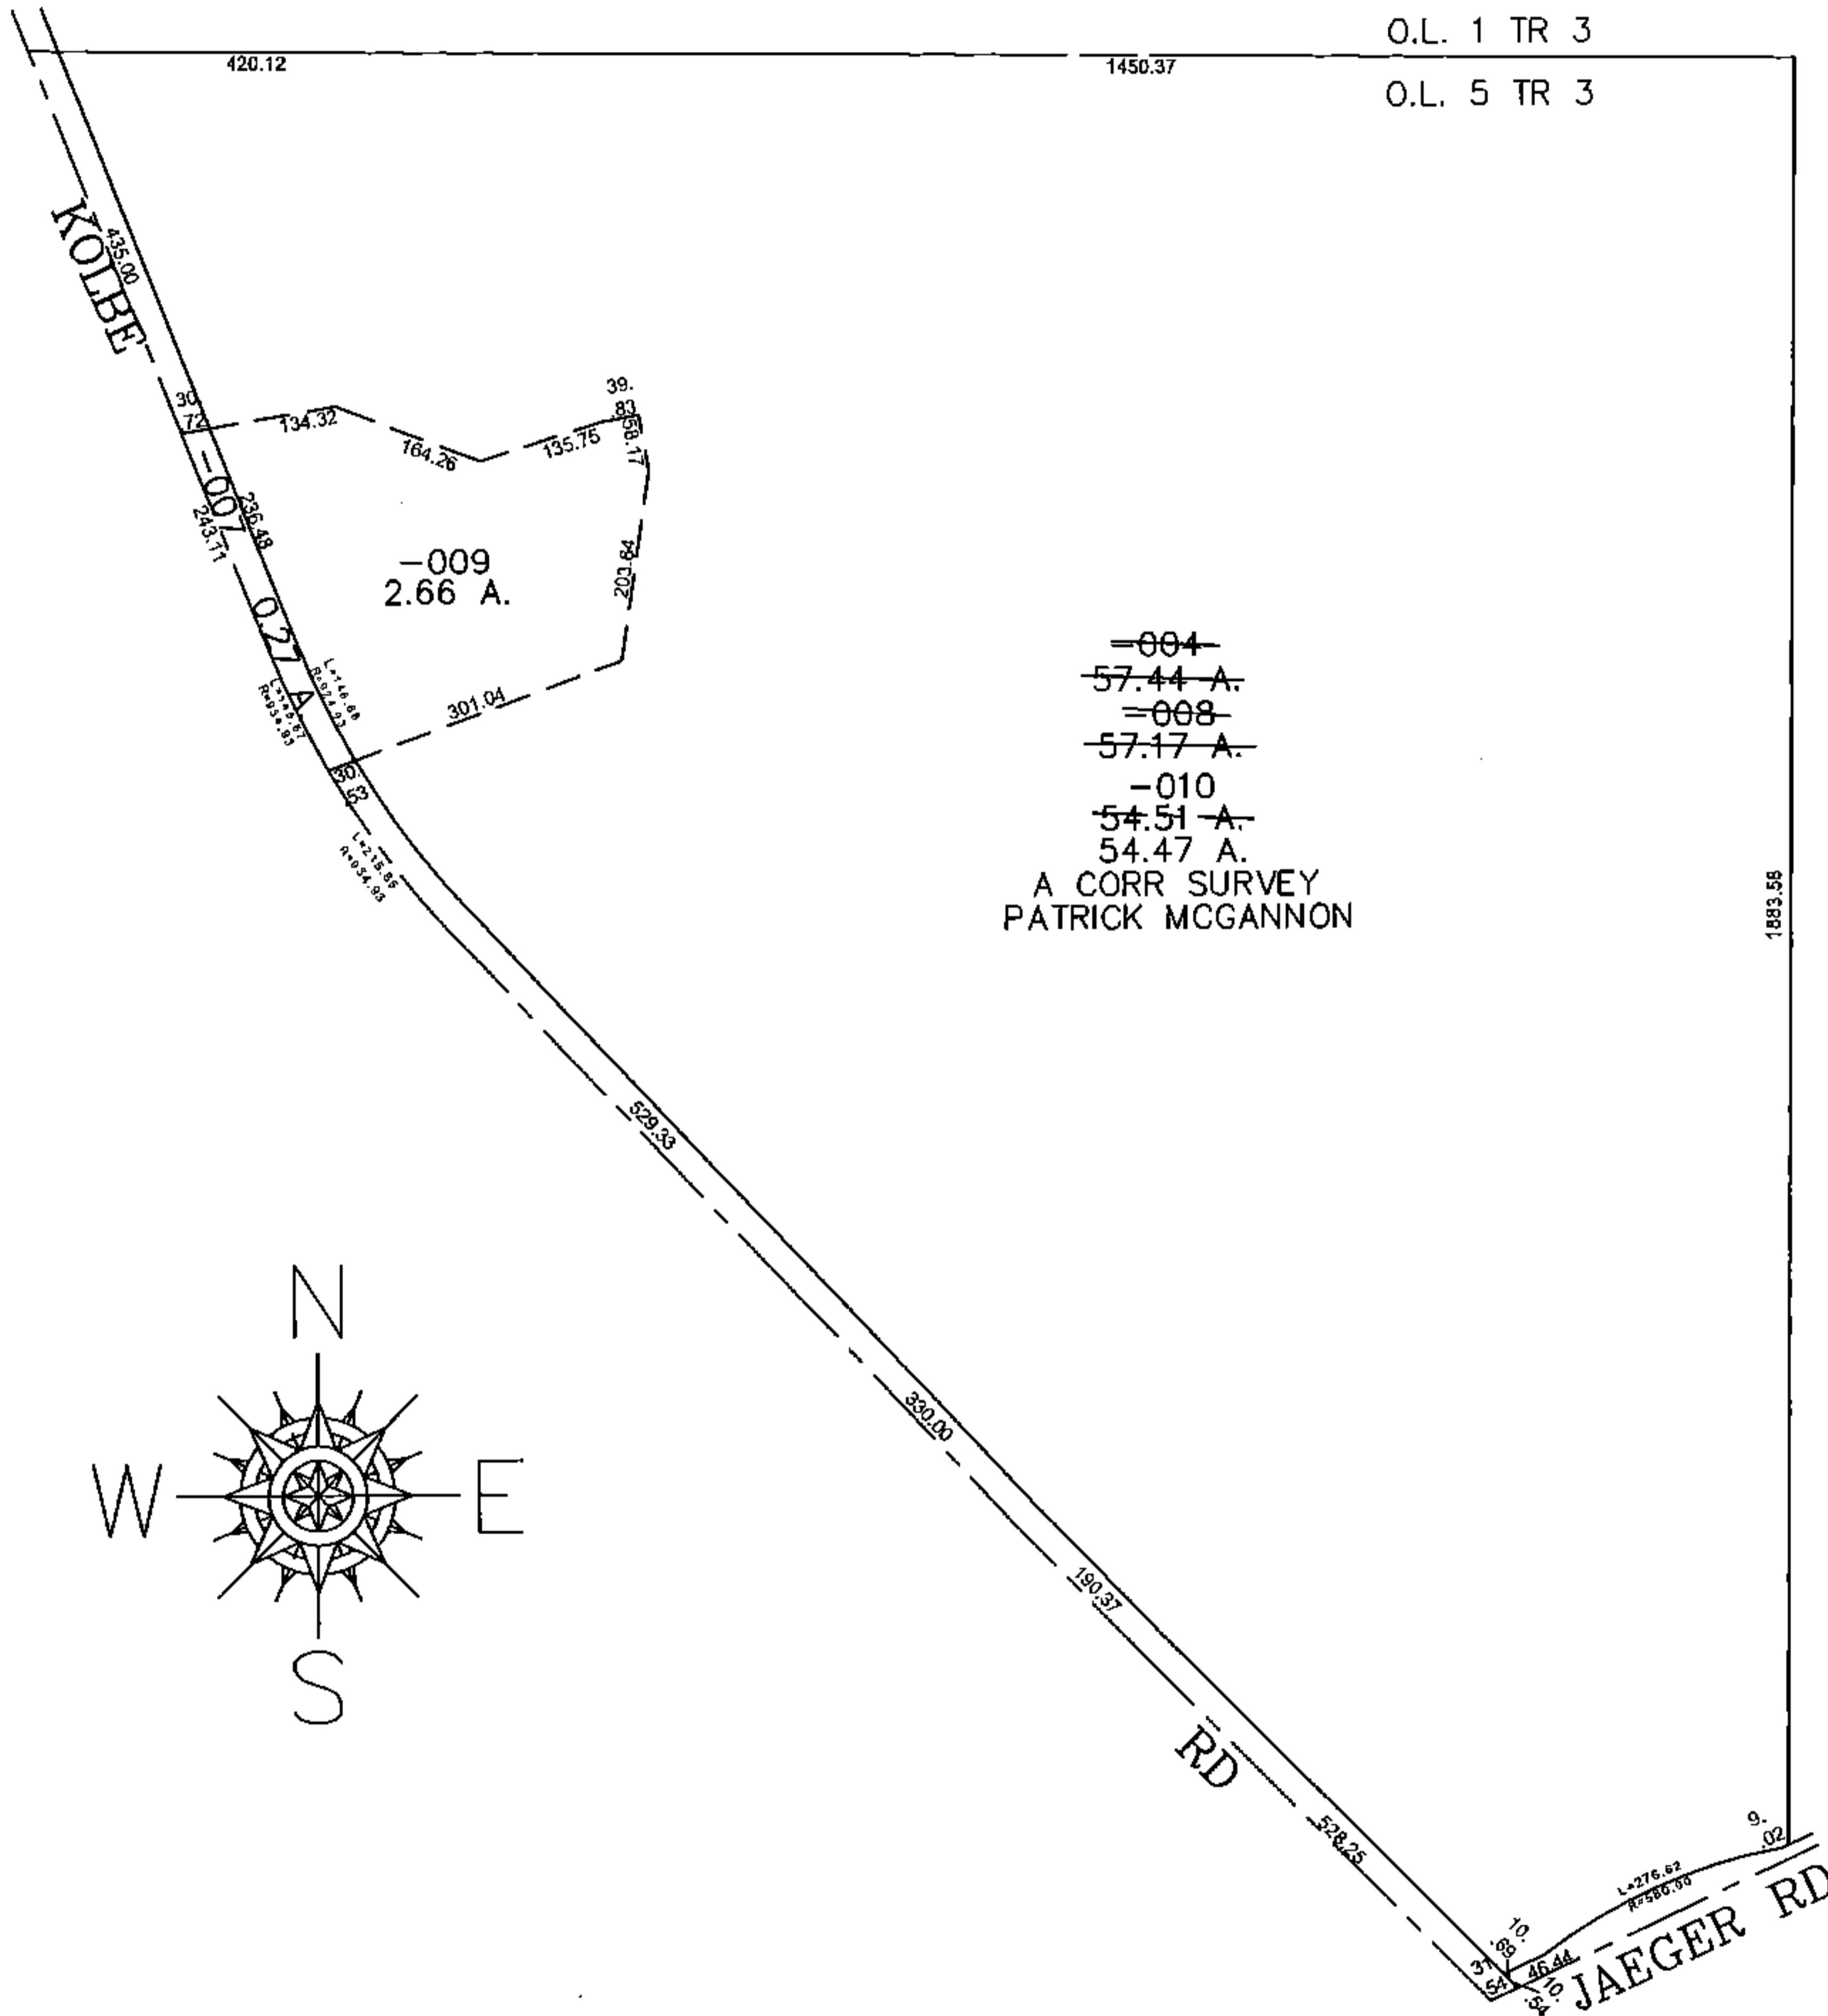

SPLITS/DEEDS PROCESSED
 LORAIN COUNTY TAX MAP DEPARTMENT
 226 MIDDLE AVE. ELYRIA, OHIO

SURVEYED BY: PATRICK MCGANNON
 CLOSURE: 0.00 : 10,000
 MAP PAGE(S): 02-03-005
 APPROVED BY: JAH DATE: 12/14/2015
 SCALE: 1" = 300 PRIOR INSTRUMENT: 20000711952