
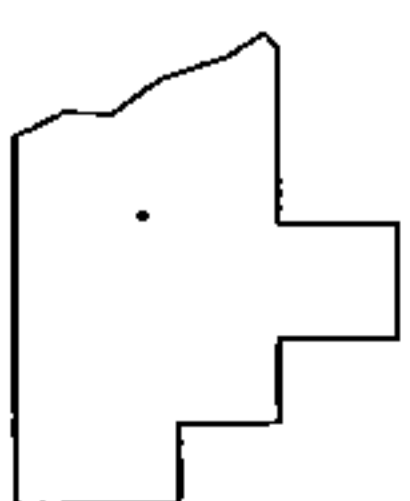
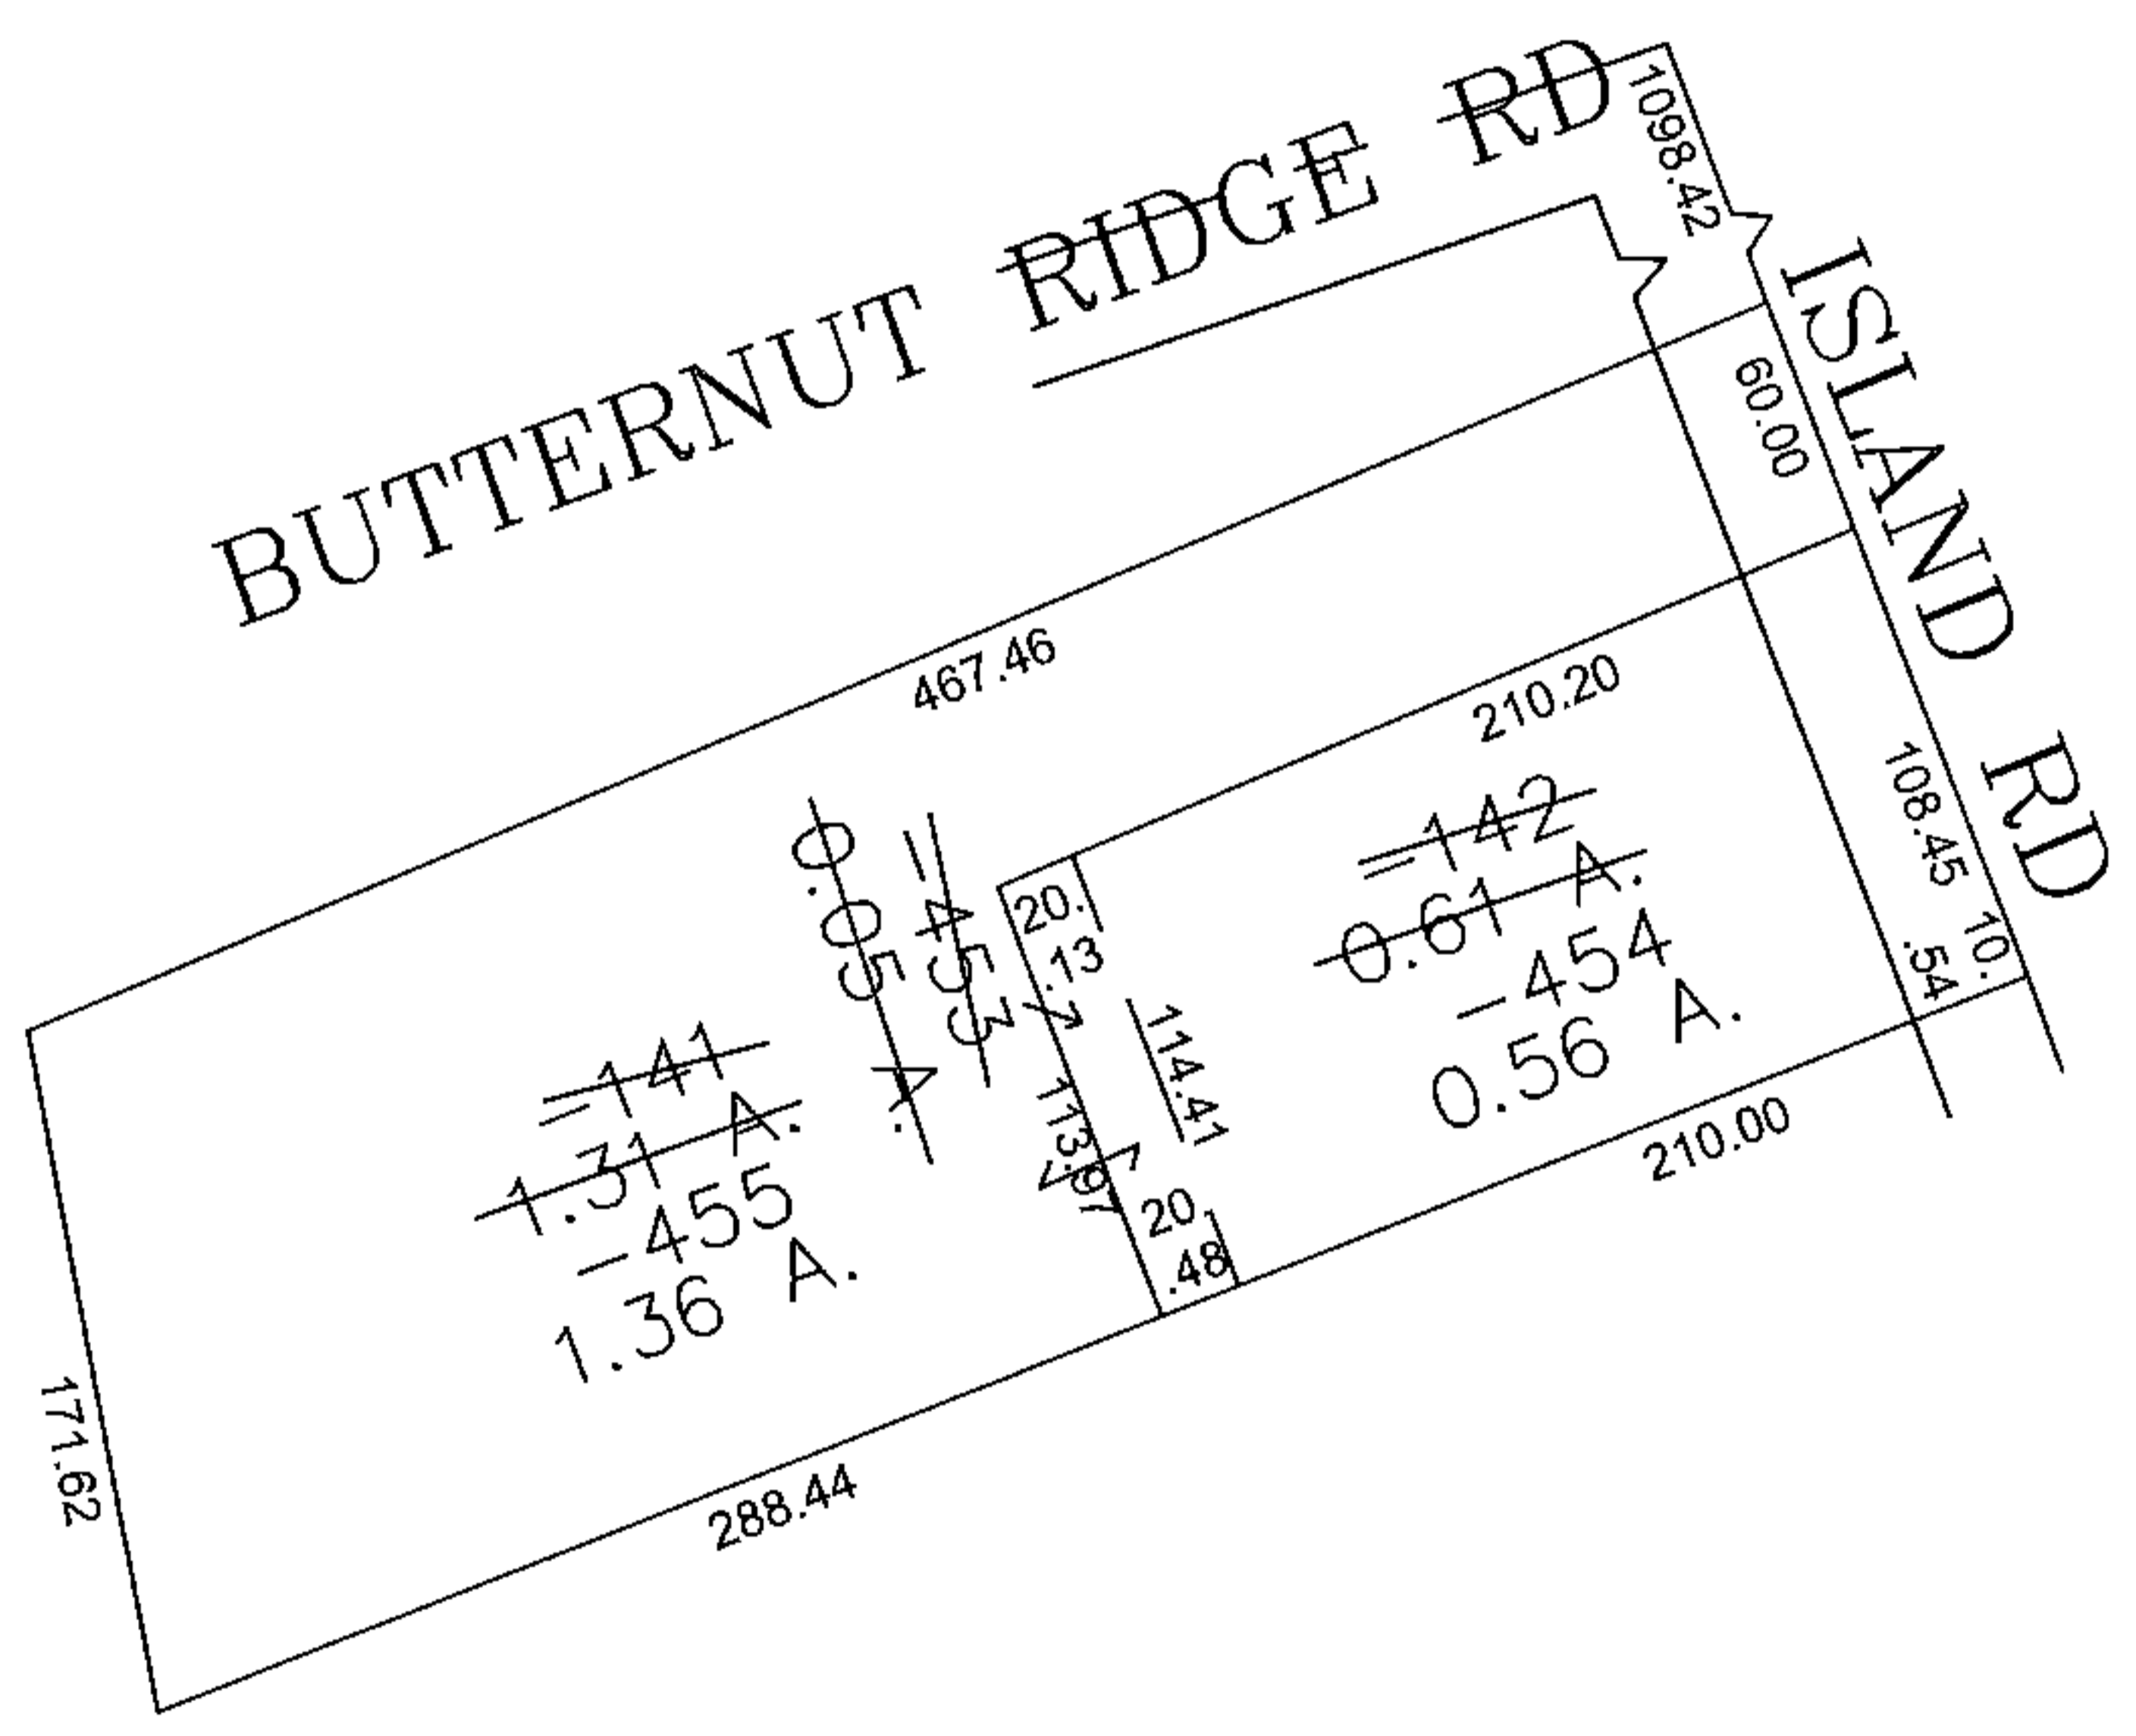


PARENT PARCEL: 07-00-013-000-141, -142  
 CHILD PARCEL: 07-00-013-000-453 THRU -455  
 STARTING POINT: CENTERLINE OF BUTTERNUT RIDGE RD & ISLAND RD

15-03453

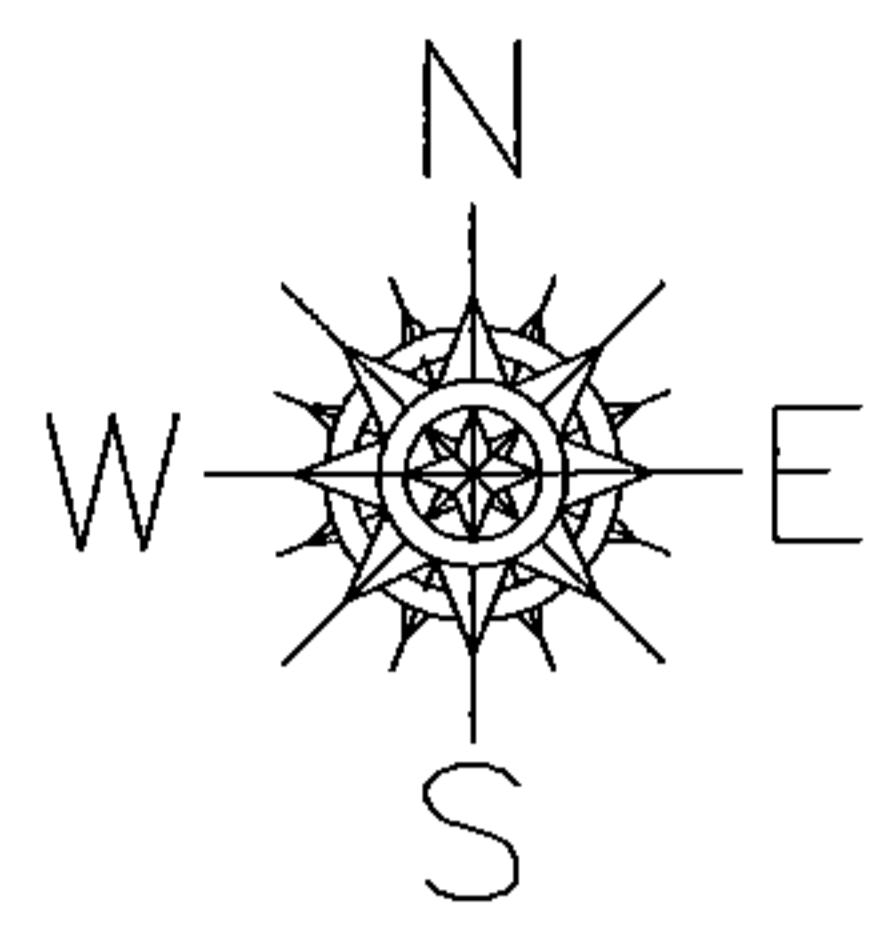

SPLITS/DEEDS PROCESSED

LORAIN COUNTY TAX MAP DEPARTMENT  
 226 MIDDLE AVE. ELYRIA, OHIO

SURVEYED BY: WILFREDO BARBOSA  
 CLOSURE: 0.00 : 10,000  
 MAP PAGE(S): 07-00-013-A  
 APPROVED BY: JAH DATE: 12/14/2015  
 SCALE: 1" = 100 PRIOR INSTRUMENT: OR 1406/639