


PARENT PARCEL: 01-00-044-000-007



CHILD PARCEL: XX-XX-XXX-XXX-XXX

STARTING POINT: NORTHEAST CORNER OF O.L.44

16-03454-A

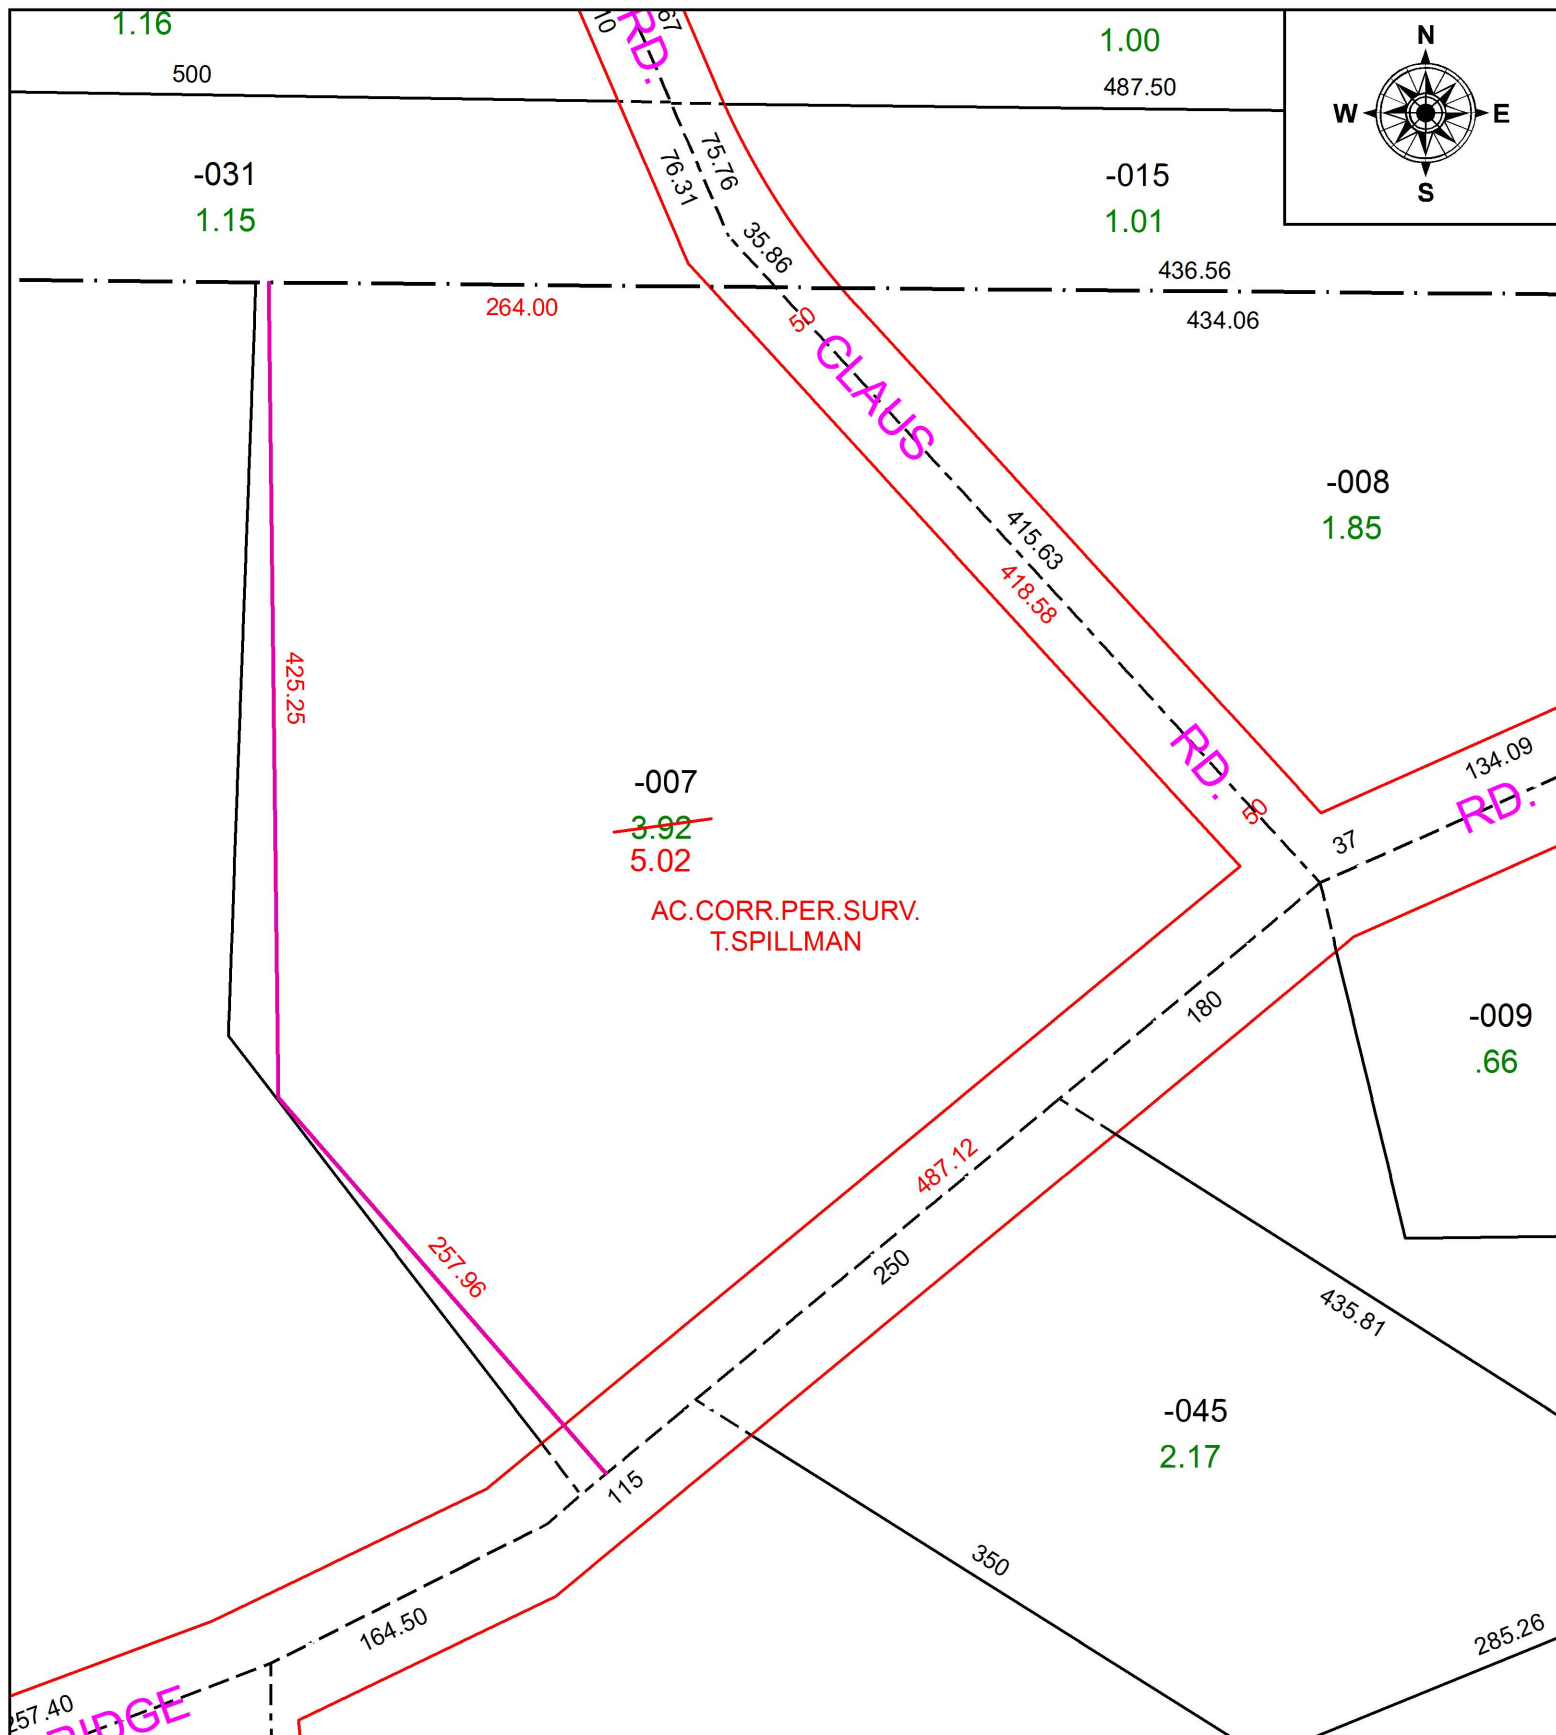

-007  
~~3.92~~  
 5.02  
 AC.CORR.PER.SURV.  
 T.SPILLMAN

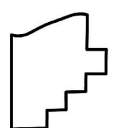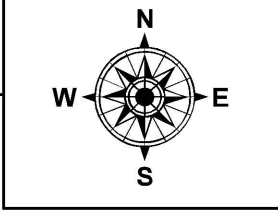

**SPLITS/DEEDS PROCESSED**  
 LORAIN COUNTY TAX MAP DEPARTMENT  
 226 MIDDLE AVE. ELYRIA, OH

SURVEYED BY: THEODORE J. SPILLMAN  
 CLOSURE: 1: 382,243  
 MAP PAGE(S): 1-00-044-B  
 APPROVED BY: RRM DATE: 5-19-16  
 SCALE: 1" = 100 PRIOR INSTRUMENT: 20140504752