
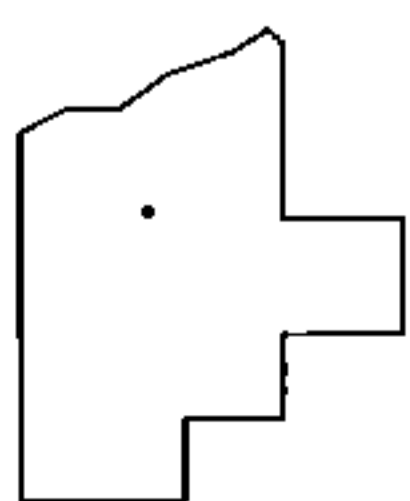
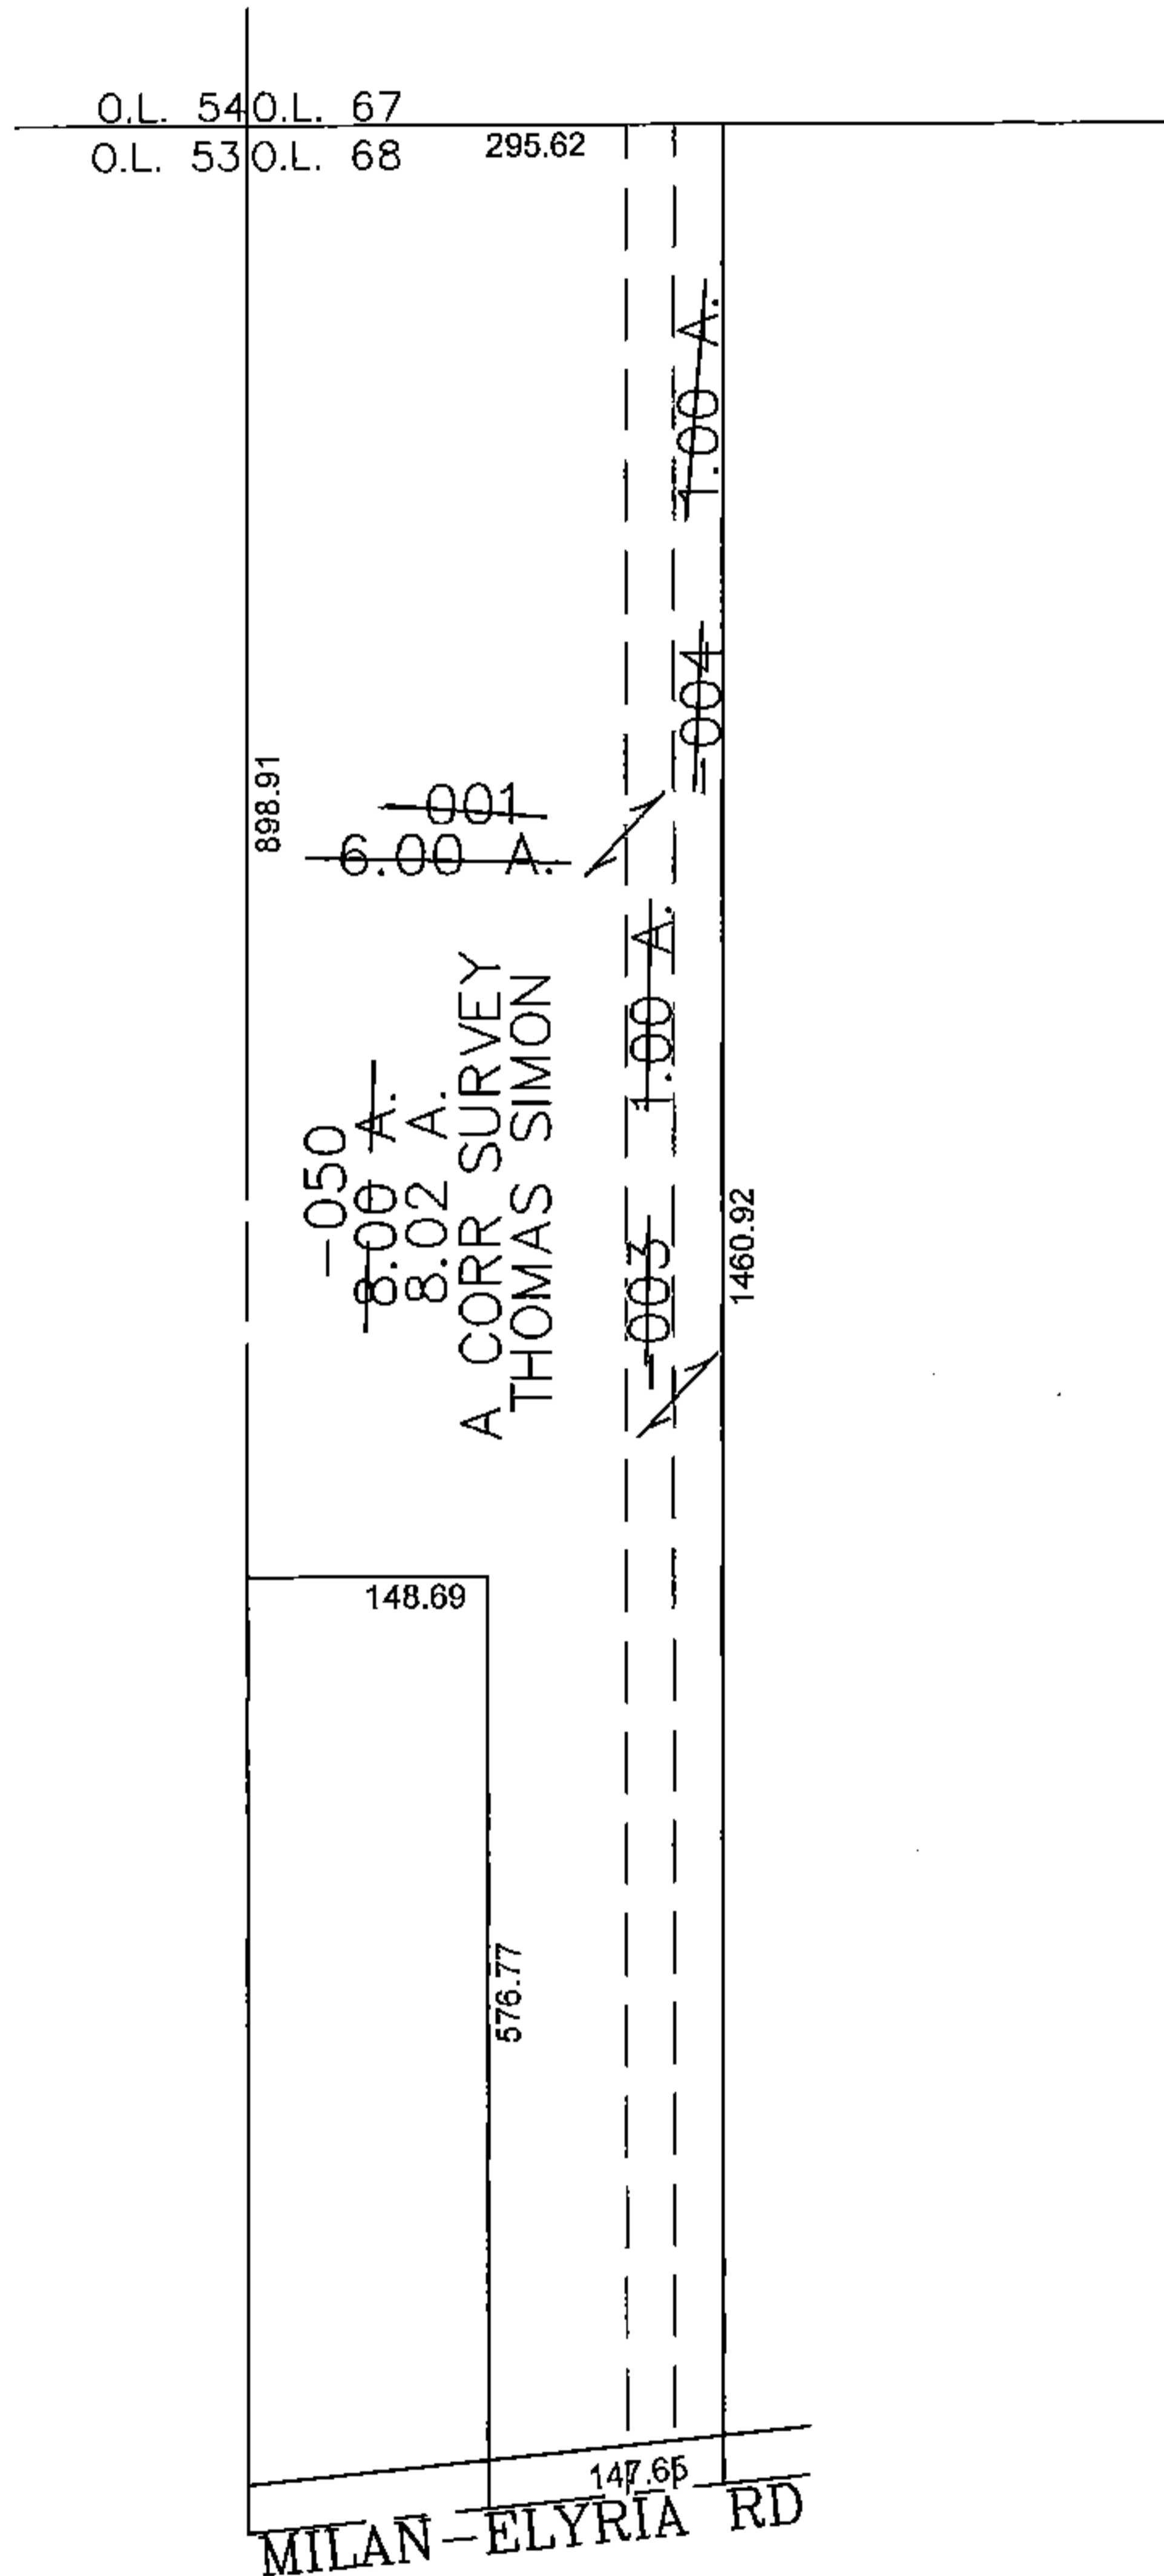


PARENT PARCEL: 05-00-068-000-001, -003, -004  
CHILD PARCEL: 05-00-068-000-050  
STARTING POINT: NORTHWEST CORNER OF ORIGINAL LOT 68

15-03455

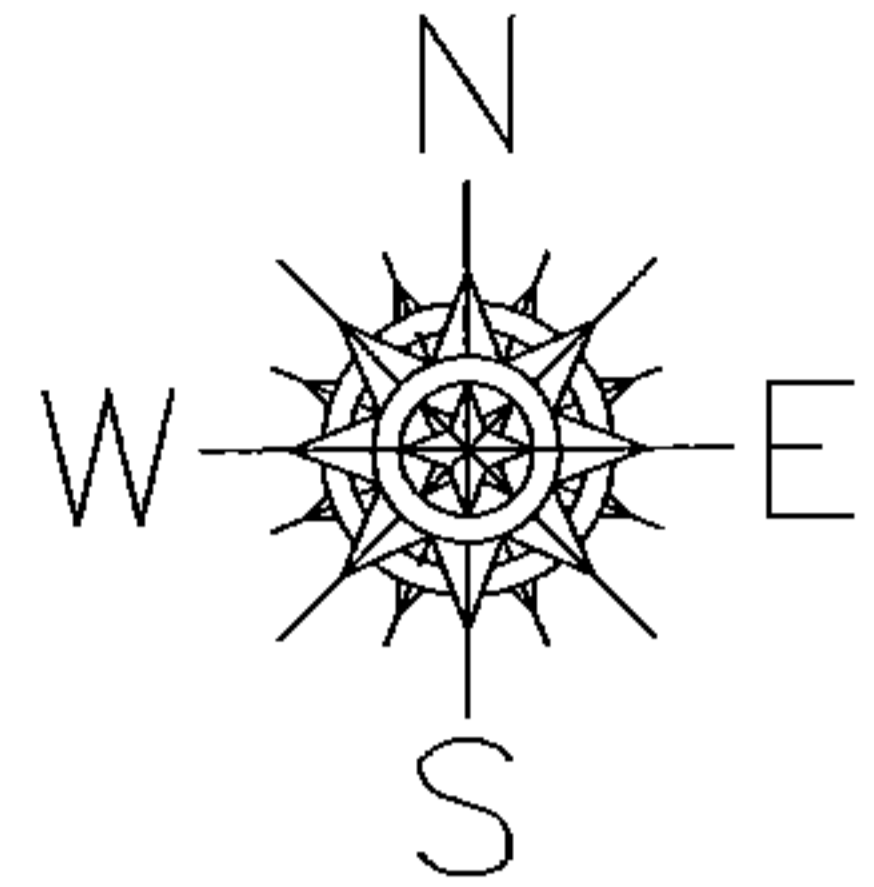

**SPLITS/DEEDS PROCESSED**  
LORAIN COUNTY TAX MAP DEPARTMENT  
226 MIDDLE AVE. ELYRIA, OHIO

SURVEYED BY: THOMAS SIMON  
CLOSURE: 0.00 : 10,000  
MAP PAGE(S): 05-00-068-A  
APPROVED BY: JAH DATE: 12/16/2015  
SCALE: 1" = 200' PRIOR INSTRUMENT: 20150550316