



PARENT PARCEL: 07-00-008-700-013  
 CHILD PARCEL: XX-XX-XXX-XXX-XXX  
 STARTING POINT:

16-03458-C

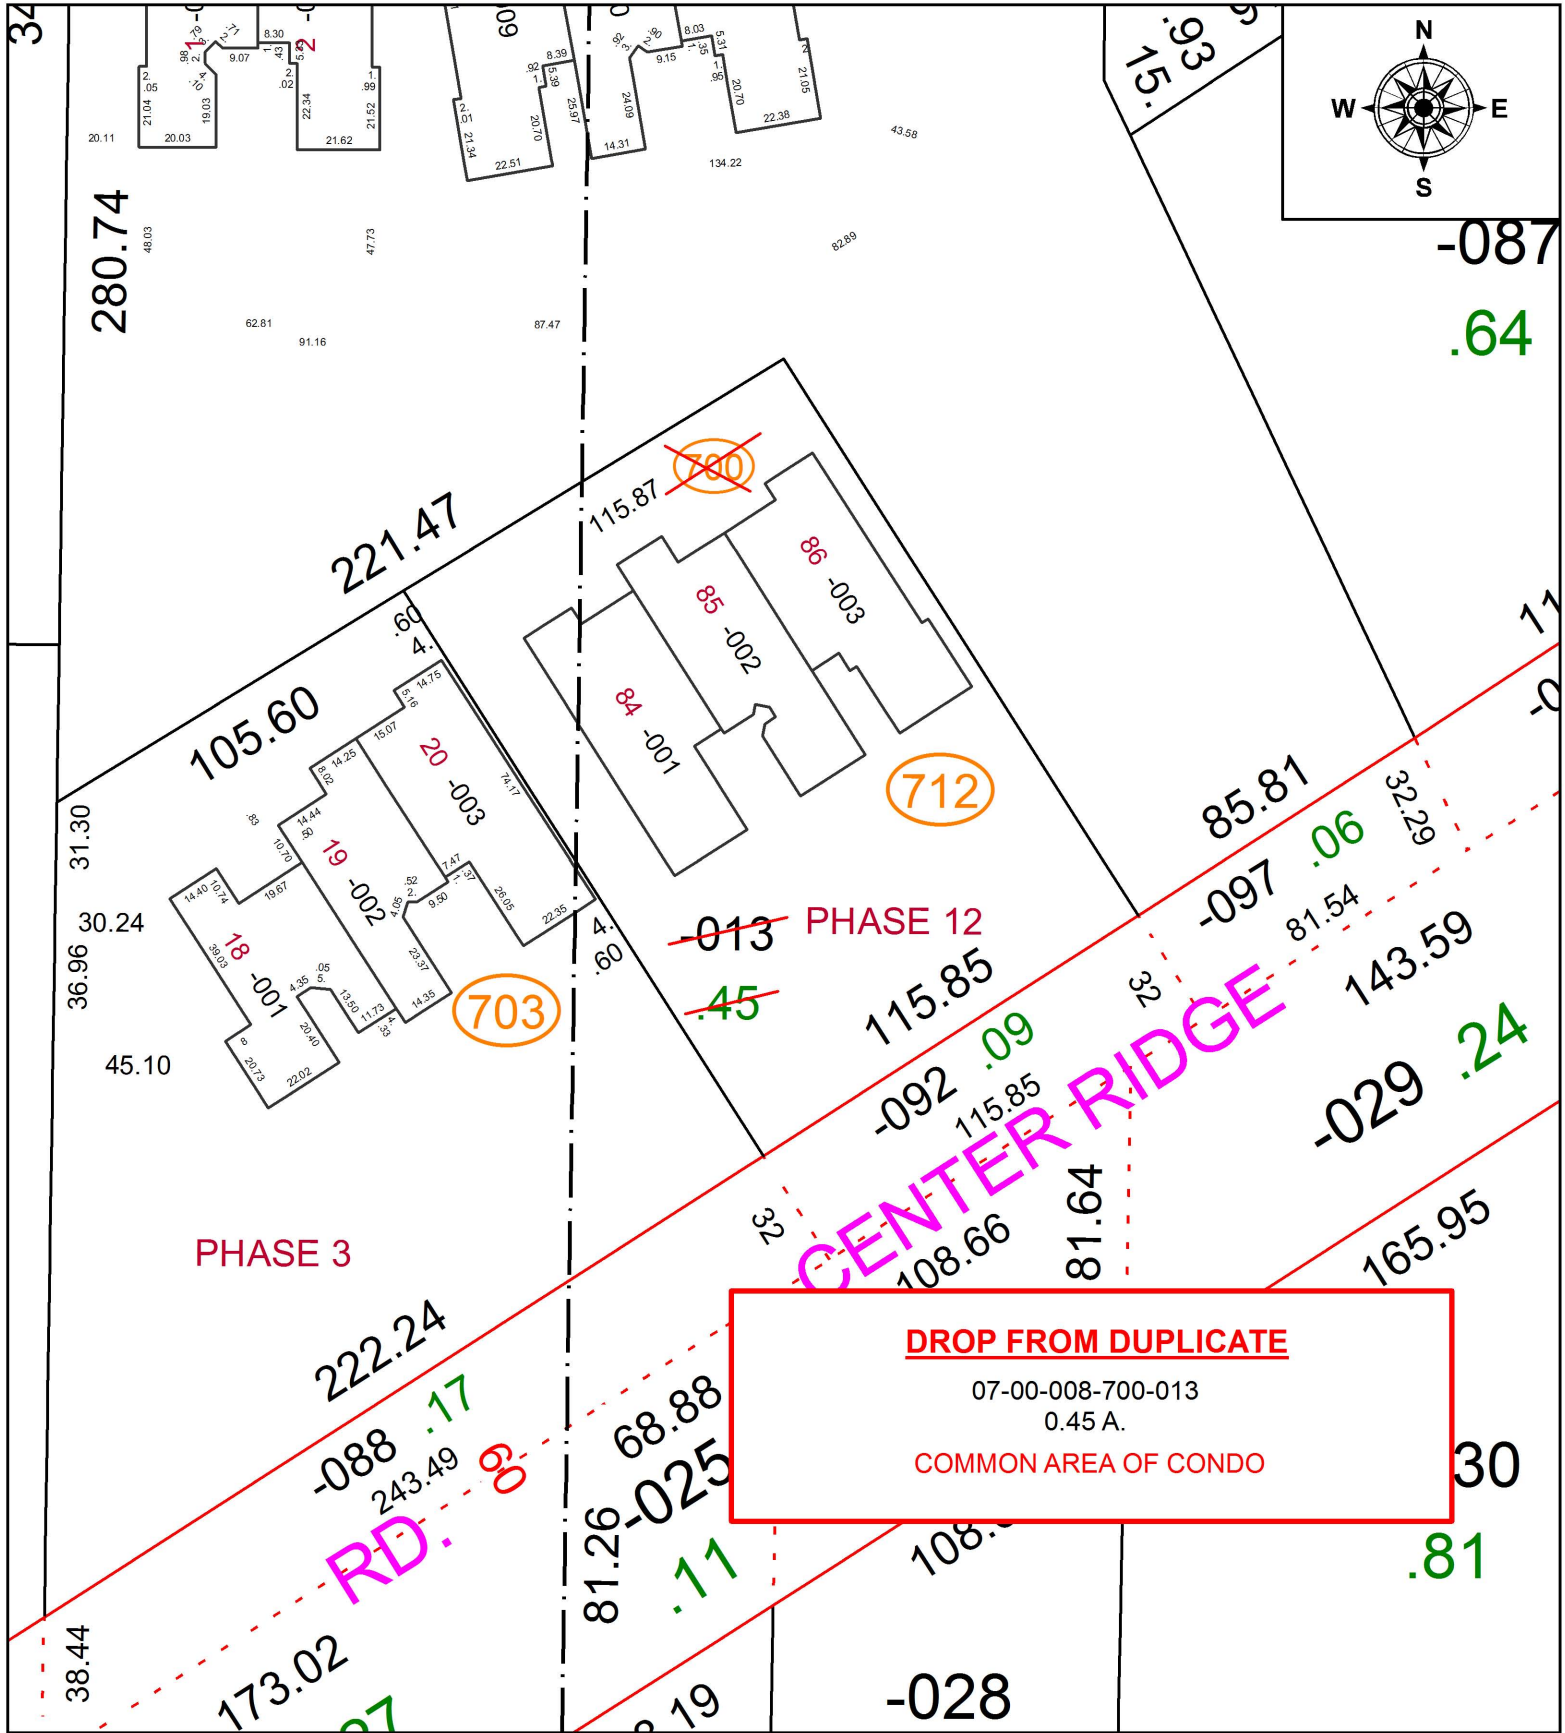

**DROP FROM DUPLICATE**  
 07-00-008-700-013  
 0.45 A.  
 COMMON AREA OF CONDO

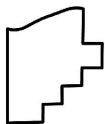

**SPLITS/DEEDS PROCESSED**  
 LORAIN COUNTY TAX MAP DEPARTMENT  
 226 MIDDLE AVE. ELYRIA, OH

SURVEYED BY: \_\_\_\_\_ N/A  
 CLOSURE: \_\_\_\_\_ N/A  
 MAP PAGE(S): \_\_\_\_\_ 7-00-008  
 APPROVED BY: \_\_\_\_\_ RRM DATE: \_\_\_\_\_ 5-25-16  
 SCALE: \_\_\_\_\_ 1" = 50 \_\_\_\_\_ PRIOR INSTRUMENT: \_\_\_\_\_ N/A