
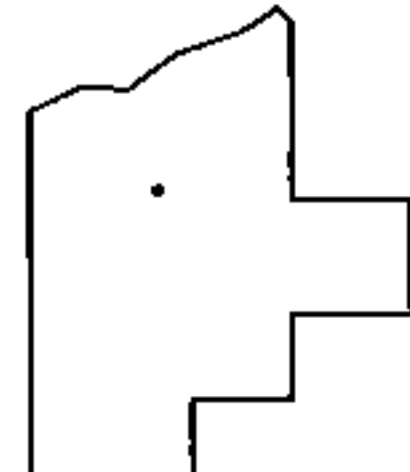
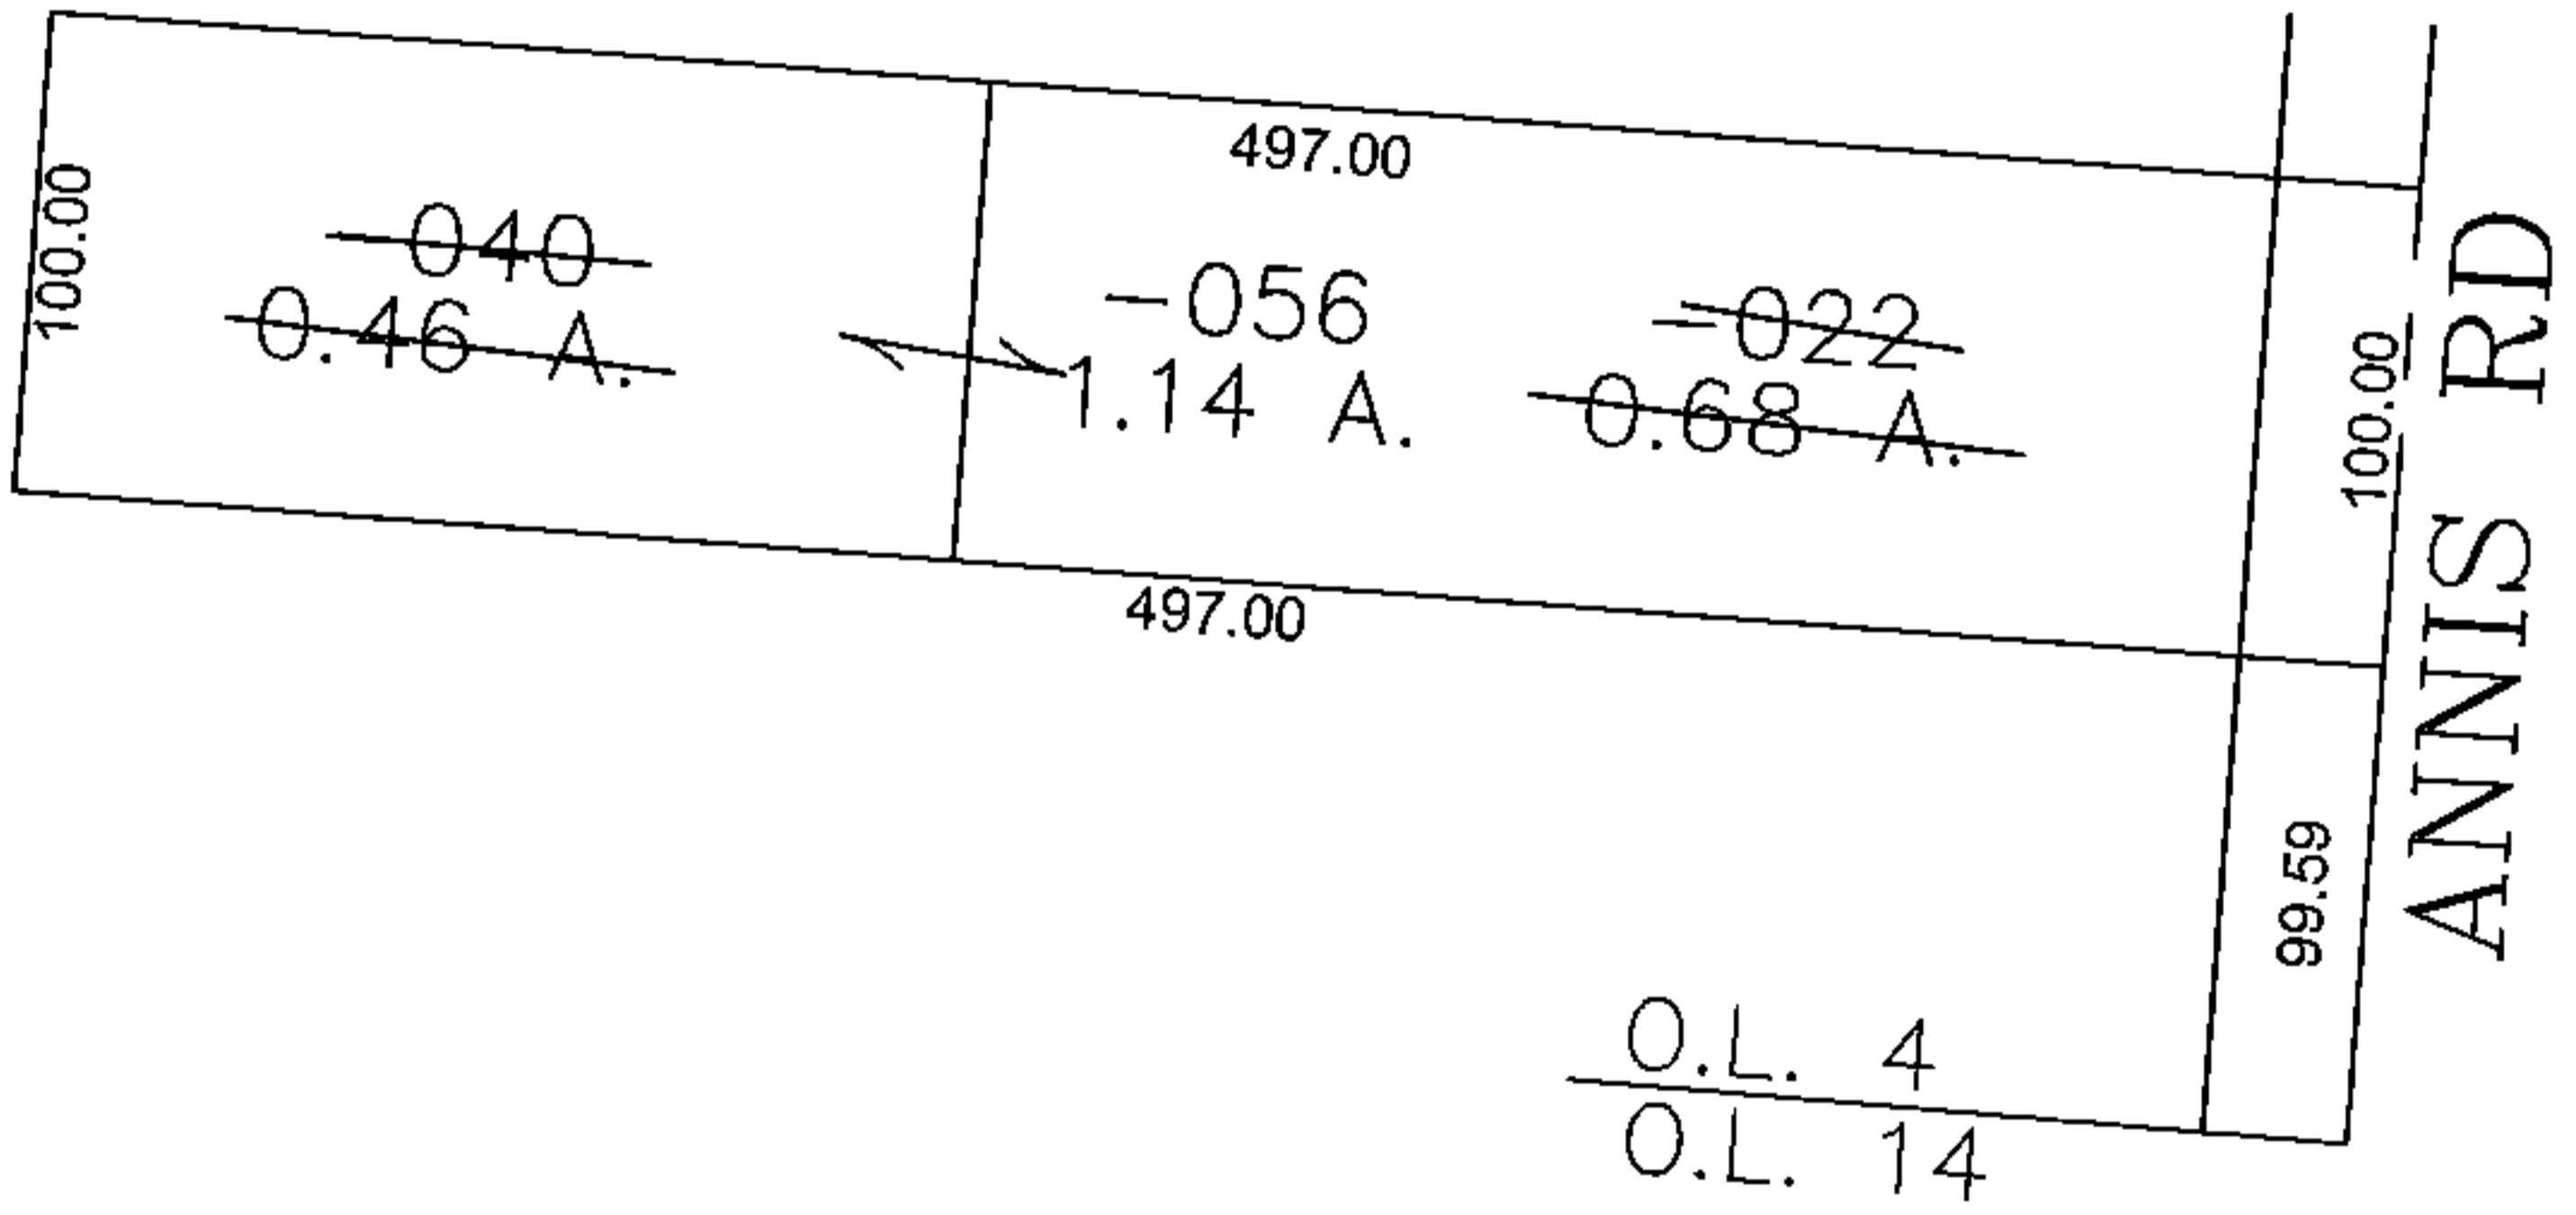


PARENT PARCEL: 09-00-004-101-022, -040
CHILD PARCEL: 09-00-004-101-056
STARTING POINT: CENTERLINE OF ANNIS RD & O.L. 4

15-03458

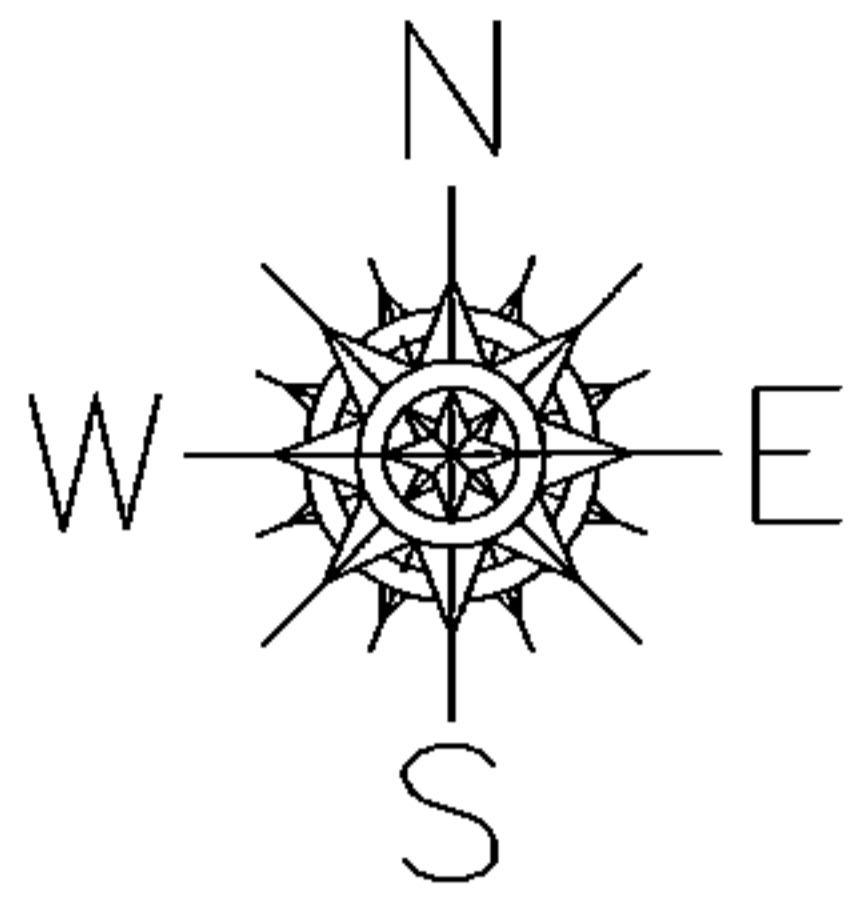

SPLITS/DEEDS PROCESSED

LORAIN COUNTY TAX MAP DEPARTMENT
226 MIDDLE AVE. ELYRIA, OHIO

SURVEYED BY: DAVID WILLIAMS
CLOSURE: 0.00: 10.000
MAP PAGE(S): 09-00-004
APPROVED BY: JAH DATE: 1/19/2016
SCALE: 1" = 100 PRIOR INSTRUMENT: 19980540931