
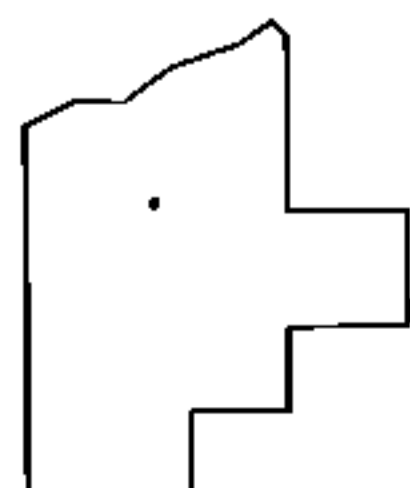
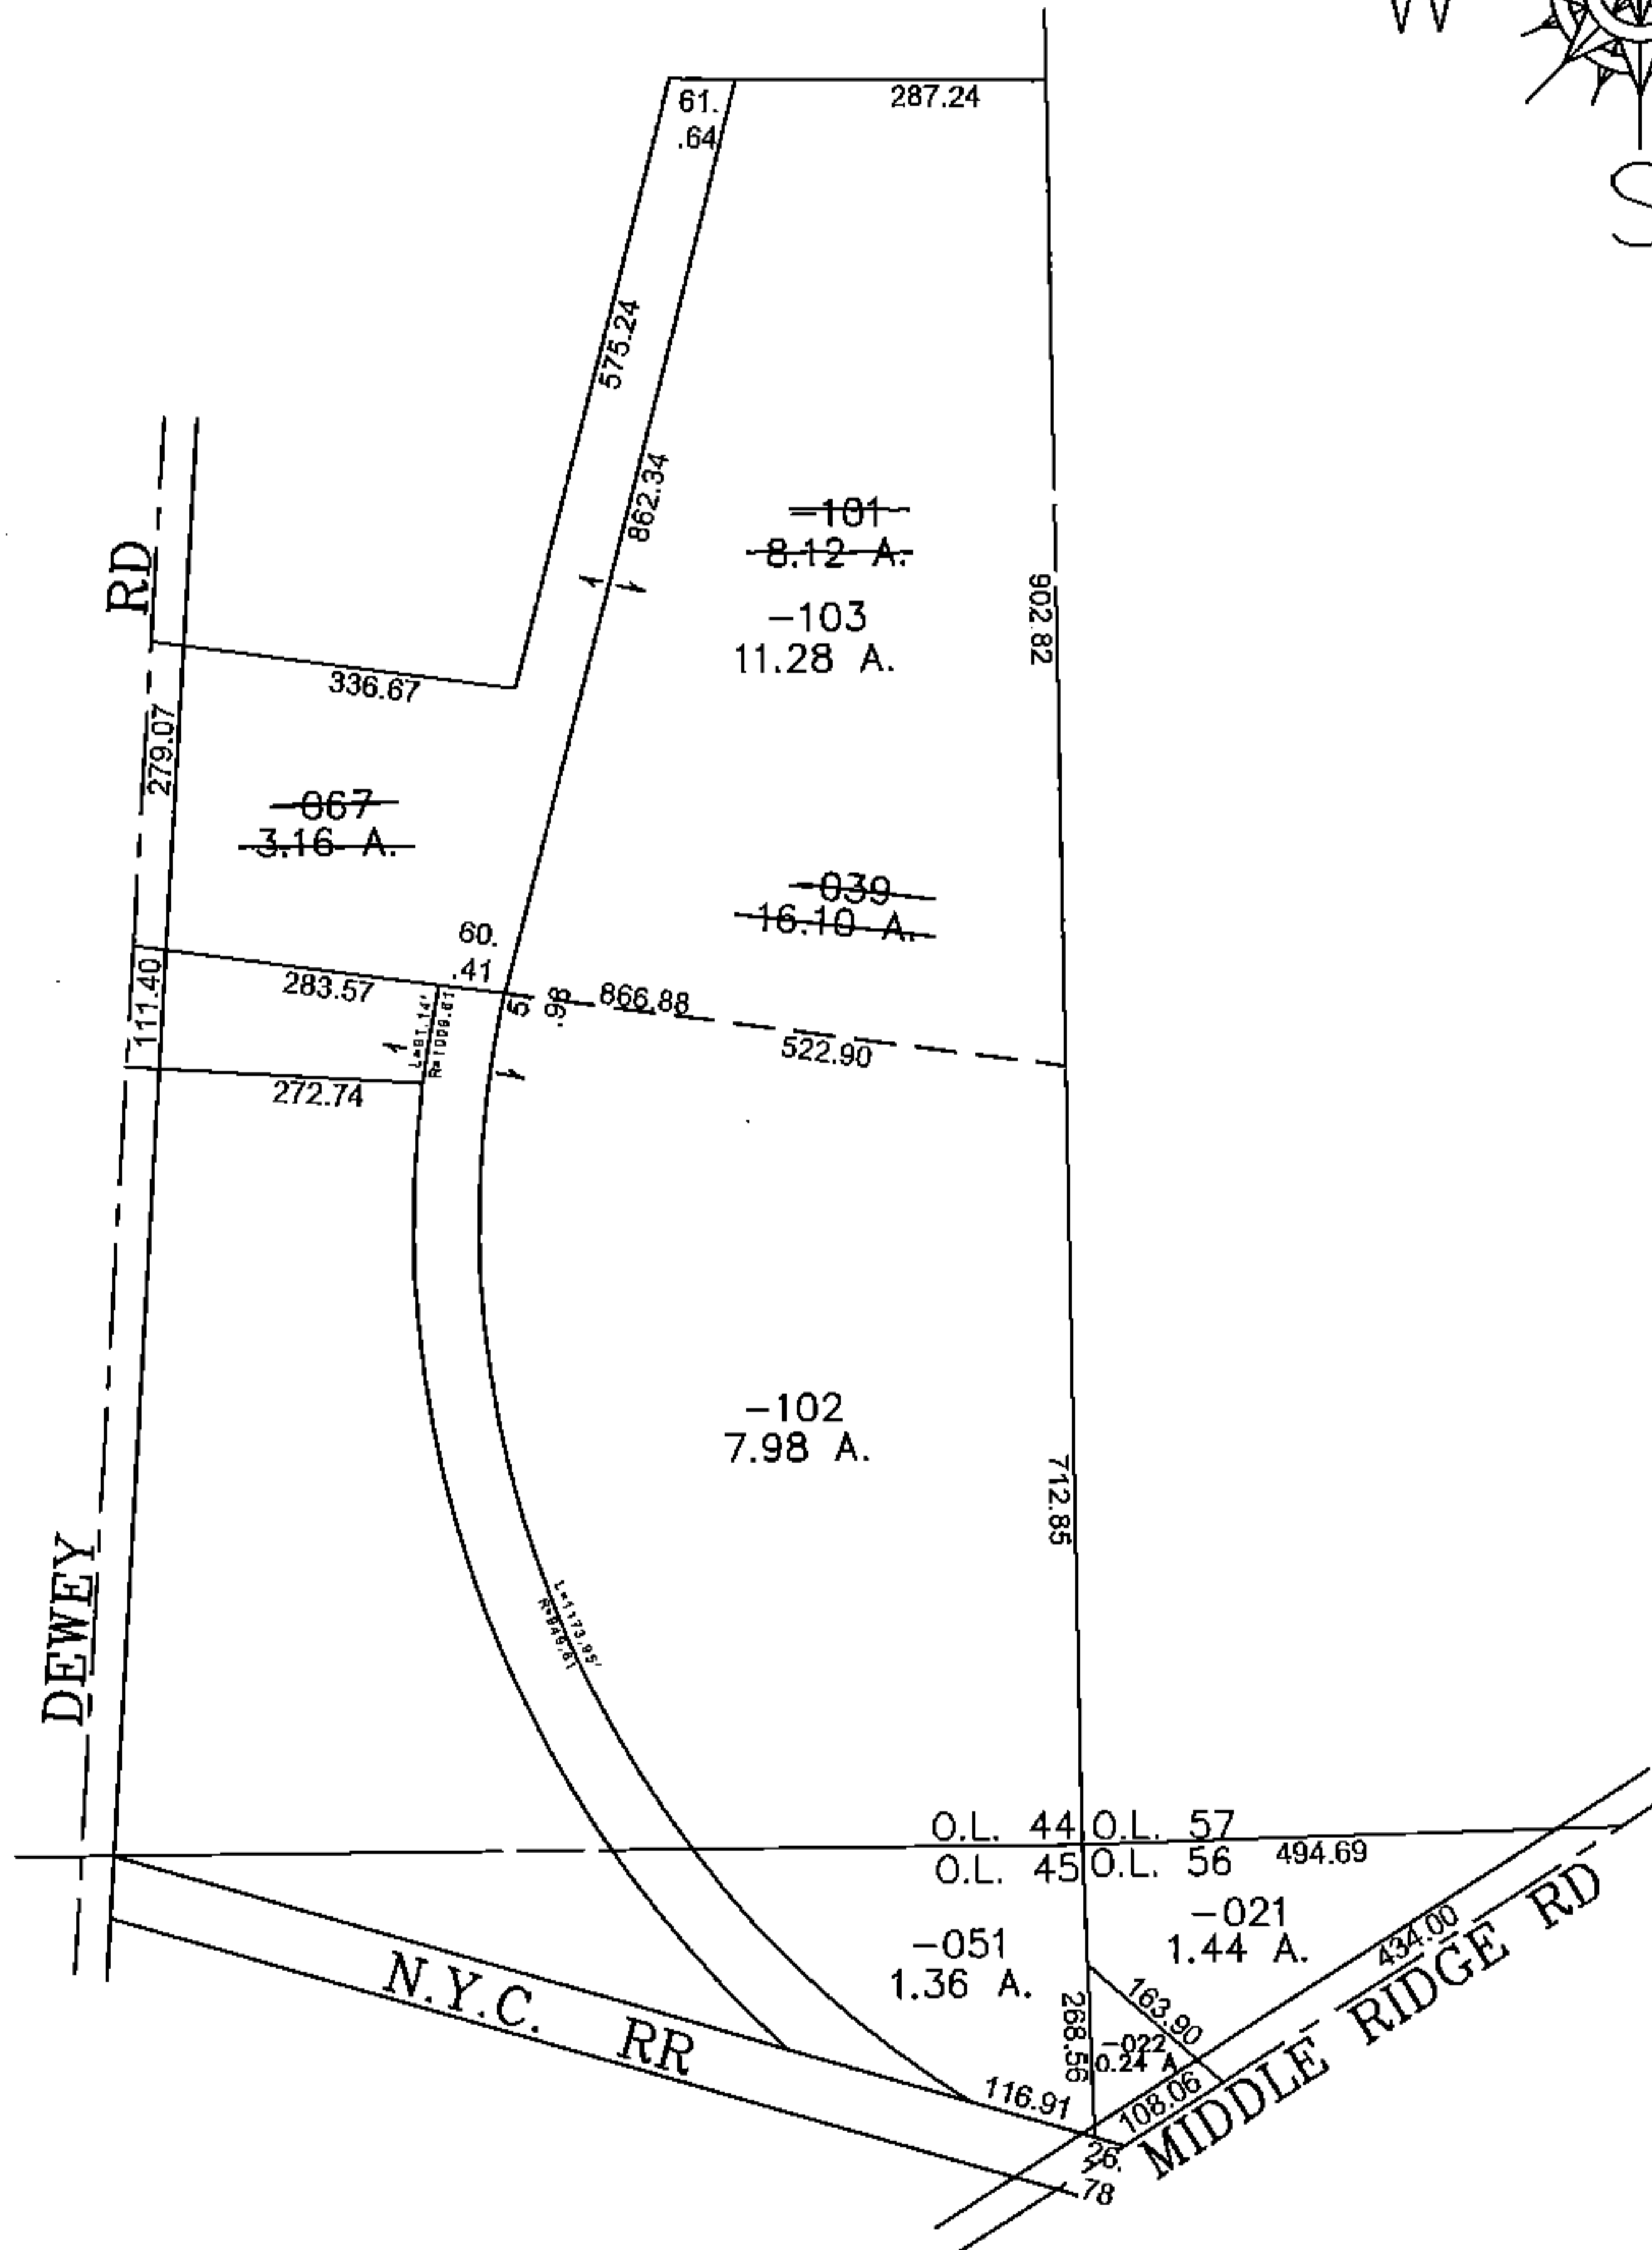


PARENT PARCEL: 05-00-044-000-039, -067
 CHILD PARCEL: 05-00-044-000-101, -102, -103
 STARTING POINT: SOUTHEASTERLY CORNER OF ORIGINAL LOT 44 & 45

15-03459

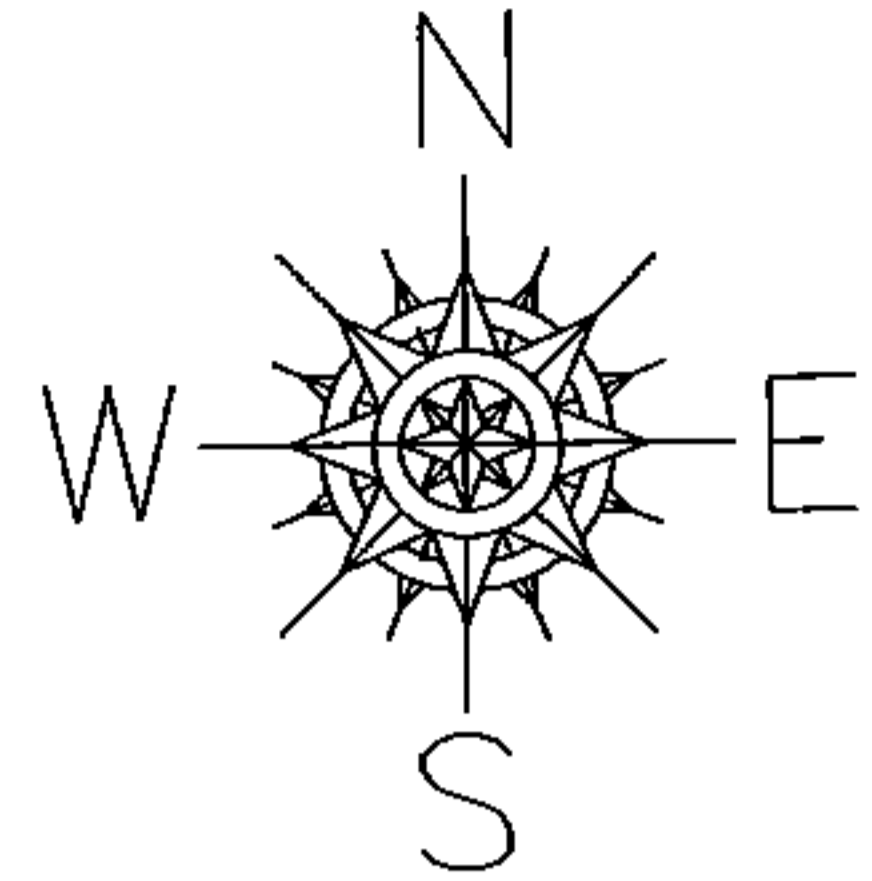

SPLITS/DEEDS PROCESSED
 LORAIN COUNTY TAX MAP DEPARTMENT
 226 MIDDLE AVE. ELYRIA, OHIO

SURVEYED BY: THOMAS SIMON
 CLOSURE: 0.00 : 10.000
 MAP PAGE(S): 05-00-044
 APPROVED BY: JAH DATE: 12/18/2015
 SCALE: 1" = 300 PRIOR INSTRUMENT: 20120410831