

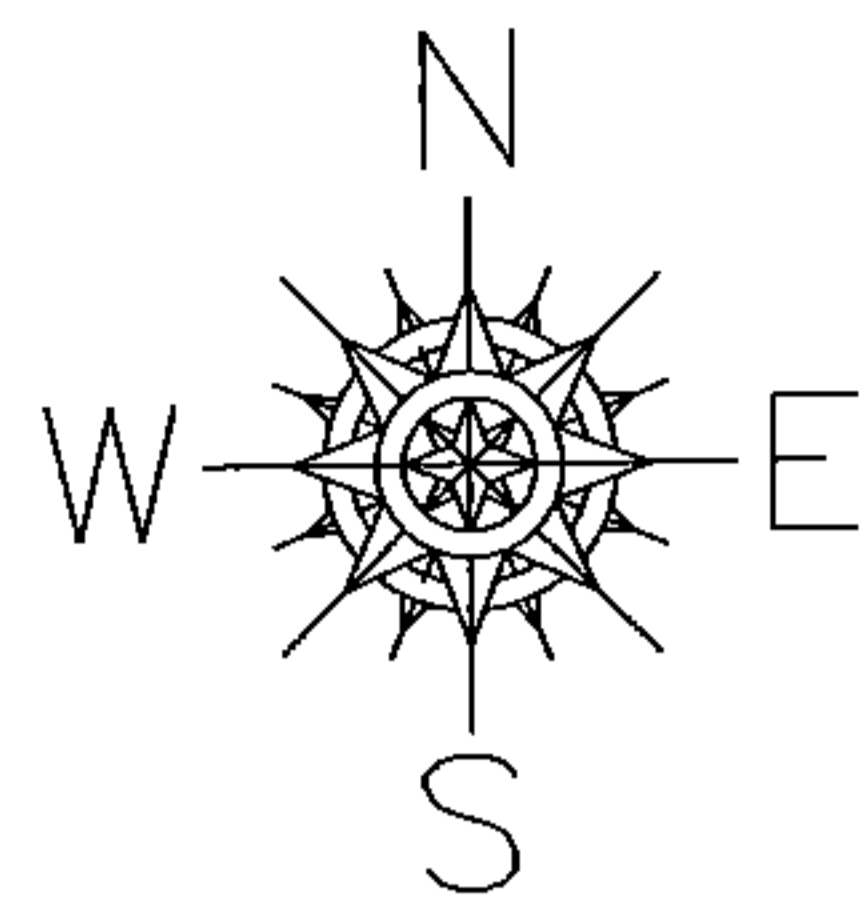


PARENT PARCEL: 19-04-001-000-011, -020  
CHILD PARCEL: 19-04-001-000-041, -042, -043  
STARTING POINT: NORTHWEST CORNER OF ORIGINAL LOT 1 TR 4 & O.L. 2

15-03460

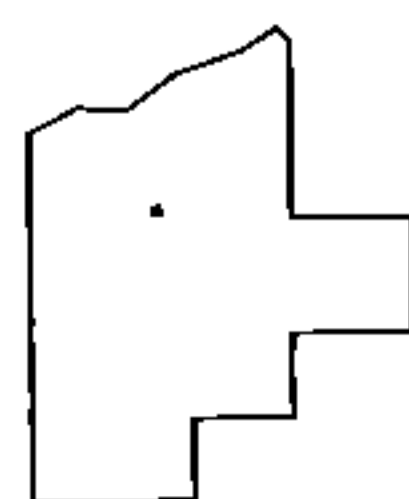

TR 5 O.L. 10  
TR 4 O.L. 2 | TR 4 O.L. 1

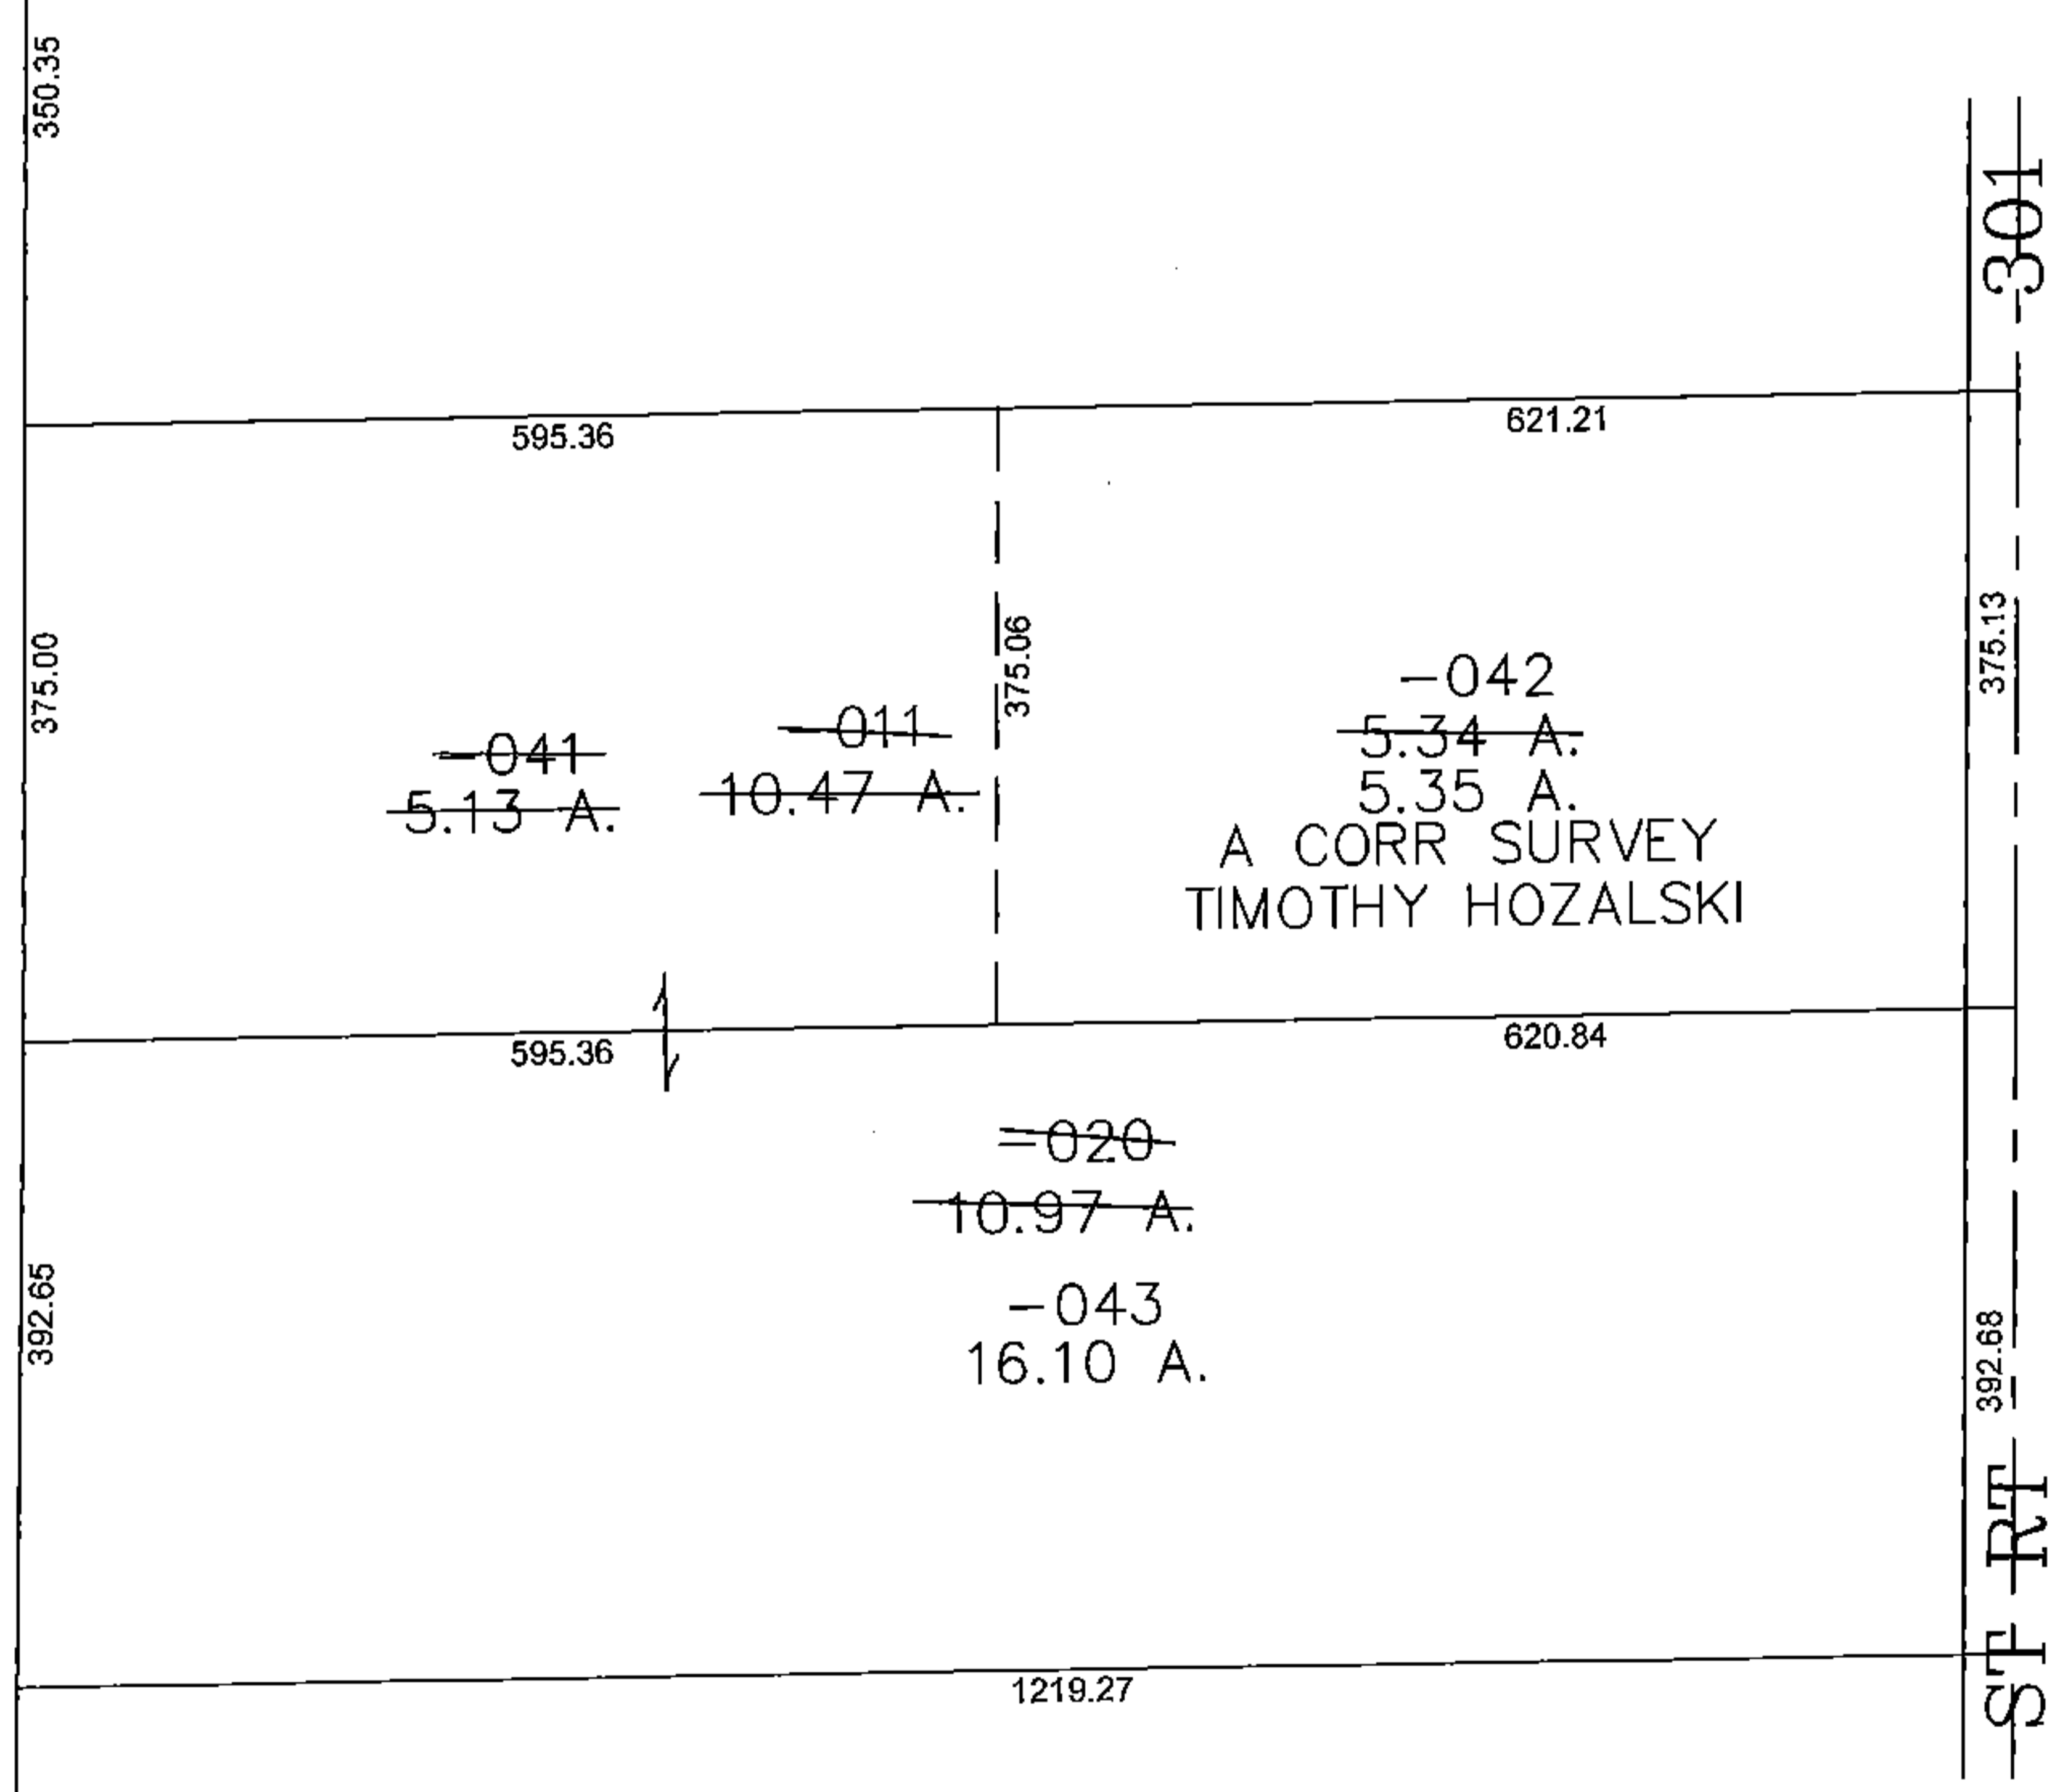

**SPLITS/DEEDS PROCESSED**  
LORAIN COUNTY TAX MAP DEPARTMENT  
226 MIDDLE AVE. ELYRIA, OHIO

SURVEYED BY: TIMOTHY HOZALSKI  
CLOSURE: 0.00 : 10.000  
MAP PAGE(S): 19-B  
APPROVED BY: JAH DATE: 12/18/2015  
SCALE: 1" = 200 PRIOR INSTRUMENT: DV 1328/565