
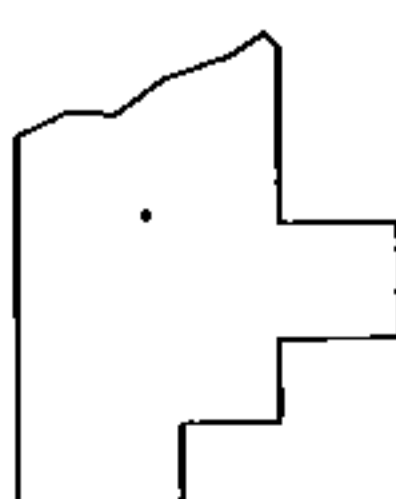
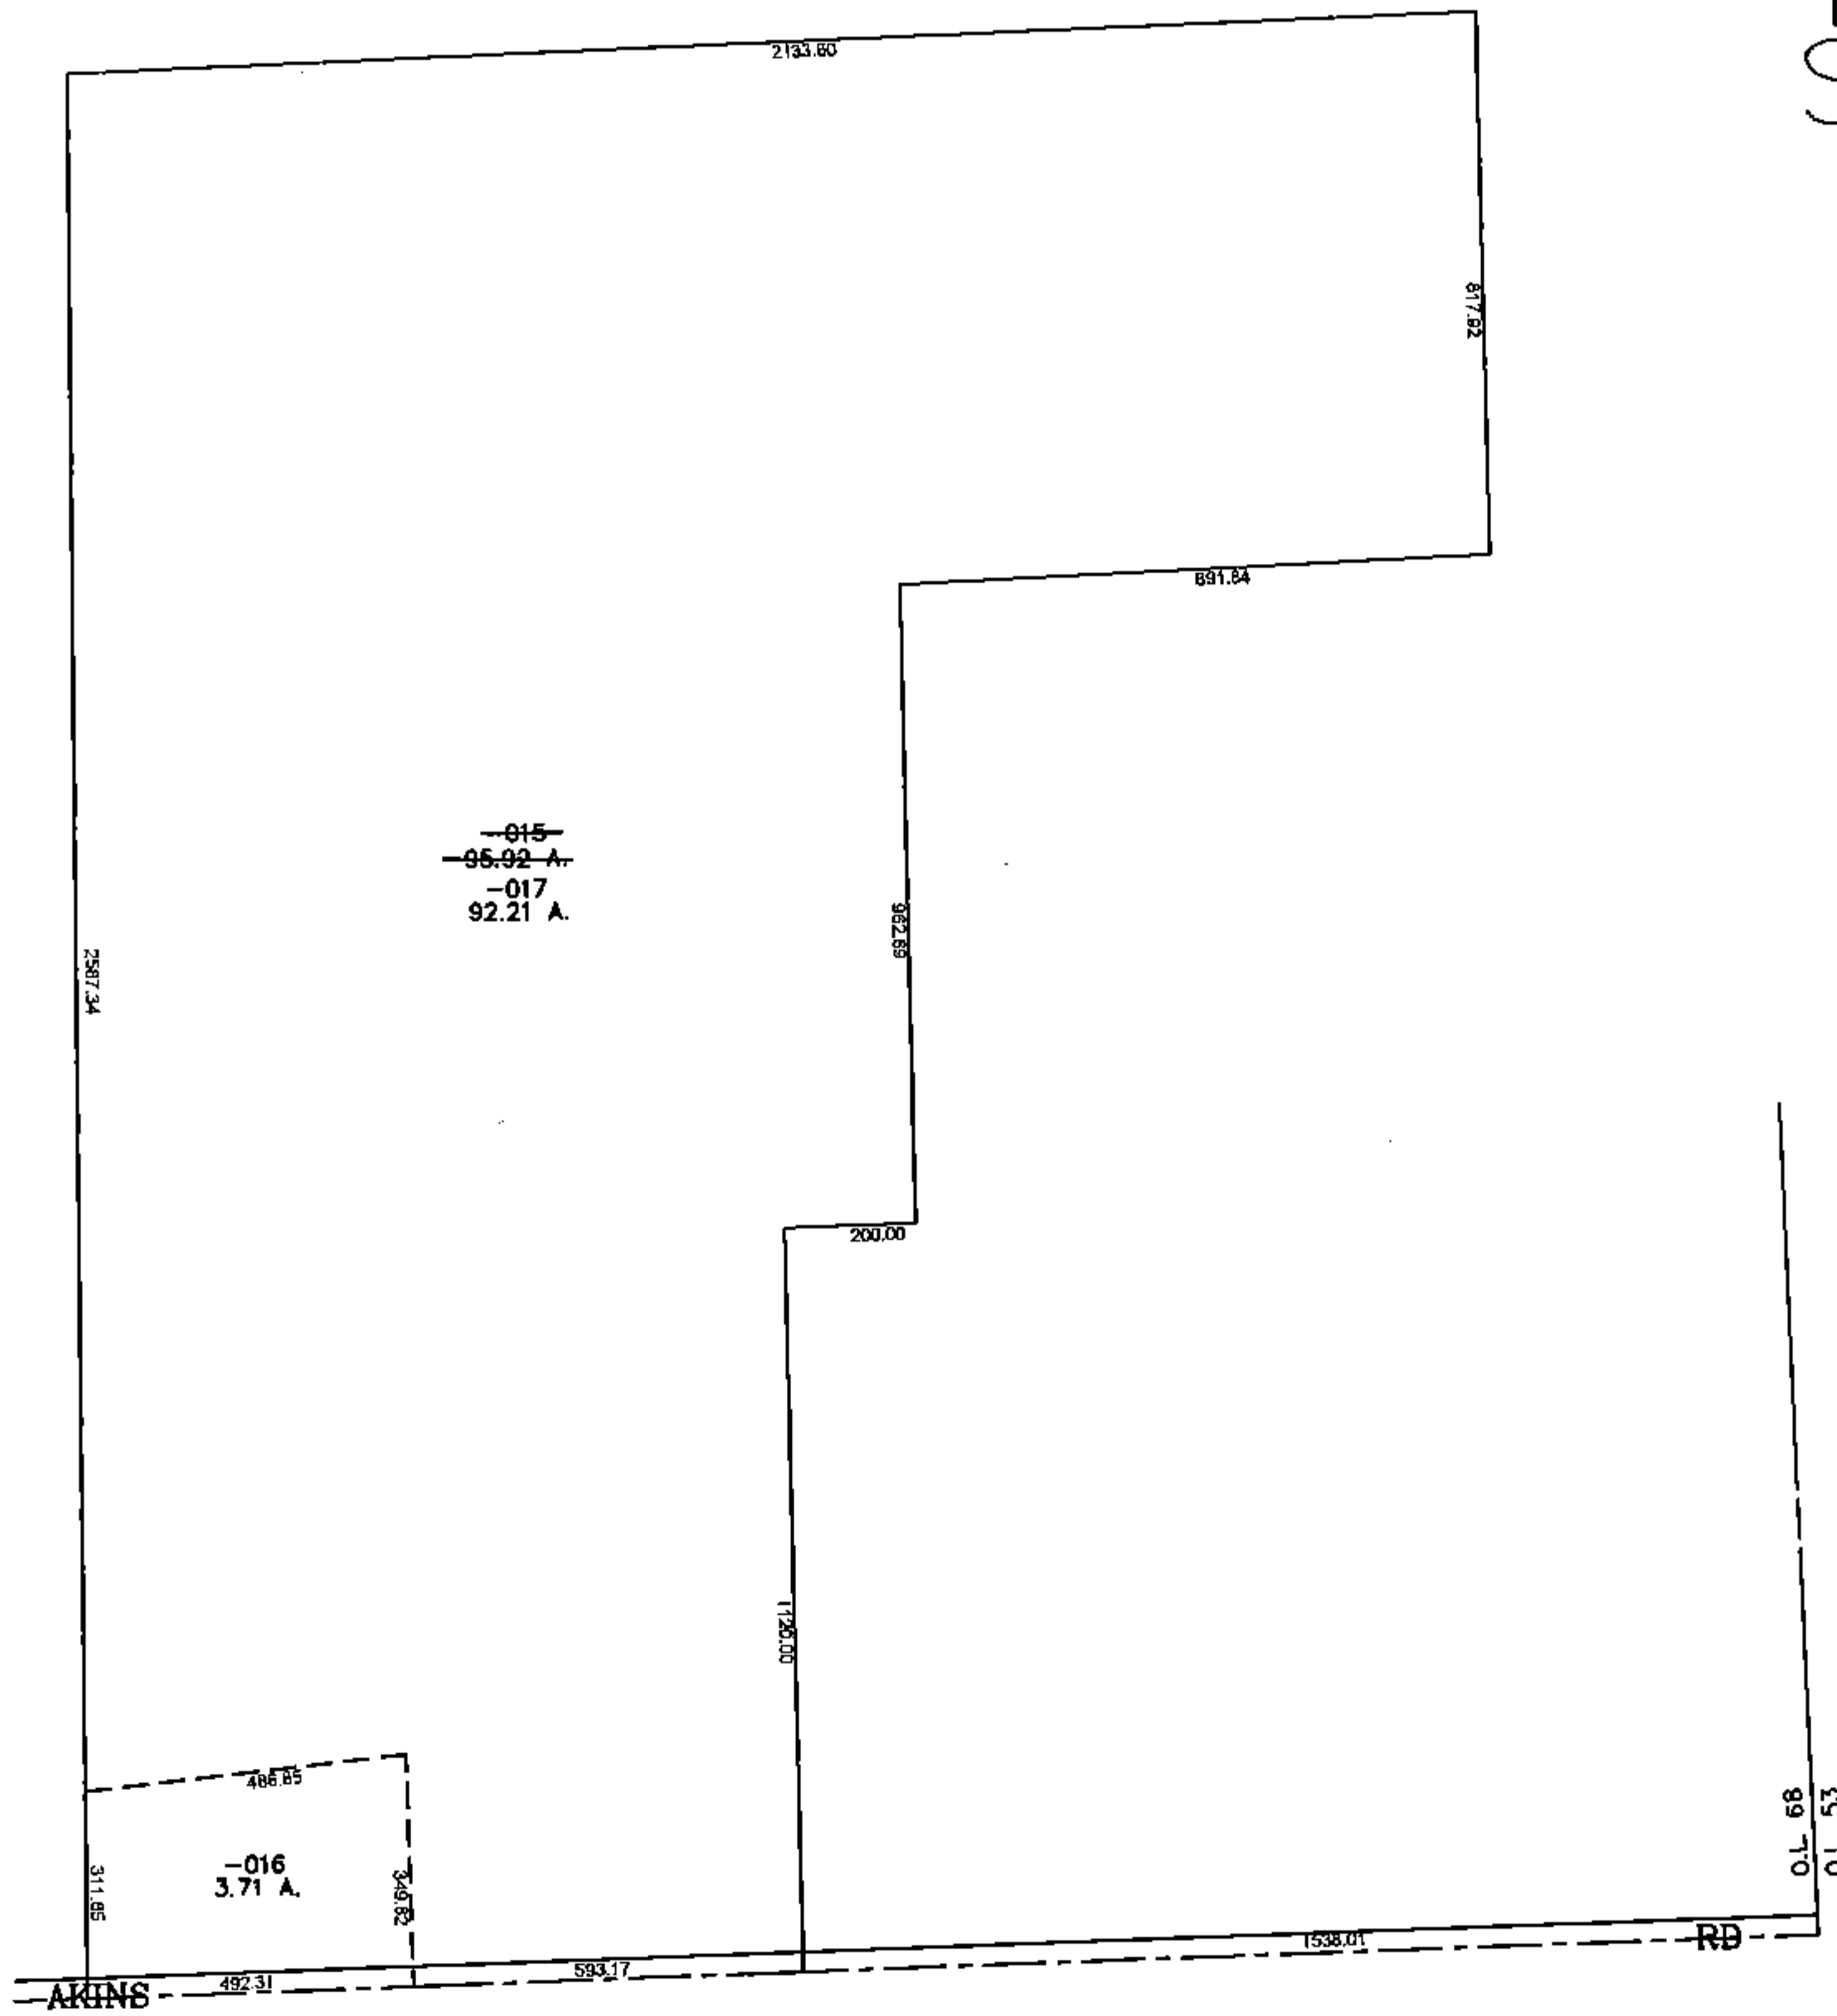


PARENT PARCEL: 12-00-068-000-015

CHILD PARCEL: 12-00-068-000-016, -017

STARTING POINT: CENTERLINE OF AKINS RD & O.L. 68

15-03461

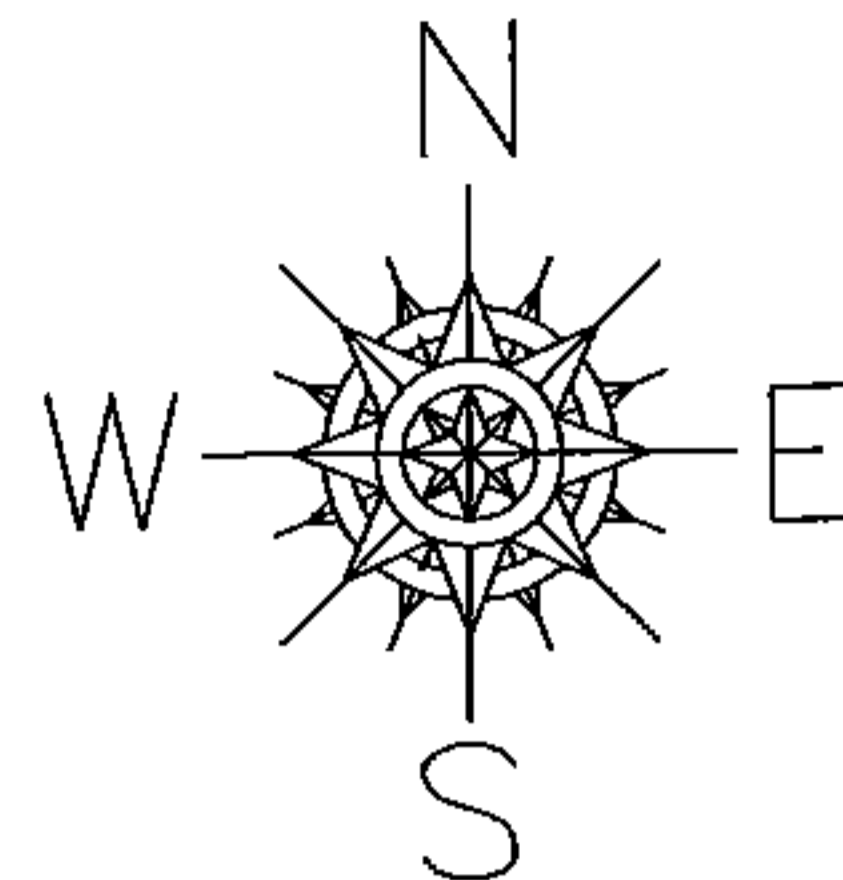

SPLITS/DEEDS PROCESSED

LORAIN COUNTY TAX MAP DEPARTMENT  
226 MIDDLE AVE. ELYRIA, OHIO

SURVEYED BY: THOMAS NEFF  
 CLOSURE: 0.00 : 10,000  
 MAP PAGE(S): 12-00-068  
 APPROVED BY: JAH DATE: 12/22/2015  
 SCALE: 1" = 500 PRIOR INSTRUMENT: 20010393580