
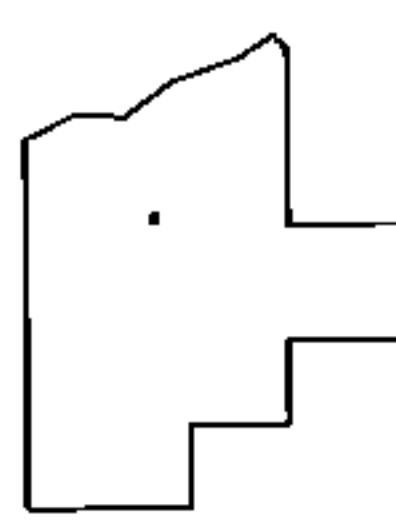
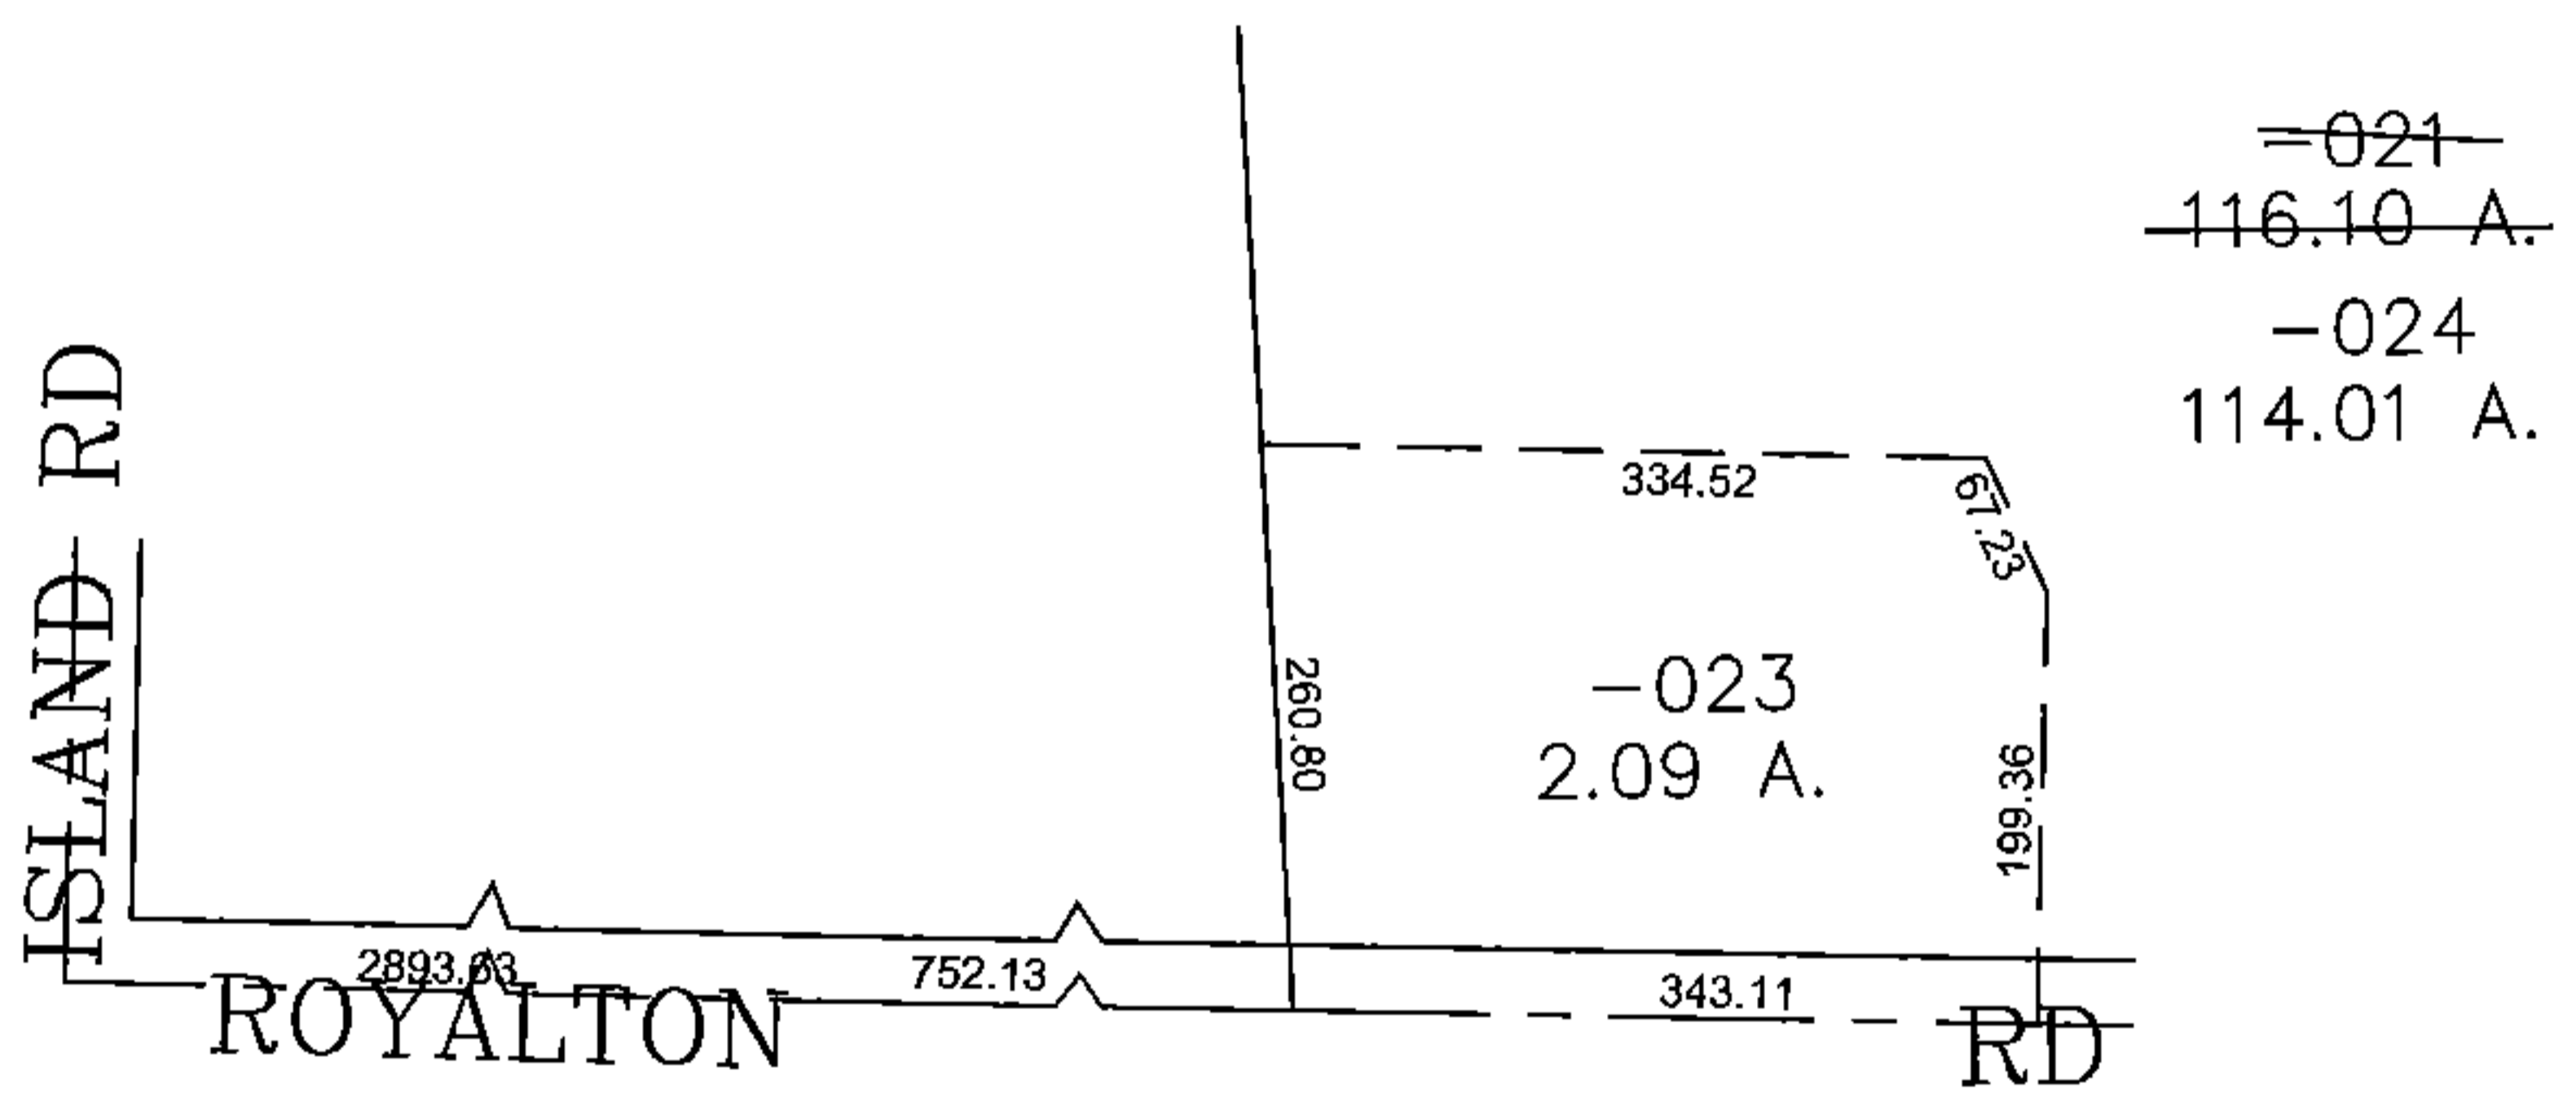


PARENT PARCEL: 11-00-015-000-021

CHILD PARCEL: 11-00-015-000-023, -024

STARTING POINT: CENTERLINE OF ROYALTON RD & ISLAND RD

15-03463

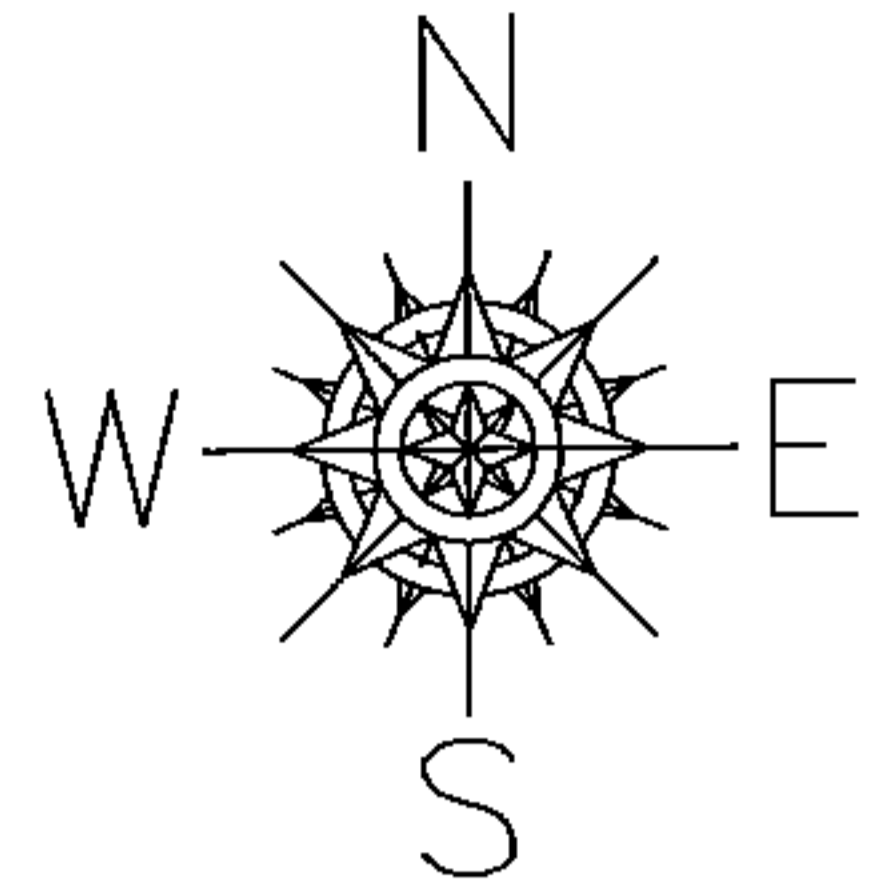

SPLITS/DEEDS PROCESSED
 LORAIN COUNTY TAX MAP DEPARTMENT
 226 MIDDLE AVE. ELYRIA, OHIO

SURVEYED BY: DALE HAYWOOD
 CLOSURE: 0.00 : 10,000
 MAP PAGE(S): 11-00-051
 APPROVED BY: JAH DATE: 12/21/2015
 SCALE: 1" = 200 PRIOR INSTRUMENT: 20050048790