
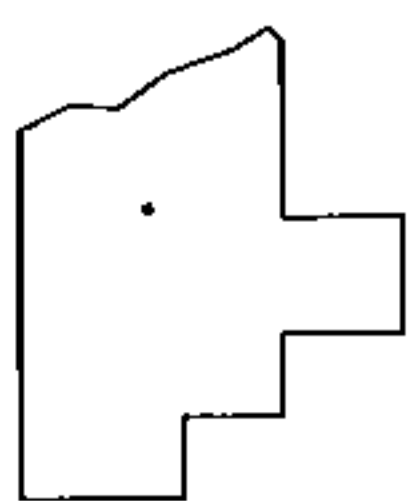
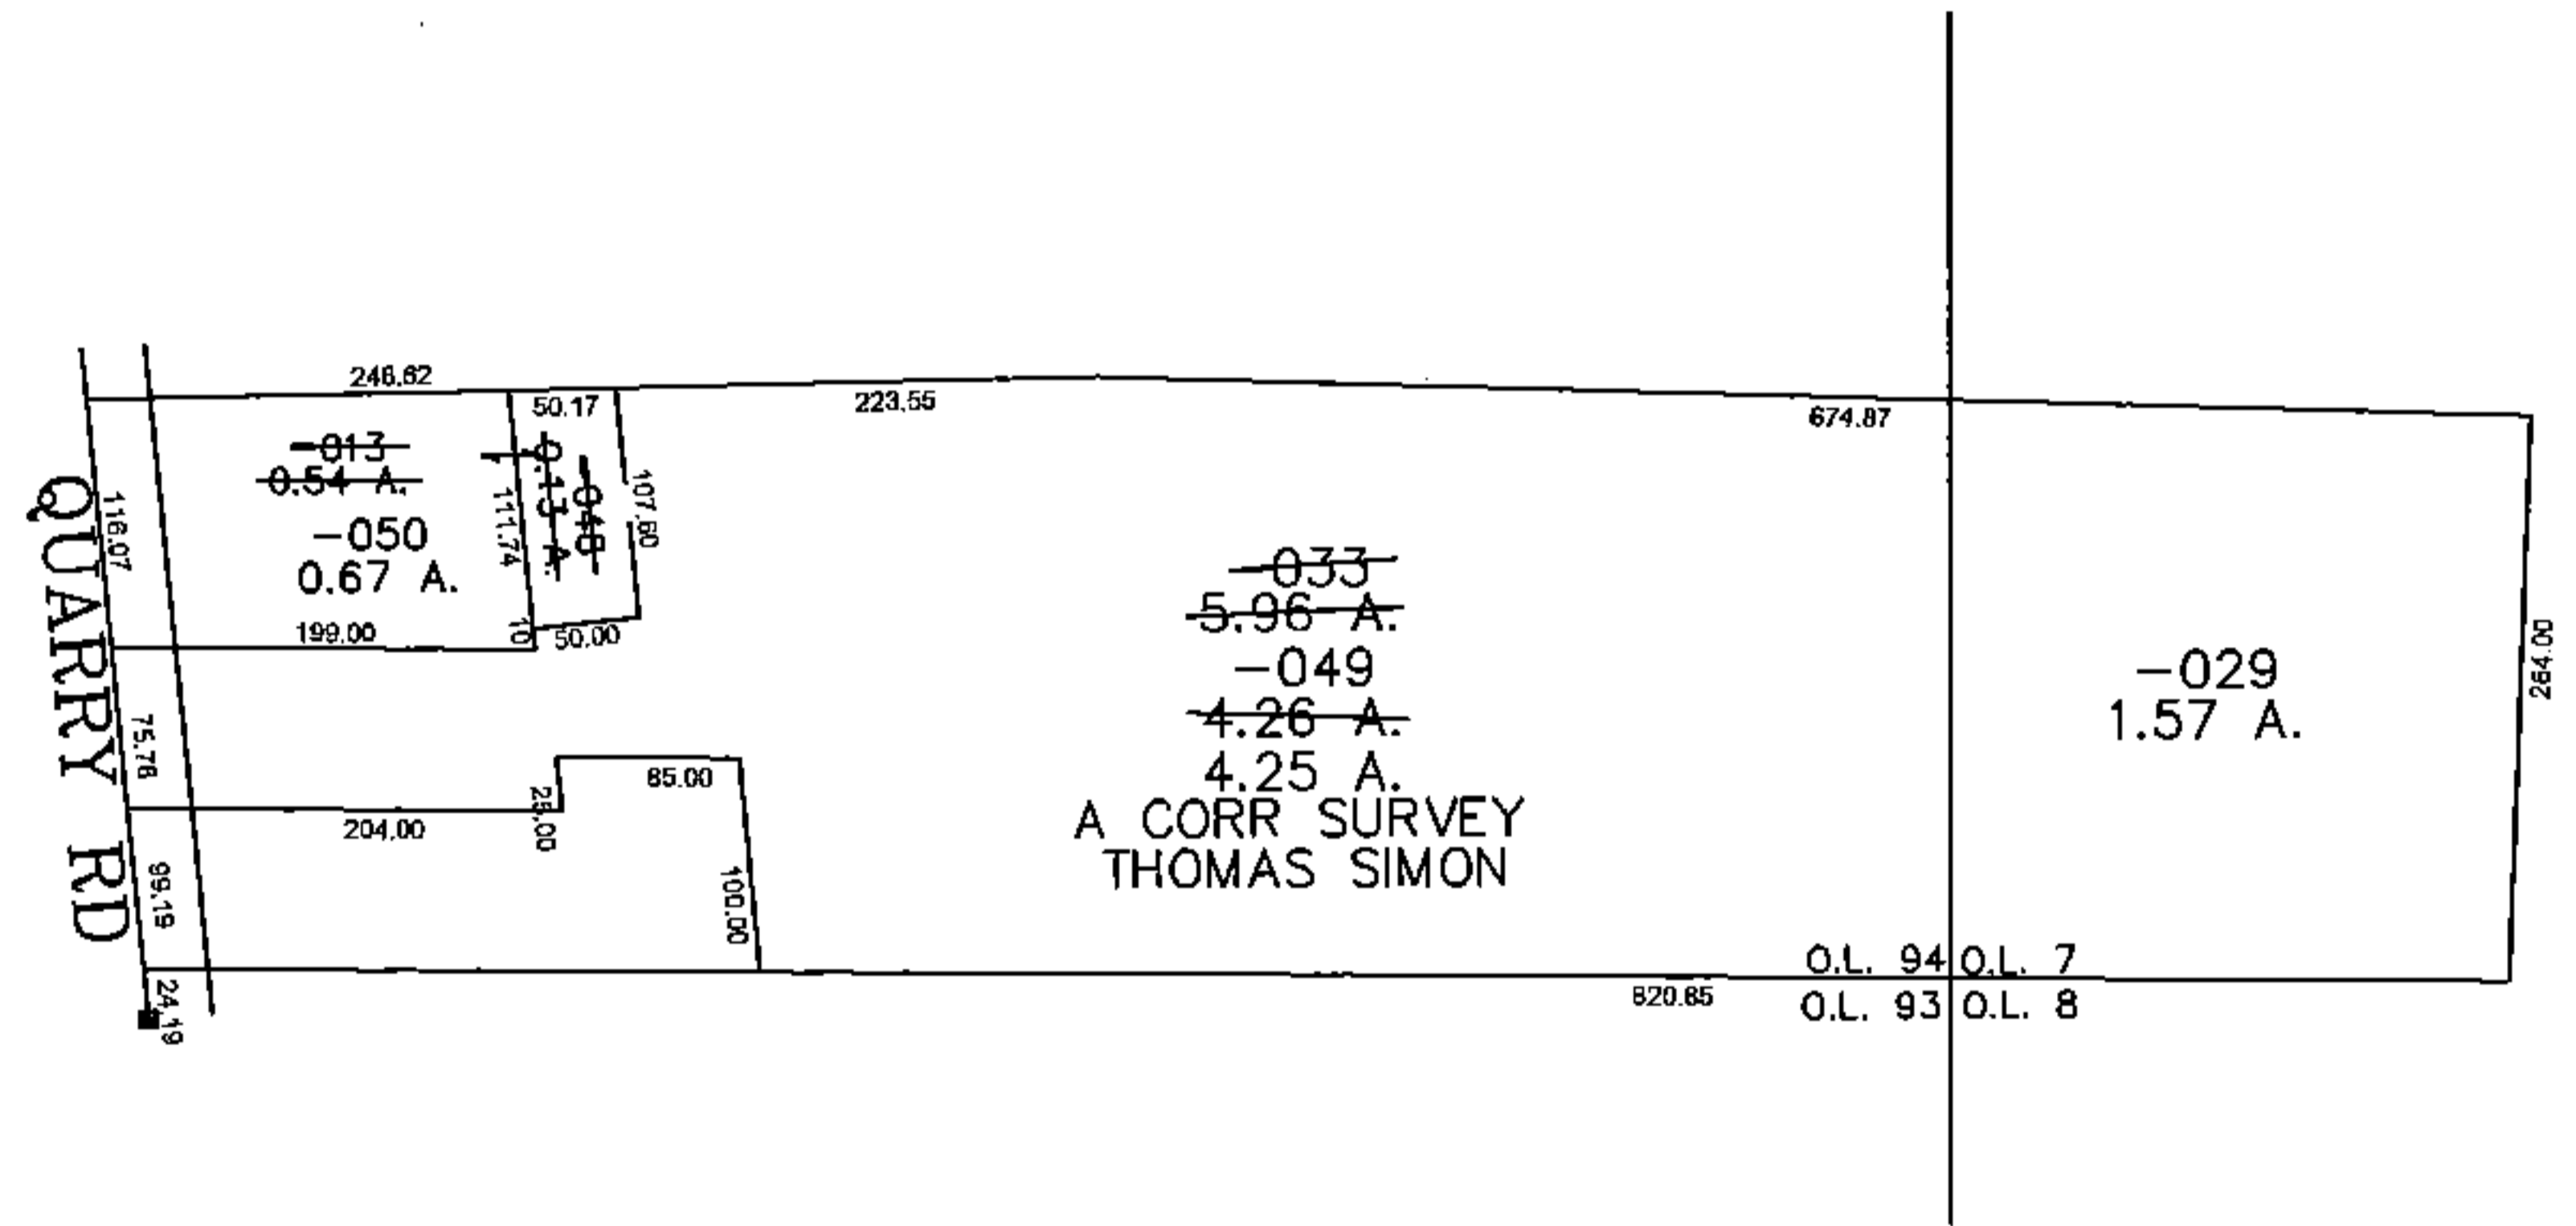


PARENT PARCEL: 05-00-094-105-033, -013
 CHILD PARCEL: 05-00-094-105-048 THRU -050 05-00-007-000-029
 STARTING POINT: CENTERLINE OF QUARRY RD & O.L. 94

15-03464

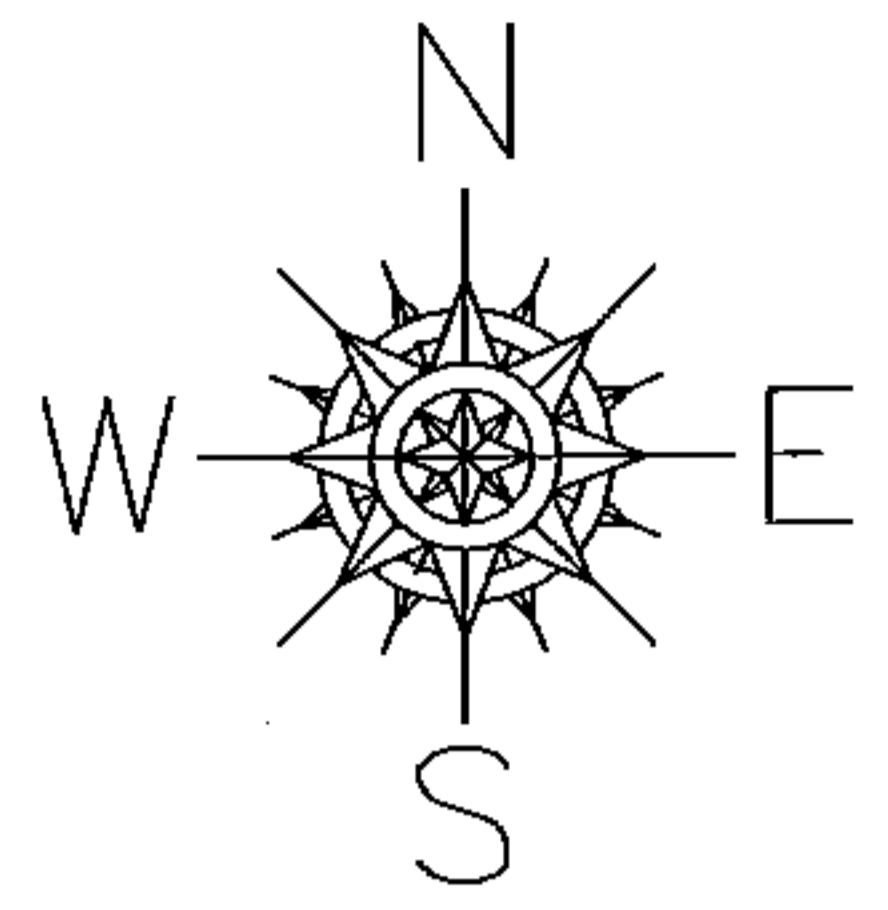

SPLITS/DEEDS PROCESSED
 LORAIN COUNTY TAX MAP DEPARTMENT
 226 MIDDLE AVE. ELYRIA, OHIO

SURVEYED BY: THOMAS SIMON
 CLOSURE: 0.00 : 10,000
 MAP PAGE(S): 05-00-094
 APPROVED BY: JAH DATE: 12/22/2015
 SCALE: 1" = 200 PRIOR INSTRUMENT: 20120408313