
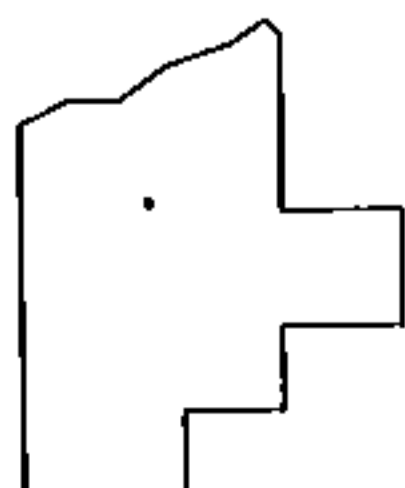
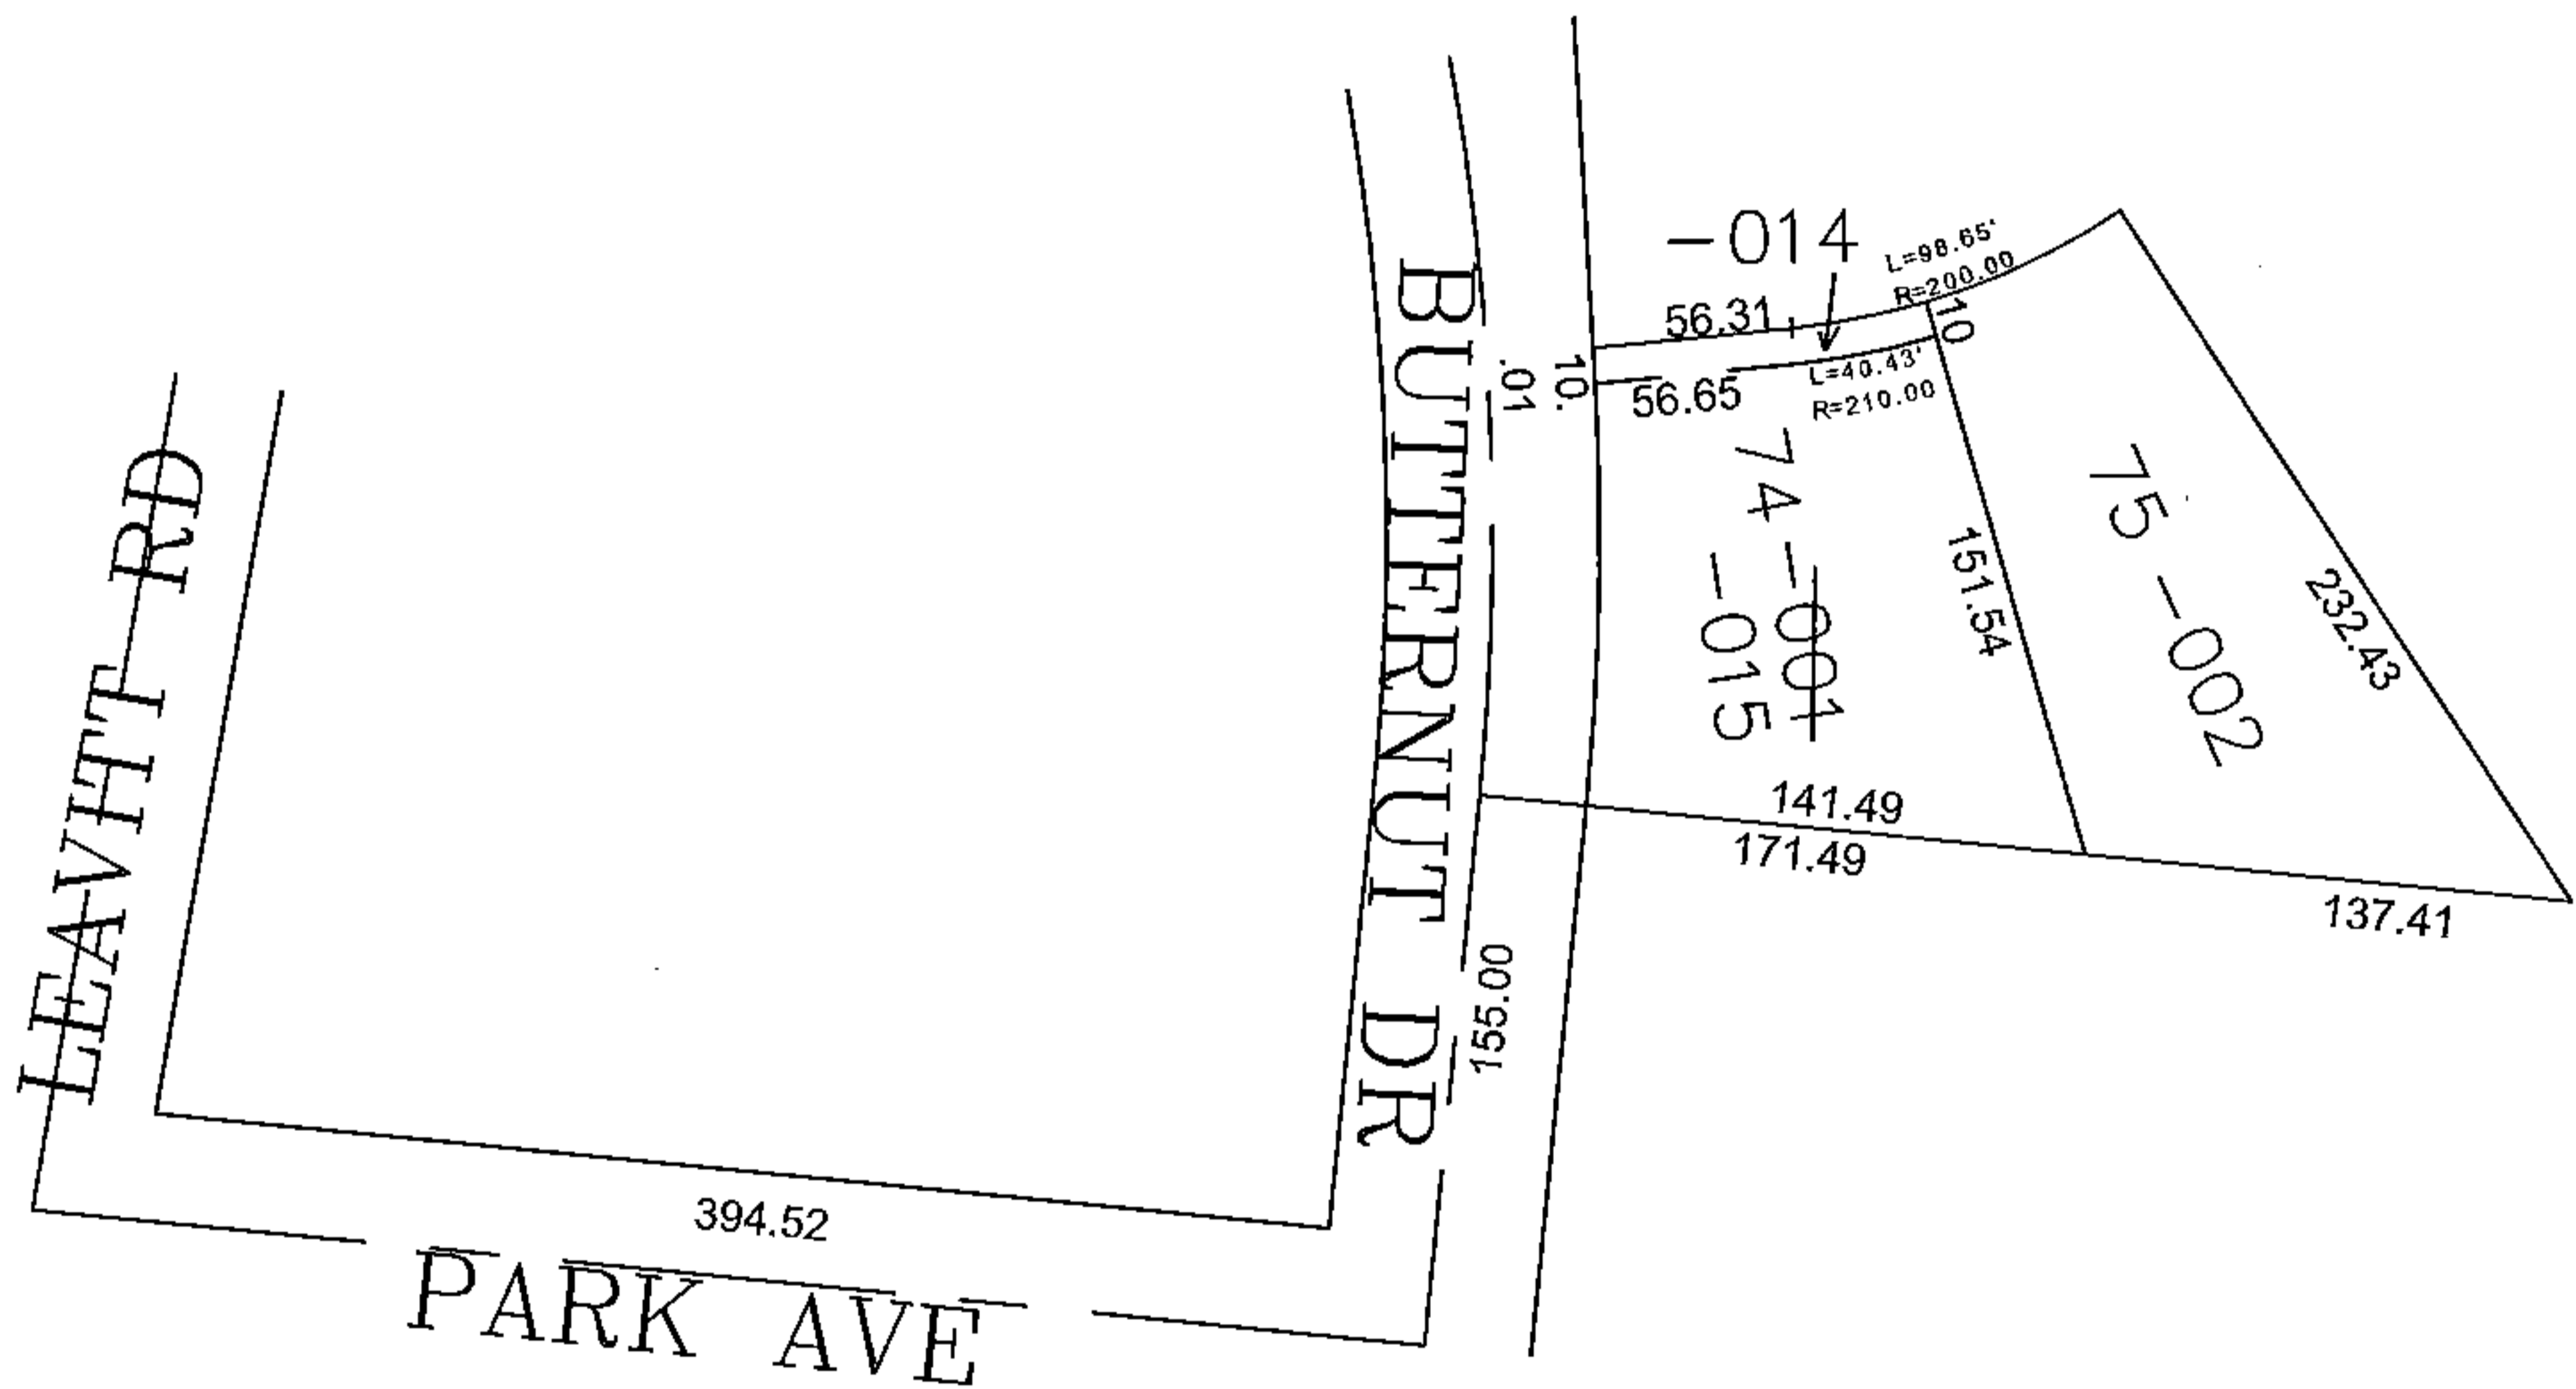


PARENT PARCEL: 05-00-043-106-001, -002
CHILD PARCEL: 05-00-043-106-014, -015
STARTING POINT: CENTERLINE OF LEAVITT RD & PARK AVE

15-03466

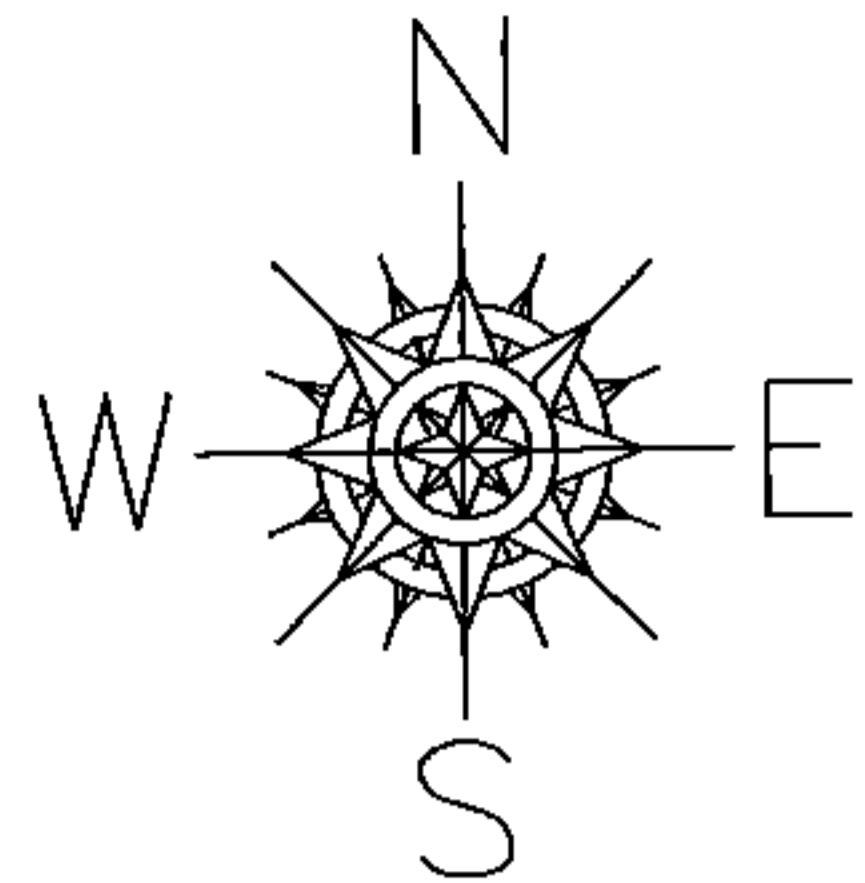

SPLITS/DEEDS PROCESSED

LORAIN COUNTY TAX MAP DEPARTMENT
226 MIDDLE AVE. ELYRIA, OHIO

SURVEYED BY: THOMAS SIMON
CLOSURE: 0.00 : 10.000
MAP PAGE(S): 05-00-043
APPROVED BY: JAH DATE: 12/28/2015
SCALE: 1" = 100 PRIOR INSTRUMENT: 19990625944