
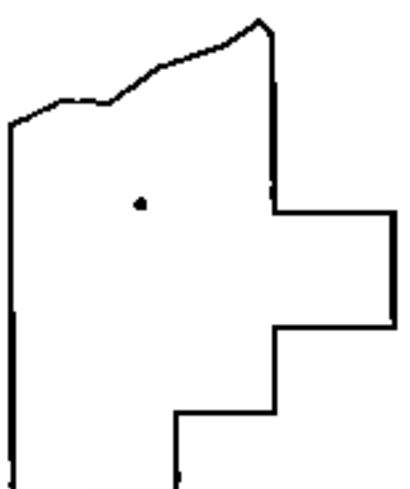
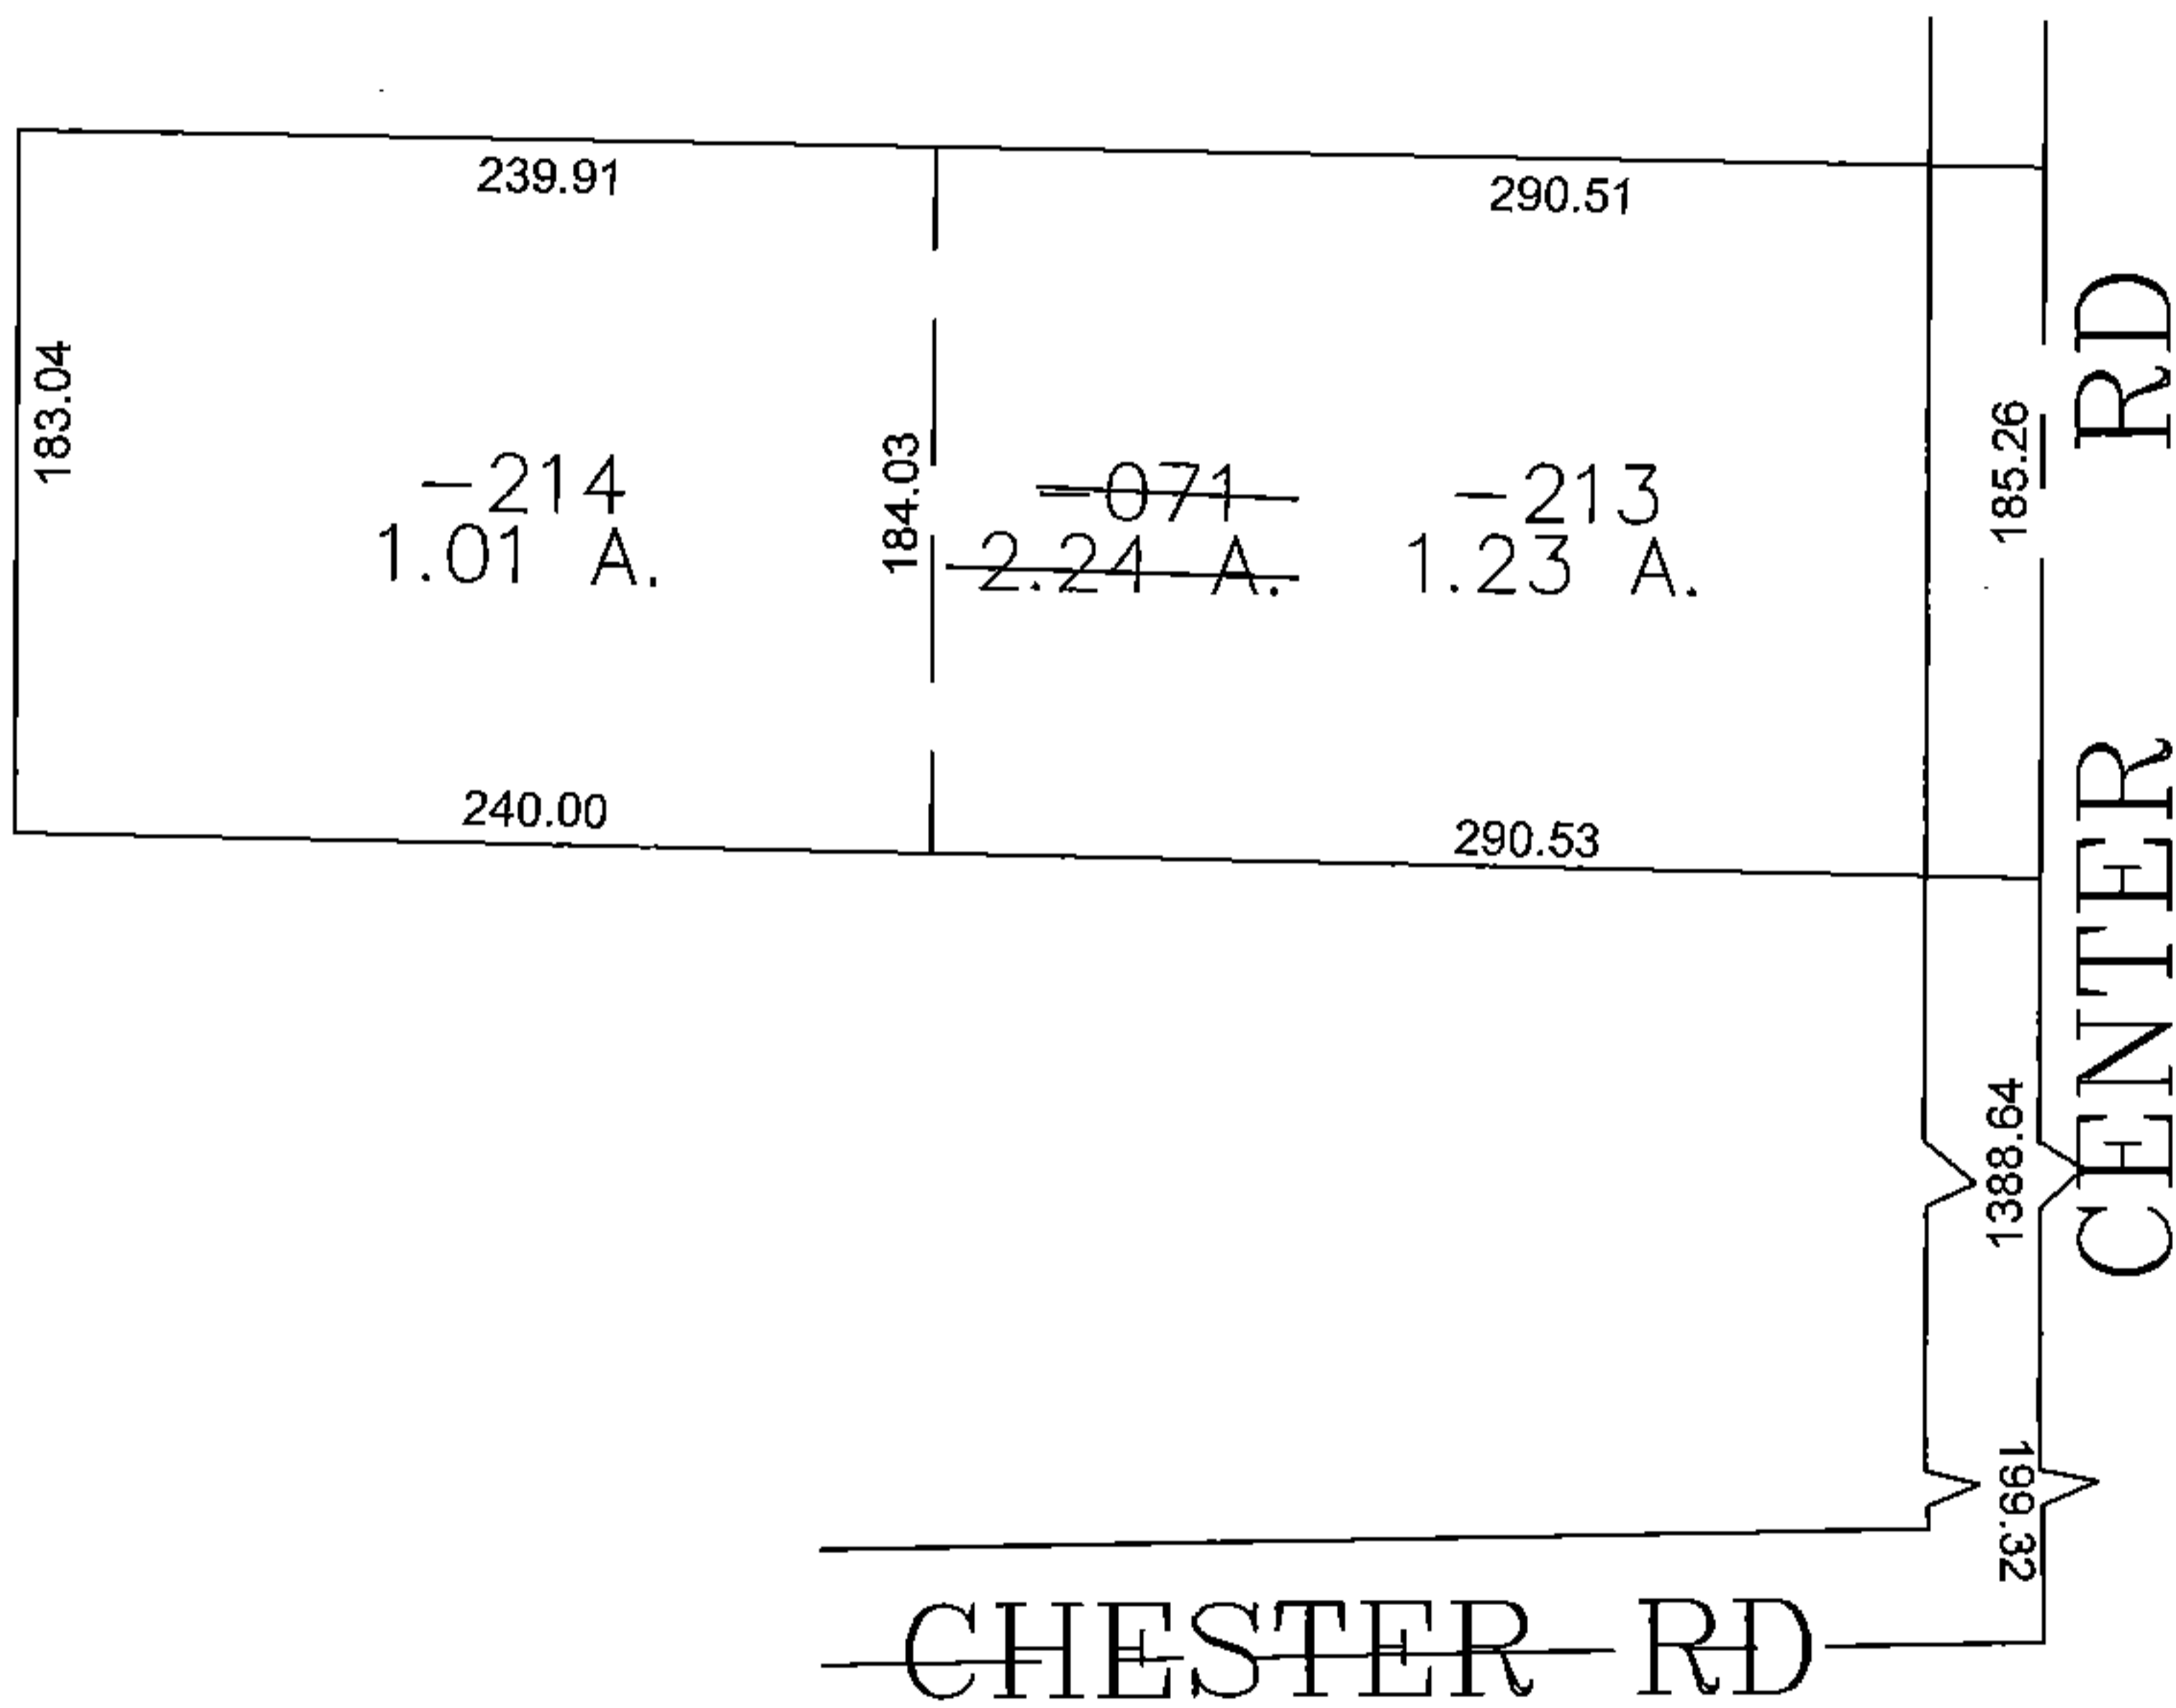


PARENT PARCEL: 04-00-016-101-071

CHILD PARCEL: 04-00-016-101-213, -214

STARTING POINT: CENTERLINE OF CHESTER RD & CENTER RD

16-03468

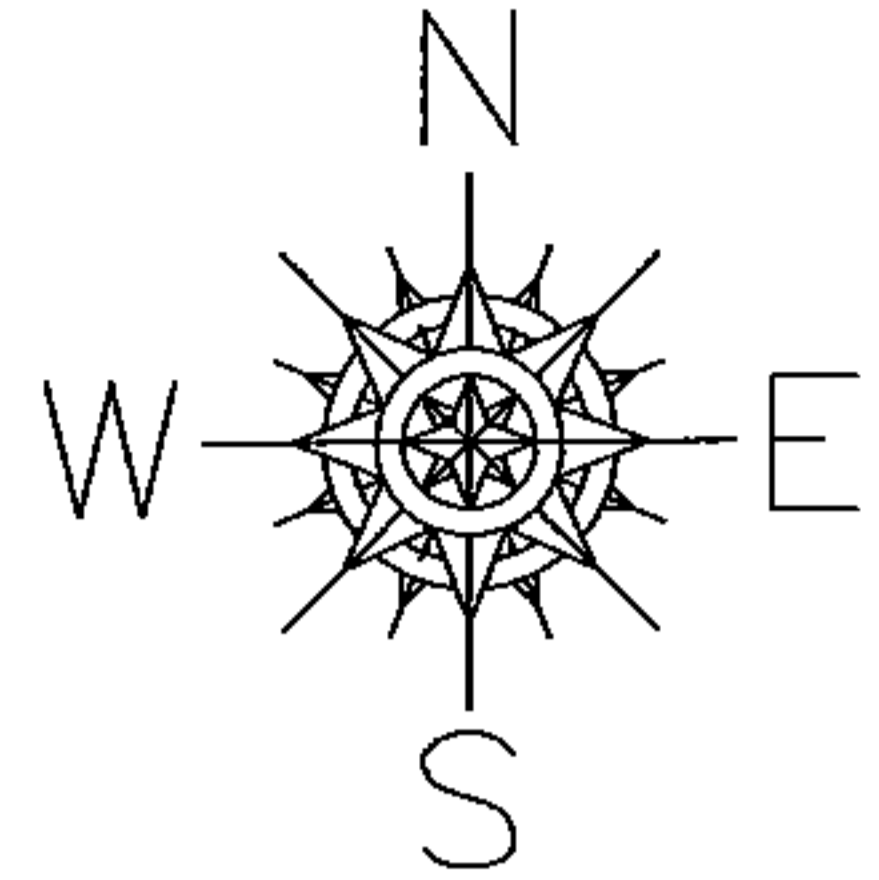

**SPLITS/DEEDS PROCESSED**

LORAIN COUNTY TAX MAP DEPARTMENT  
226 MIDDLE AVE. ELYRIA, OHIO

SURVEYED BY: MICHAEL SPELLACY

CLOSURE: 0.00 : 10.000

MAP PAGE(S): 04-00-016

APPROVED BY: JAH DATE: 1/6/2016

SCALE: 1" = 100 PRIOR INSTRUMENT: 20140522880