
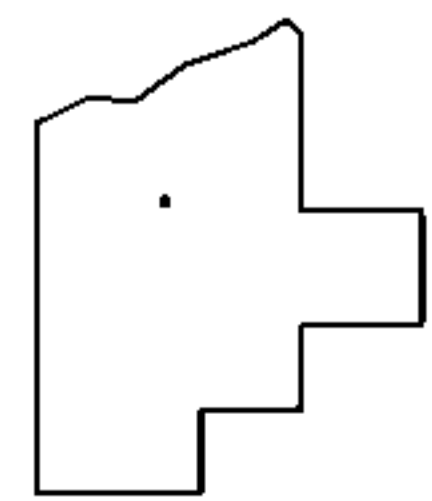
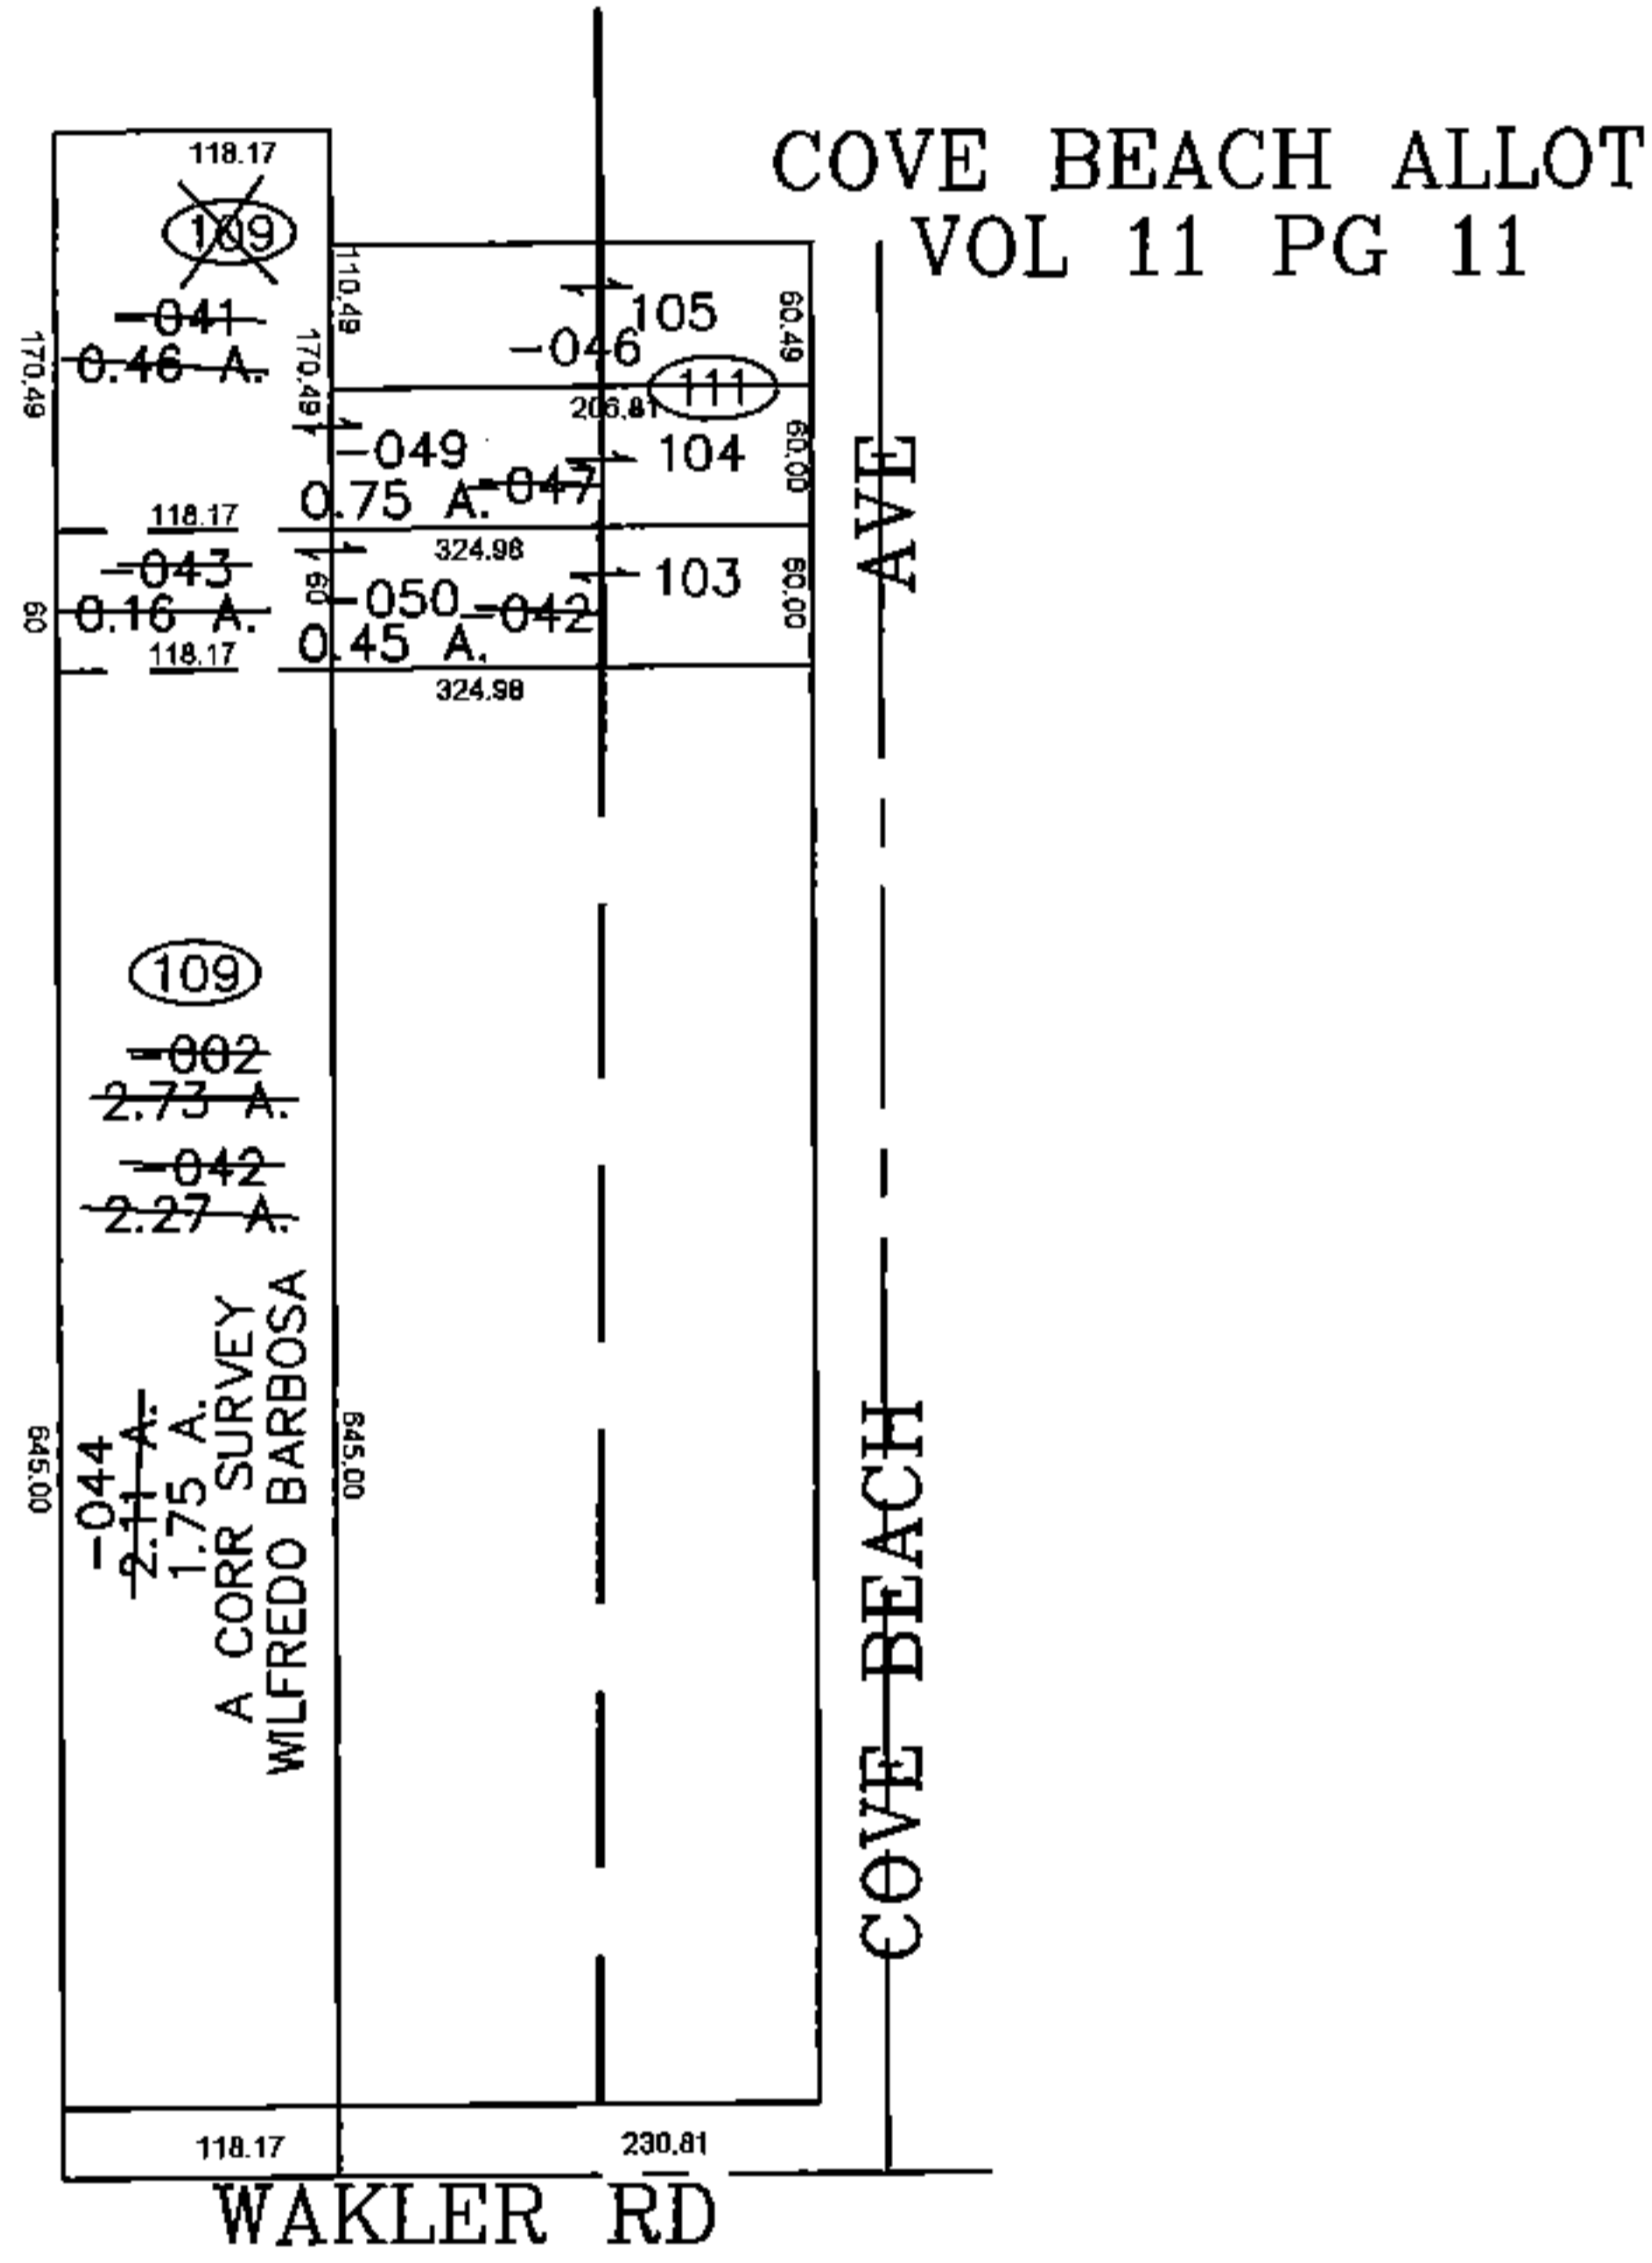


PARENT PARCEL: 03-00-033-109-002, 03-00-033-111-047, -042
 CHILD PARCEL: 03-00-033-109-041 THRU -044, 03-00-033-111-049, -050
 STARTING POINT: CENTERLINE OF WALKER RD & COVE BEACH AVE

16-03469

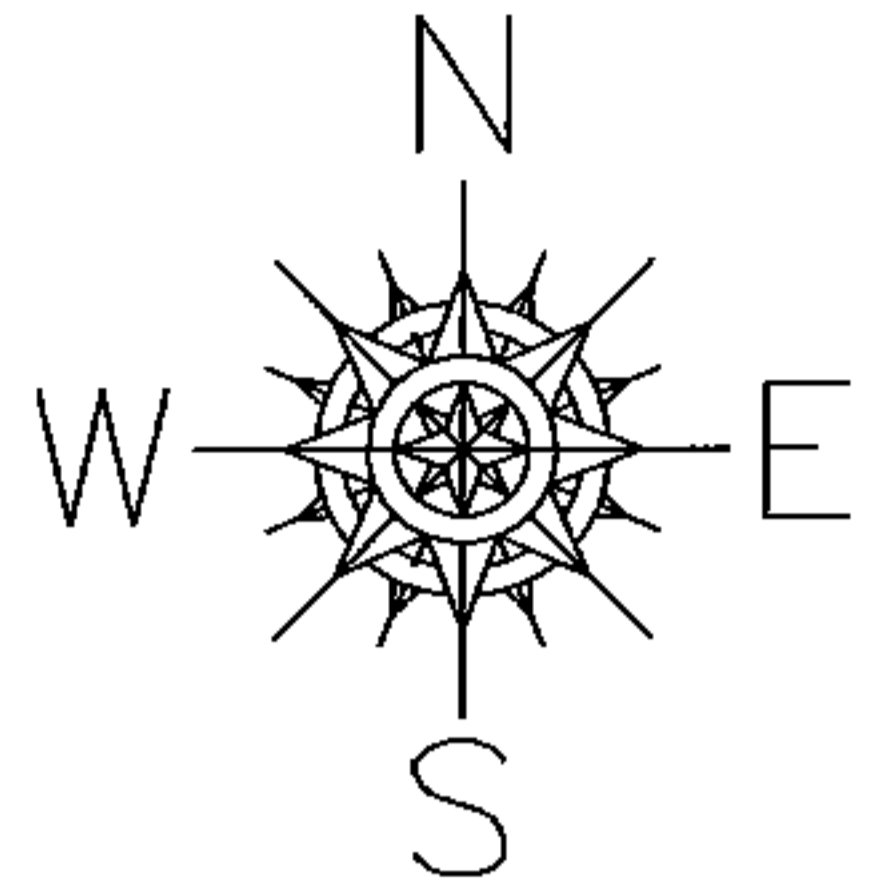

SPLITS/DEEDS PROCESSED
 LORAIN COUNTY TAX MAP DEPARTMENT
 226 MIDDLE AVE. ELYRIA, OHIO

SURVEYED BY: WILFREDO BARBOSA
 CLOSURE: 0.00 : 10,000
 MAP PAGE(S): 03-00-033
 APPROVED BY: JAH DATE: 1/7/2016
 SCALE: 1" = 200 PRIOR INSTRUMENT: 20020829033