
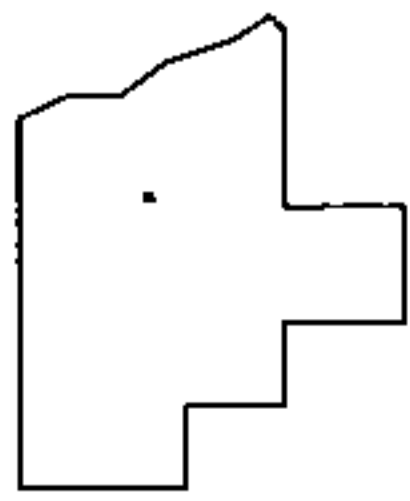
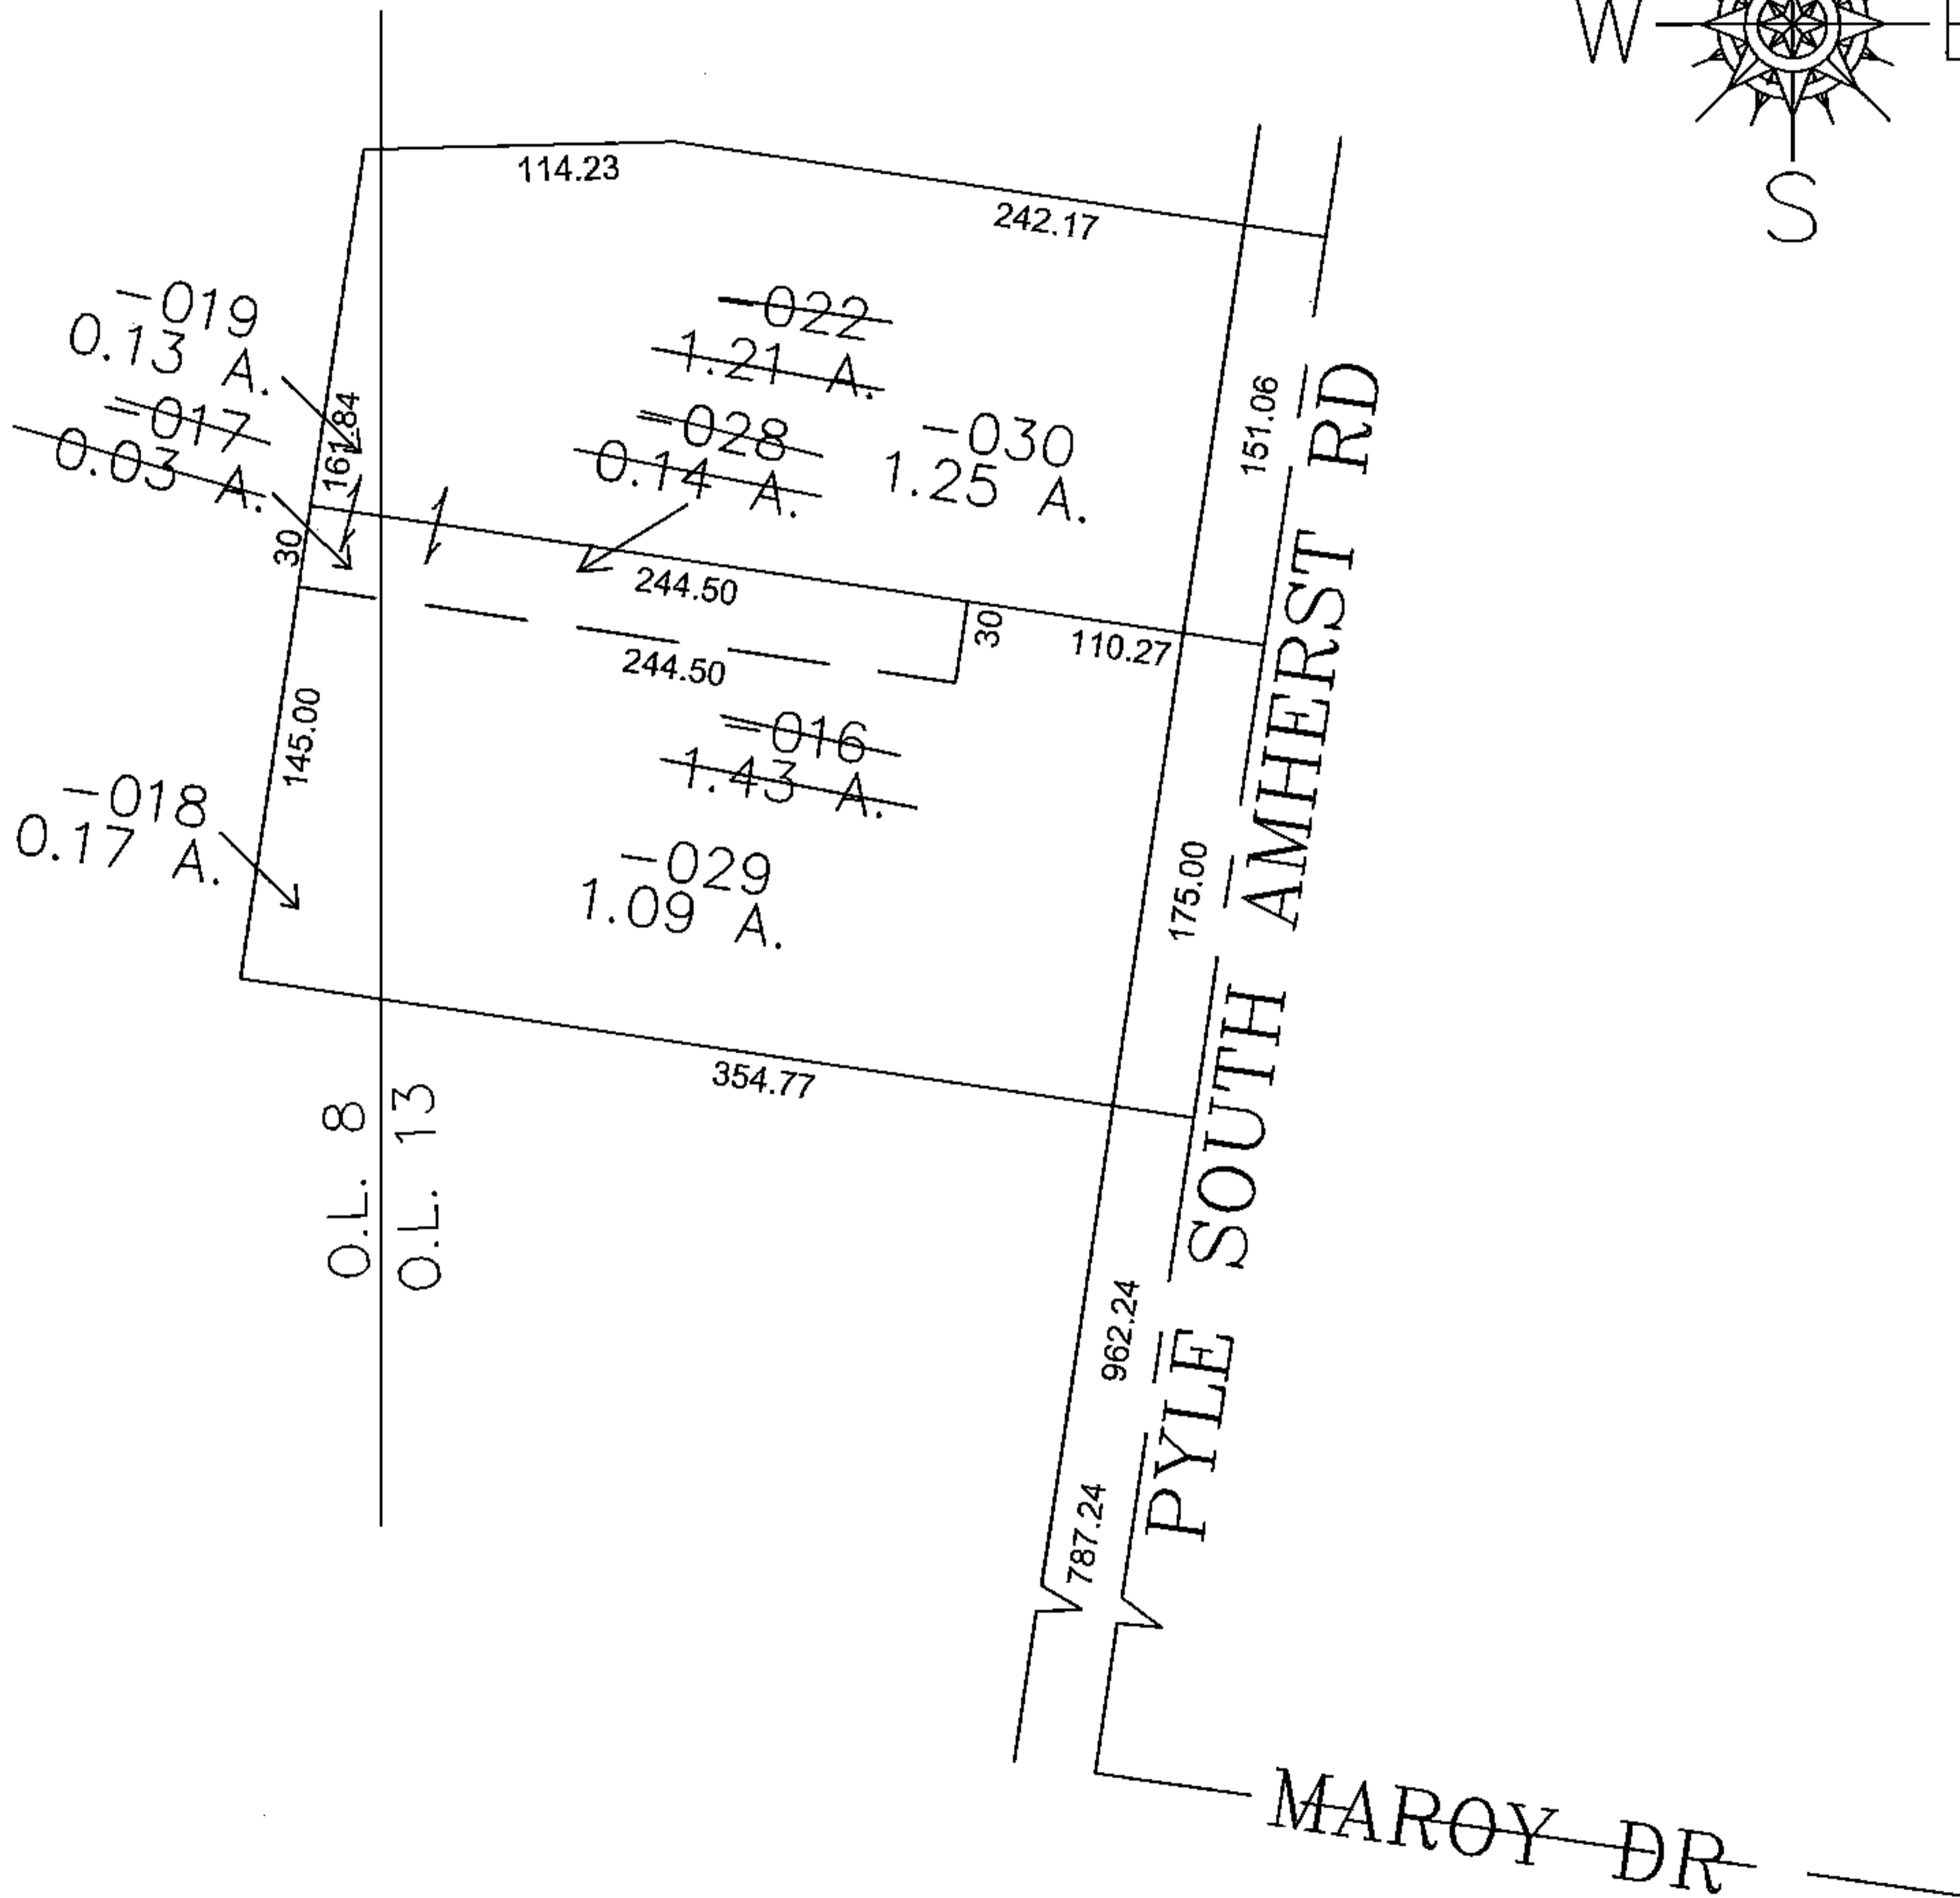


PARENT PARCEL: 05-00-013-101-016, -022
 CHILD PARCEL: 05-00-013-101-028, -029, 030 05-00-008-000-017, -018, -019
 STARTING POINT: CENTERLINE OF PYLE SOUTH AMHERST RD & MAROY DR

16-03471

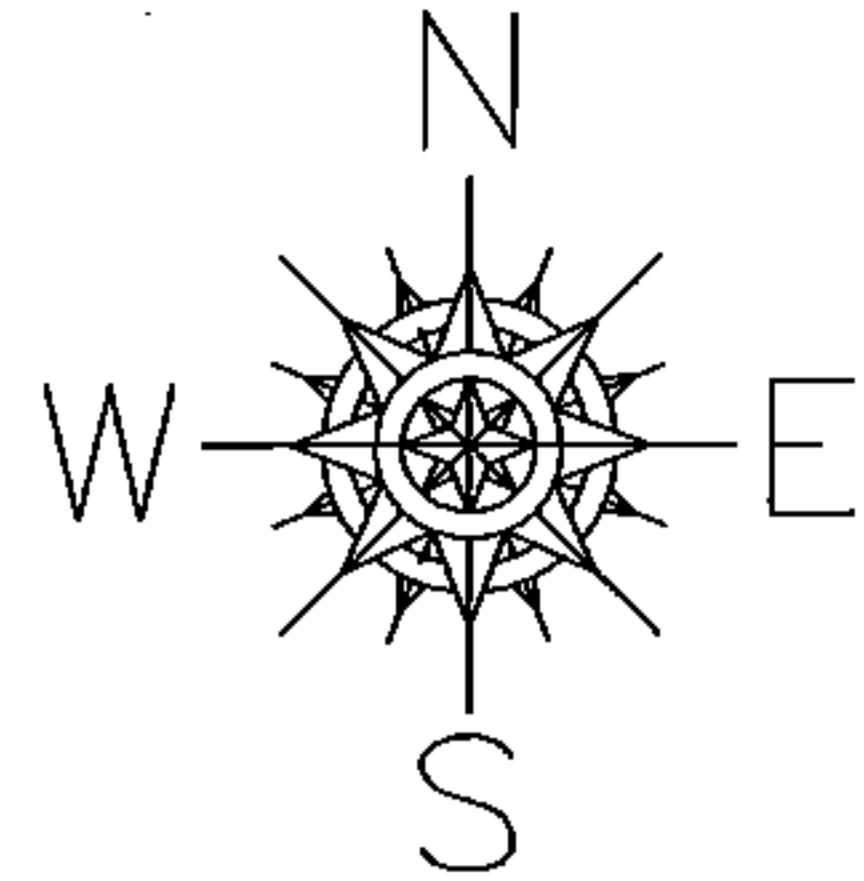

SPLITS/DEEDS PROCESSED

LORAIN COUNTY TAX MAP DEPARTMENT
 226 MIDDLE AVE. ELYRIA, OHIO

SURVEYED BY: THOMAS SIMON
 CLOSURE: 0.00 : 10.000
 MAP PAGE(S): 05-00-013
 APPROVED BY: JAH DATE: 1/12/2016
 SCALE: 1" = 100 PRIOR INSTRUMENT: 20020804599