
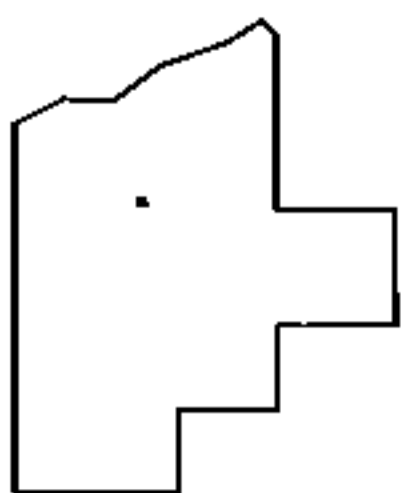
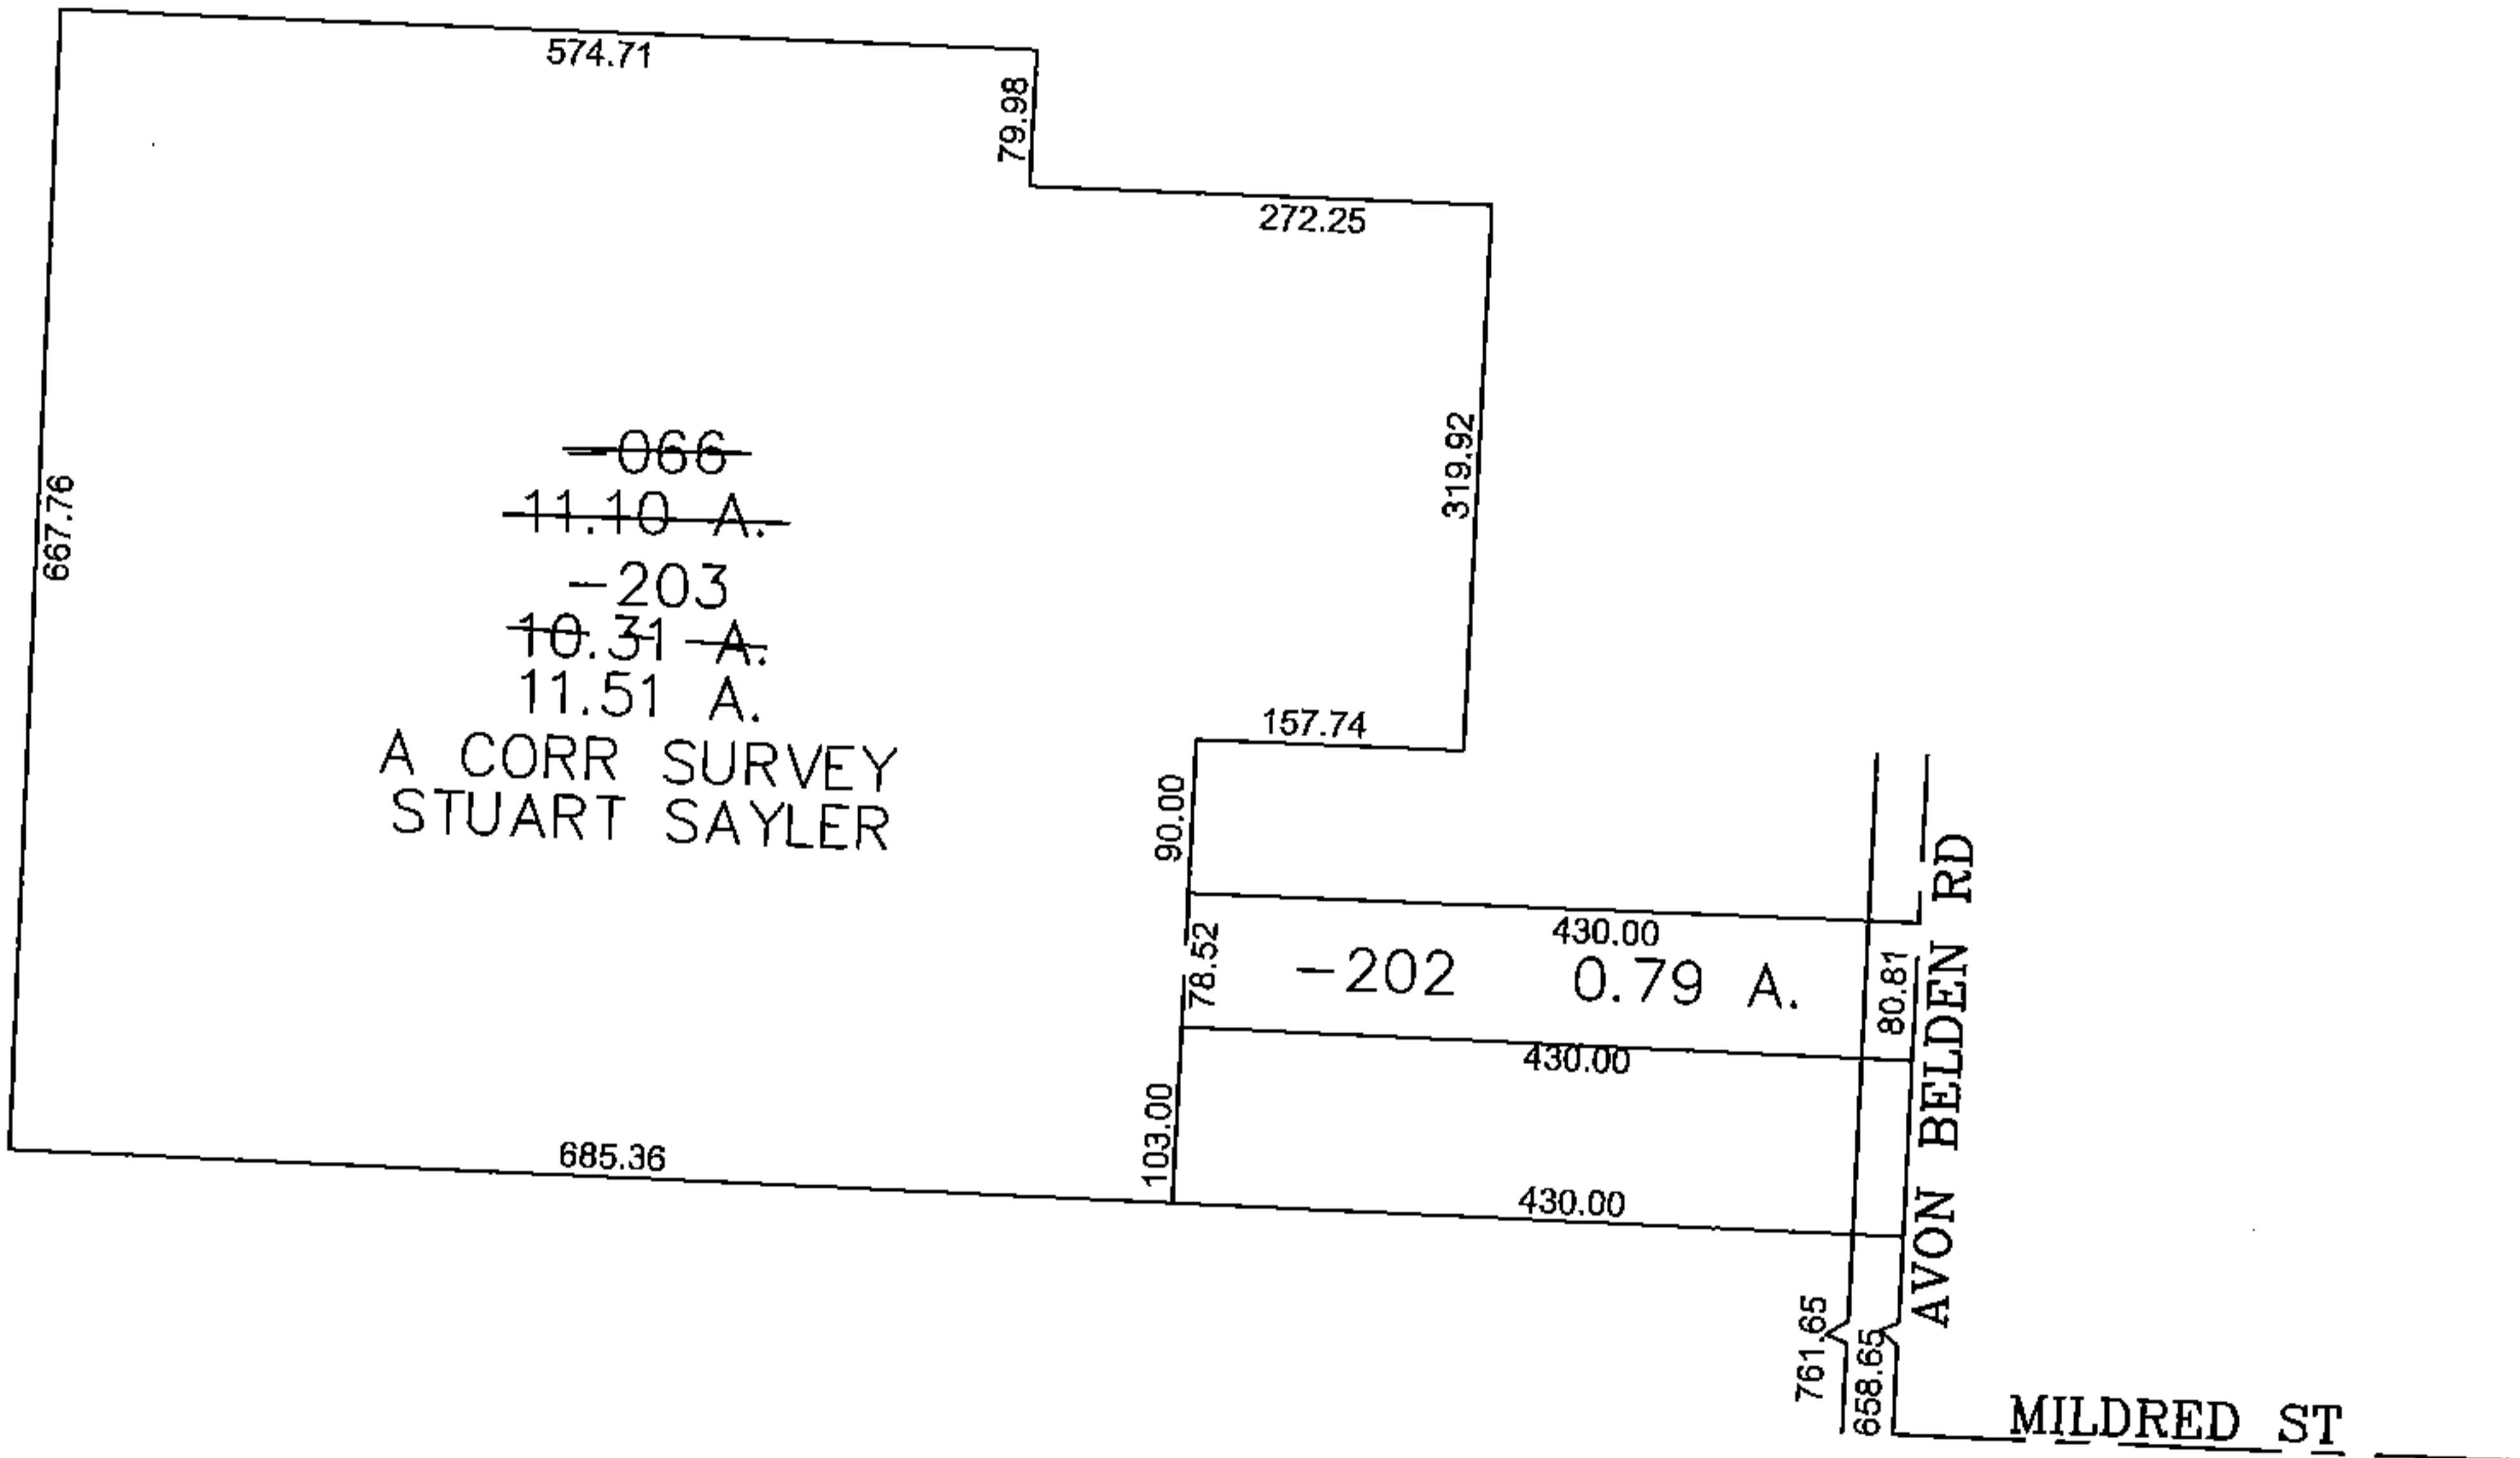


PARENT PARCEL: 07-00-029-000-066

CHILD PARCEL: 07-00-029-000-202, -203

STARTING POINT: CENTERLINE OF AVON BELDEN RD & MILDRED ST

16-03473

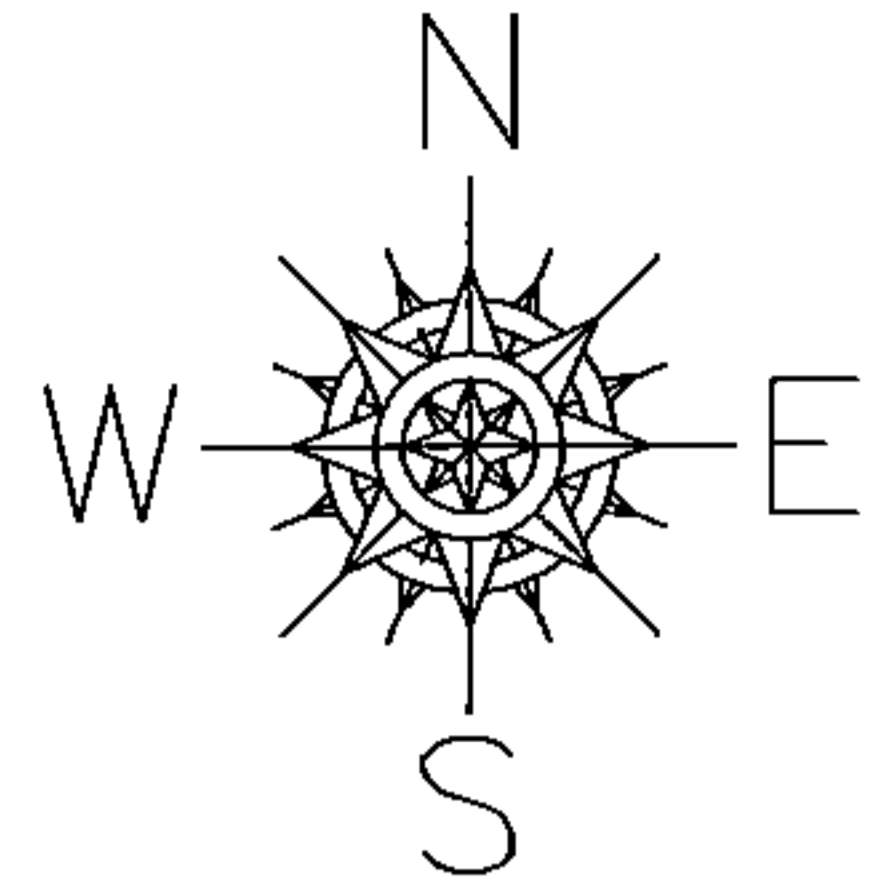

SPLITS/DEEDS PROCESSED
 LORAIN COUNTY TAX MAP DEPARTMENT
 226 MIDDLE AVE. ELYRIA, OHIO

SURVEYED BY: STUART SAYLER
 CLOSURE: 0.00 : 10,000
 MAP PAGE(S): 07-00-029-D
 APPROVED BY: JAH DATE: 1/13/2016
 SCALE: 1" = 200' PRIOR INSTRUMENT: 20100342754