


PARENT PARCEL: 07-00-012-101-010

CHILD PARCEL: 07-00-012-101-132, -133

STARTING POINT: CENTERLINE OF REED RD & SOUTHERLY LINE OF O.L. 12

16-03474

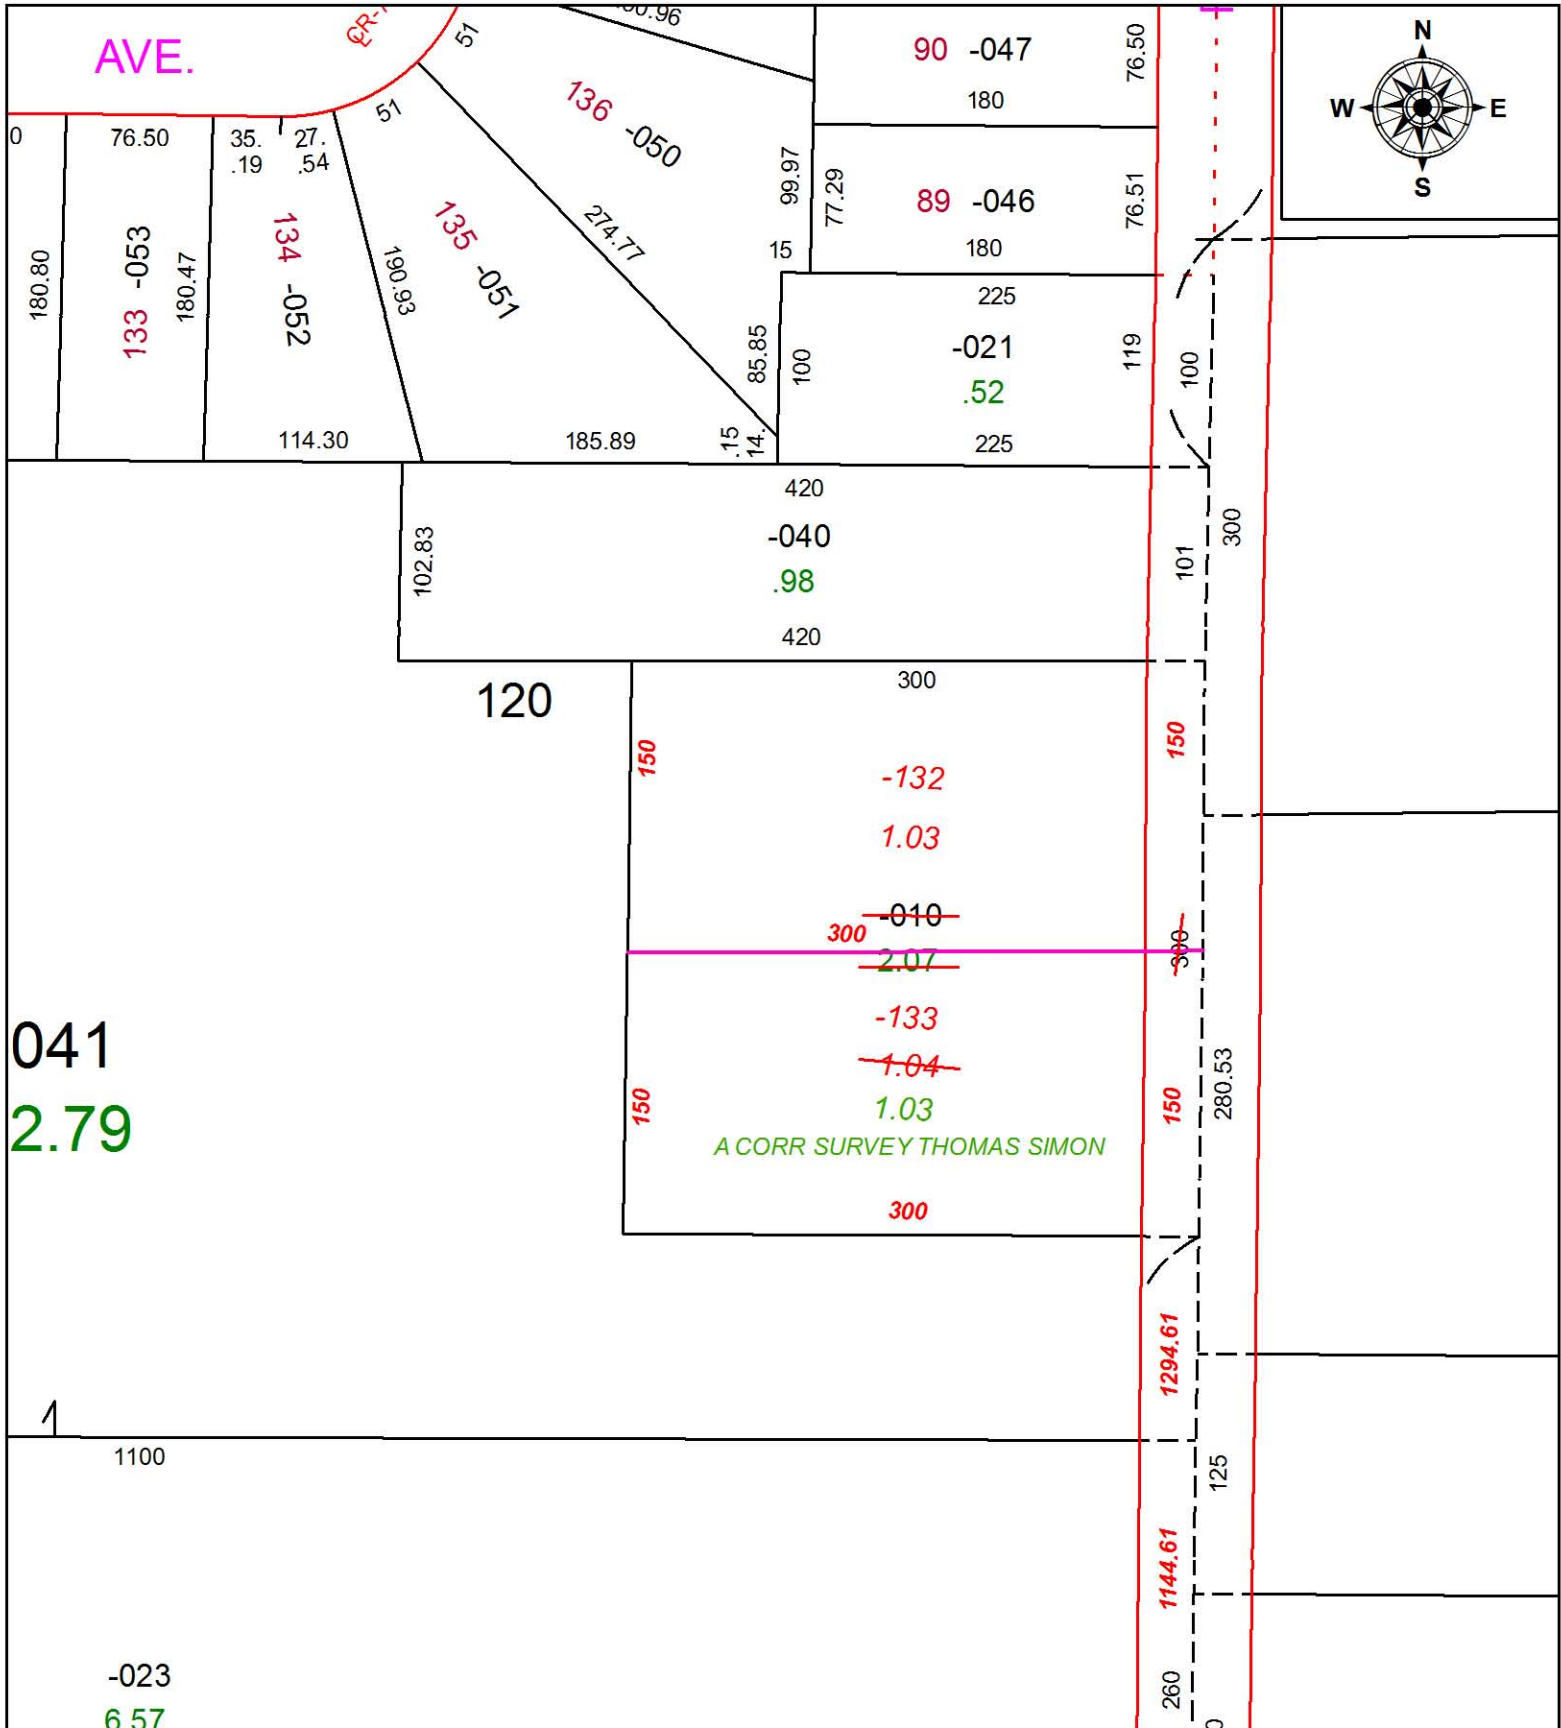

SPLITS/DEEDS PROCESSED
 LORAIN COUNTY TAX MAP DEPARTMENT
 226 MIDDLE AVE. ELYRIA, OH

SURVEYED BY: THOMAS SIMON
CLOSURE: 1:-2147483648
MAP PAGE(S): 07-00-012-C
APPROVED BY: JAH **DATE:** 2/4/2016
SCALE: 1 in = 100 ft **PRIOR INSTRUMENT:** 20100337934