


PARENT PARCEL: 06-25-022-104-007 & -073

CHILD PARCEL: XX-XX-XXX-XXX-XXX


STARTING POINT: EAST R.O.W. OF BON AIR AVE, 26 FEET NORTHERLY OF THE N.W. CORNER OF S/L 1, BLOCK 43

16-03475-C


FR. & DEPTH CORRECTION

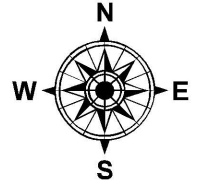

06-25-022-104-007
 FROM
 10 X 25
 TO
 29.50 X 100.50 CALC.
 &
 06-25-022-104-073
 FROM
 60 X 165
 TO
 40.50 X 140.00 CALC.
 PER DV 1161/434
 DV 590/74

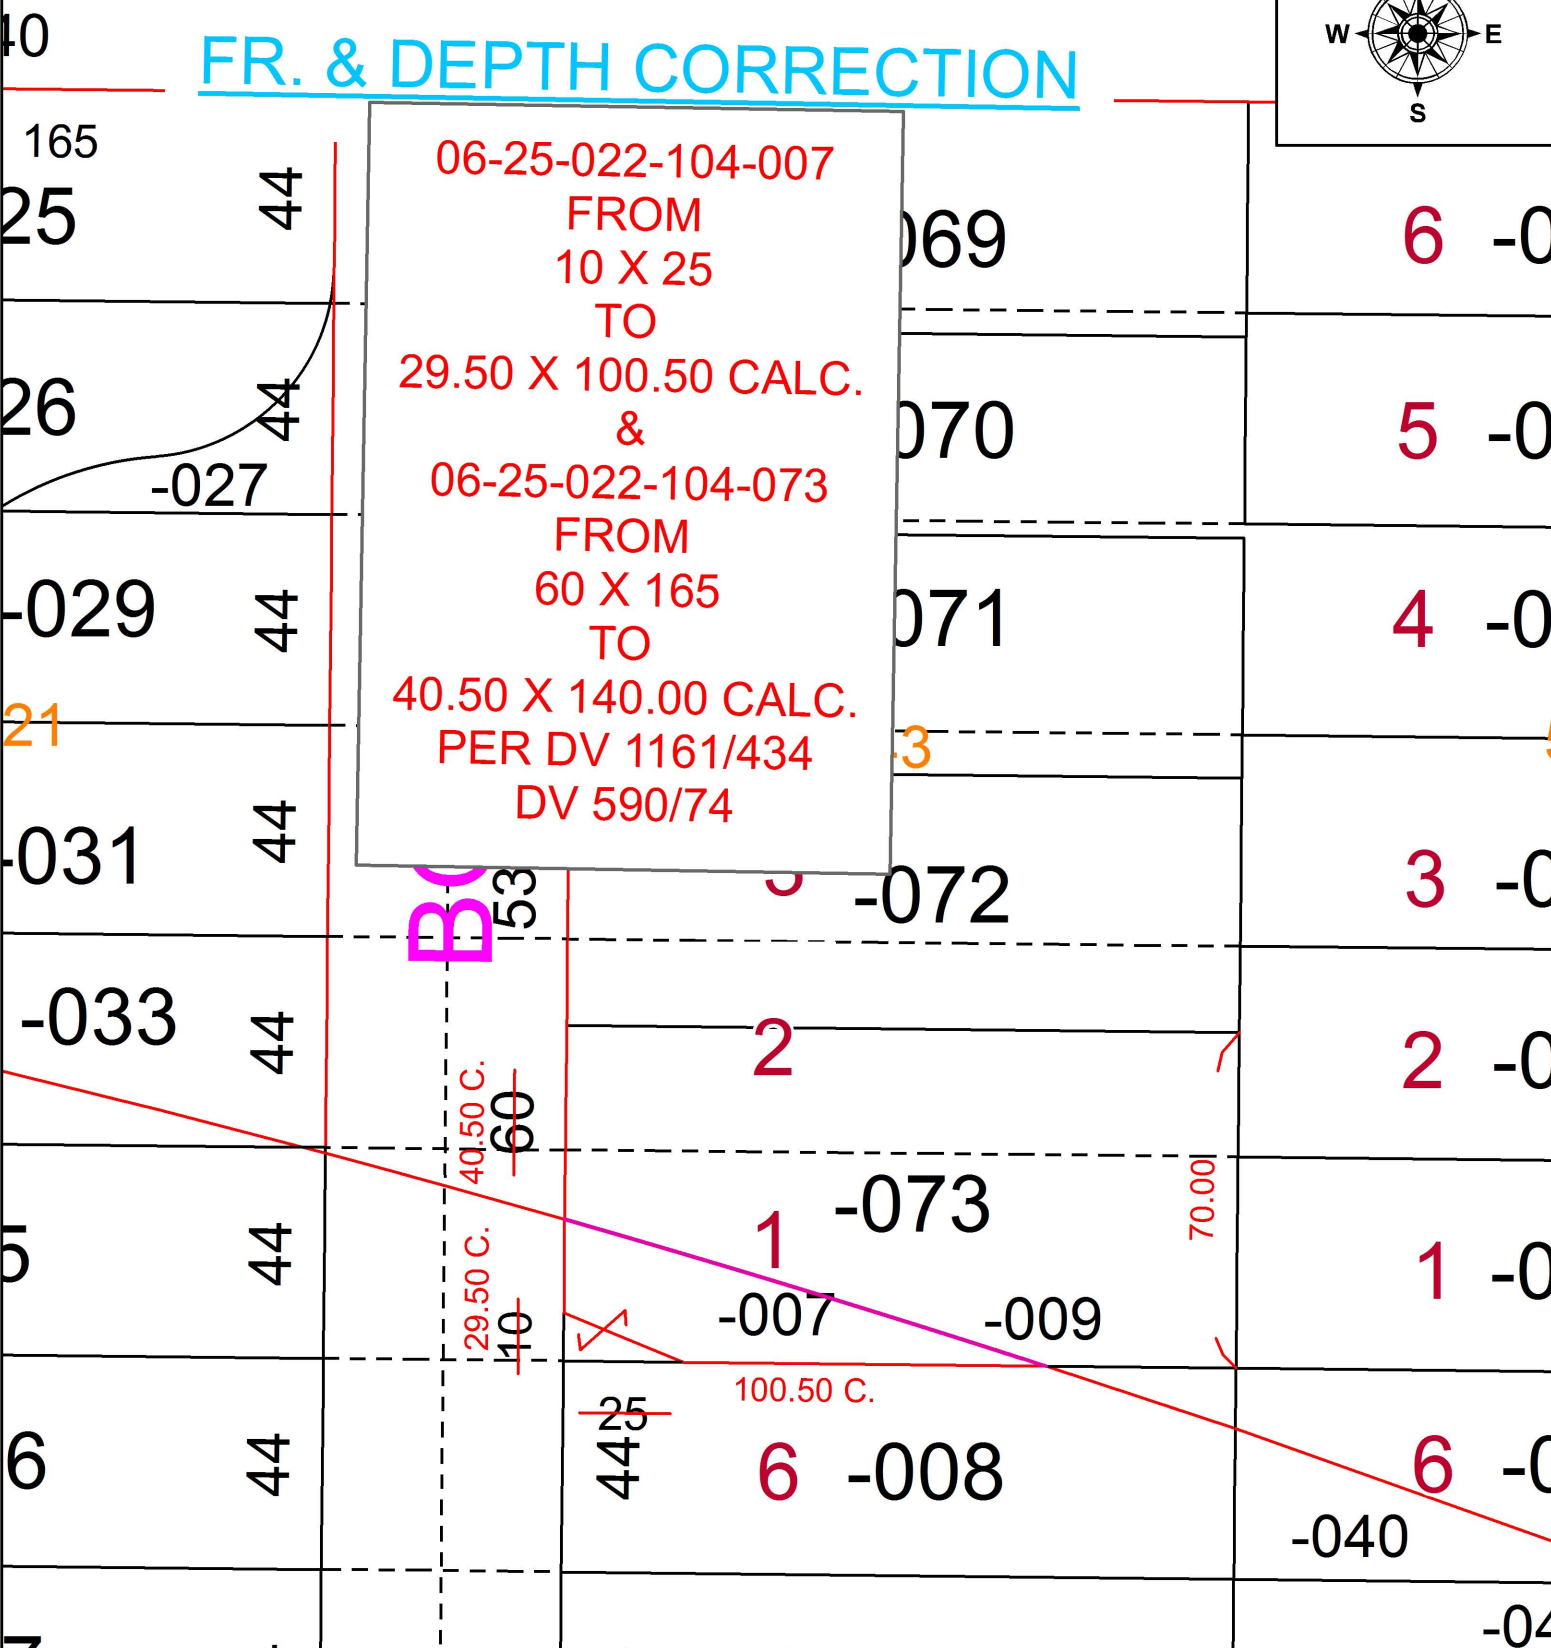

B

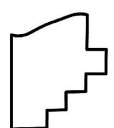

SPLITS/DEEDS PROCESSED
 LORAIN COUNTY TAX MAP DEPARTMENT
 226 MIDDLE AVE. ELYRIA, OH

SURVEYED BY: NA
 CLOSURE: NA
 MAP PAGE(S): 06-25-022
 APPROVED BY: TJS DATE: 6/24/16
 SCALE: 1" = 40' PRIOR INSTRUMENT: DV 1161/434