
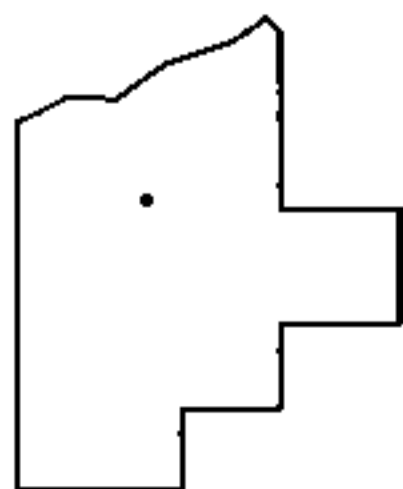
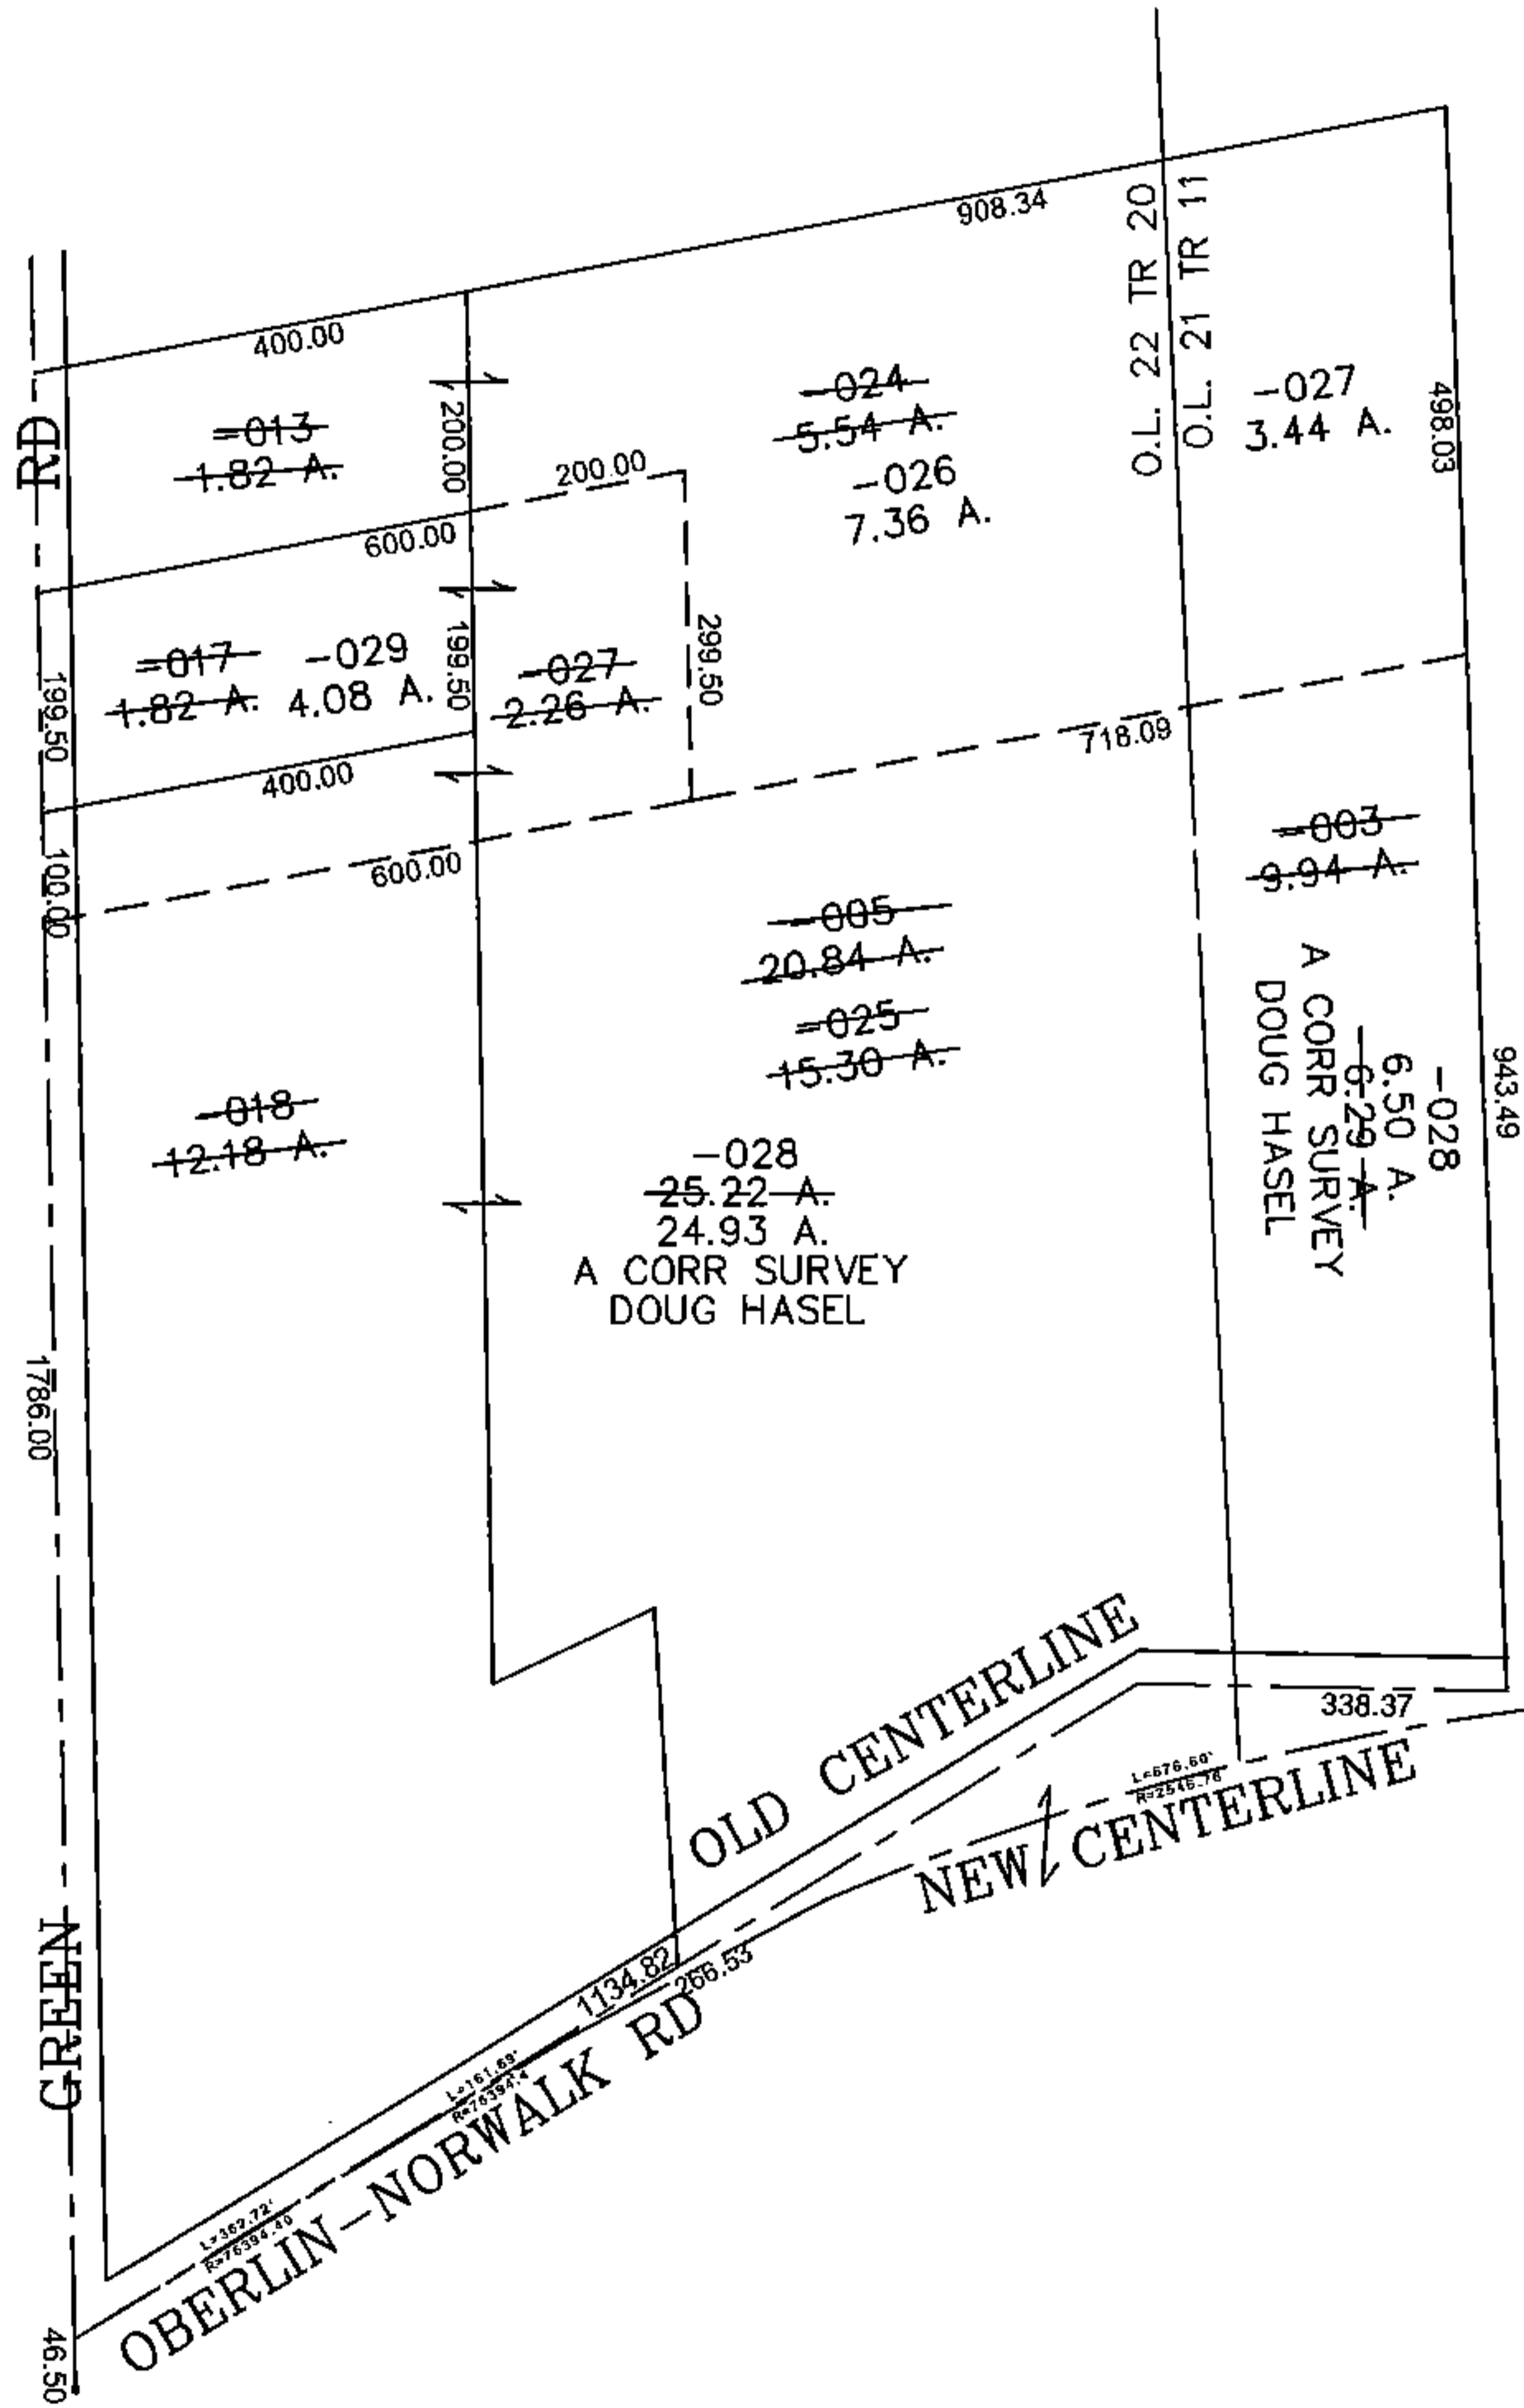


PARENT PARCEL: 13-20-022-000-005, -018, -013, -017, 13-11-021-000-003  
 CHILD PARCEL: 13-20-022-000-024 THRU -029 13-11-021-000-027, -028  
 STARTING POINT: CENTERLINE OF OBERLIN-NORWALK RD & GREEN RD

16-03475

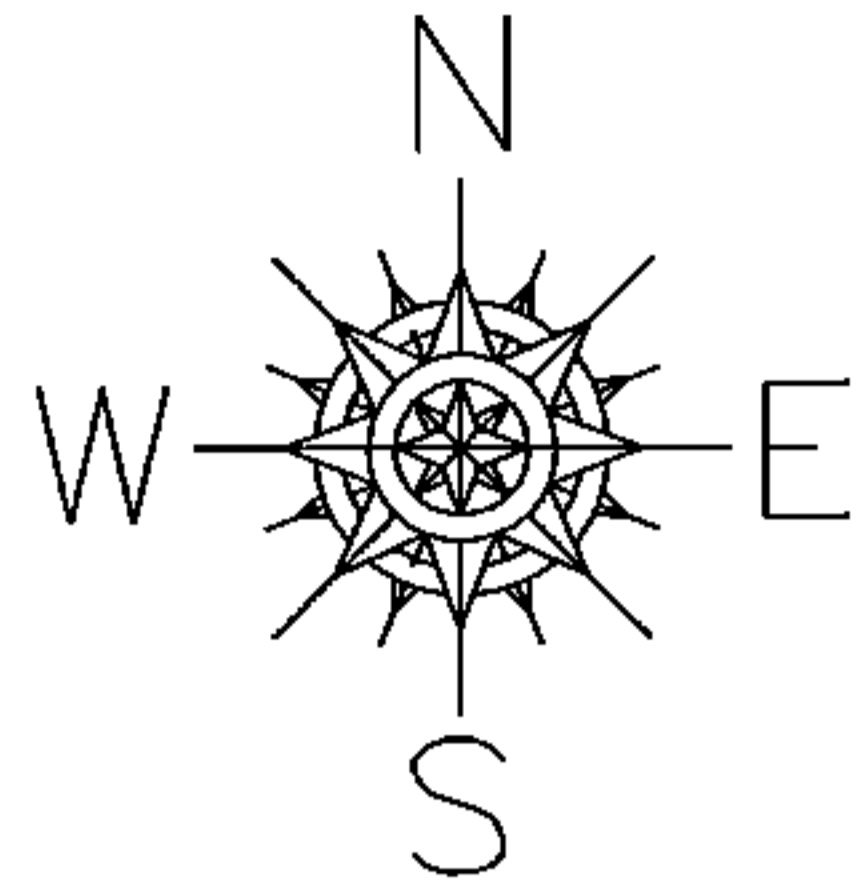

**SPLITS/DEEDS PROCESSED**  
 LORAIN COUNTY TAX MAP DEPARTMENT  
 226 MIDDLE AVE. ELYRIA, OHIO

SURVEYED BY: DOUG HASEL  
 CLOSURE: 0.00 : 10,000  
 MAP PAGE(S): 13-A  
 APPROVED BY: JAH DATE: 1/21/2016  
 SCALE: 1" = 300 PRIOR INSTRUMENT: 20130461723