


PARENT PARCEL: 04-00-020-101-132

CHILD PARCEL: 04-00-020-101-221, -222

STARTING POINT: CL OF WALKER RD & O.L. 20

16-03477

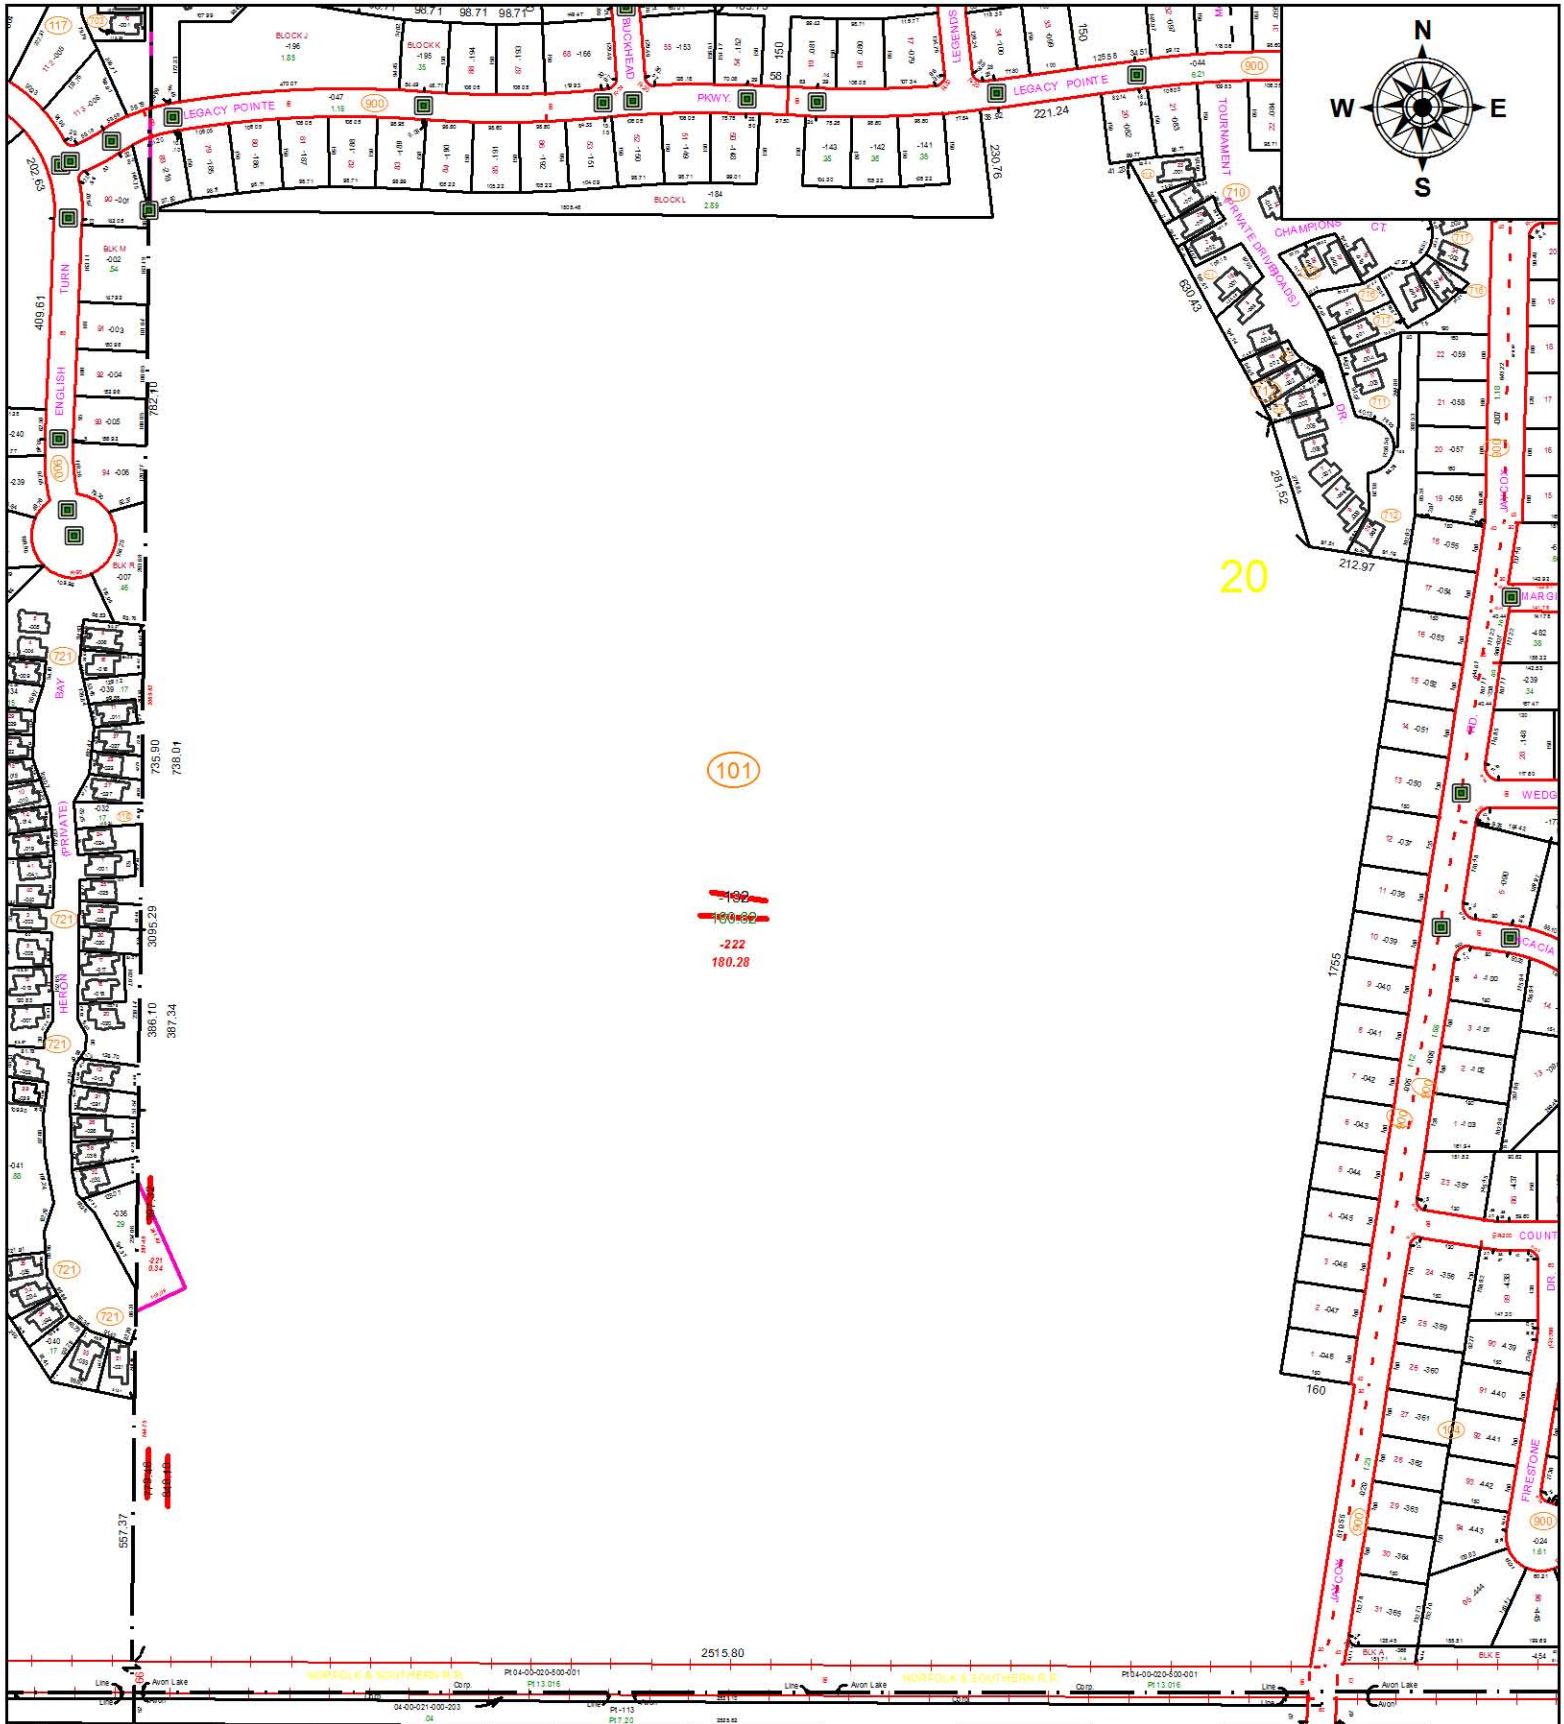

SPLITS/DEEDS PROCESSED

LORAIN COUNTY TAX MAP DEPARTMENT
226 MIDDLE AVE. ELYRIA, OH

SURVEYED BY: JAMES T SAYLER

CLOSURE: 1:2545966

MAP PAGE(S): 04-00-020

APPROVED BY: JAH DATE: 01/27/2016

SCALE: 1" = 200

PRIOR INSTRUMENT: 2002-0826643