



PARENT PARCEL: 15-00-098-108-152

CHILD PARCEL: 15-00-098-108-277 thru -282

STARTING POINT: CL OF STALLION RD & STABLE CT

16-03478

t. 17.47

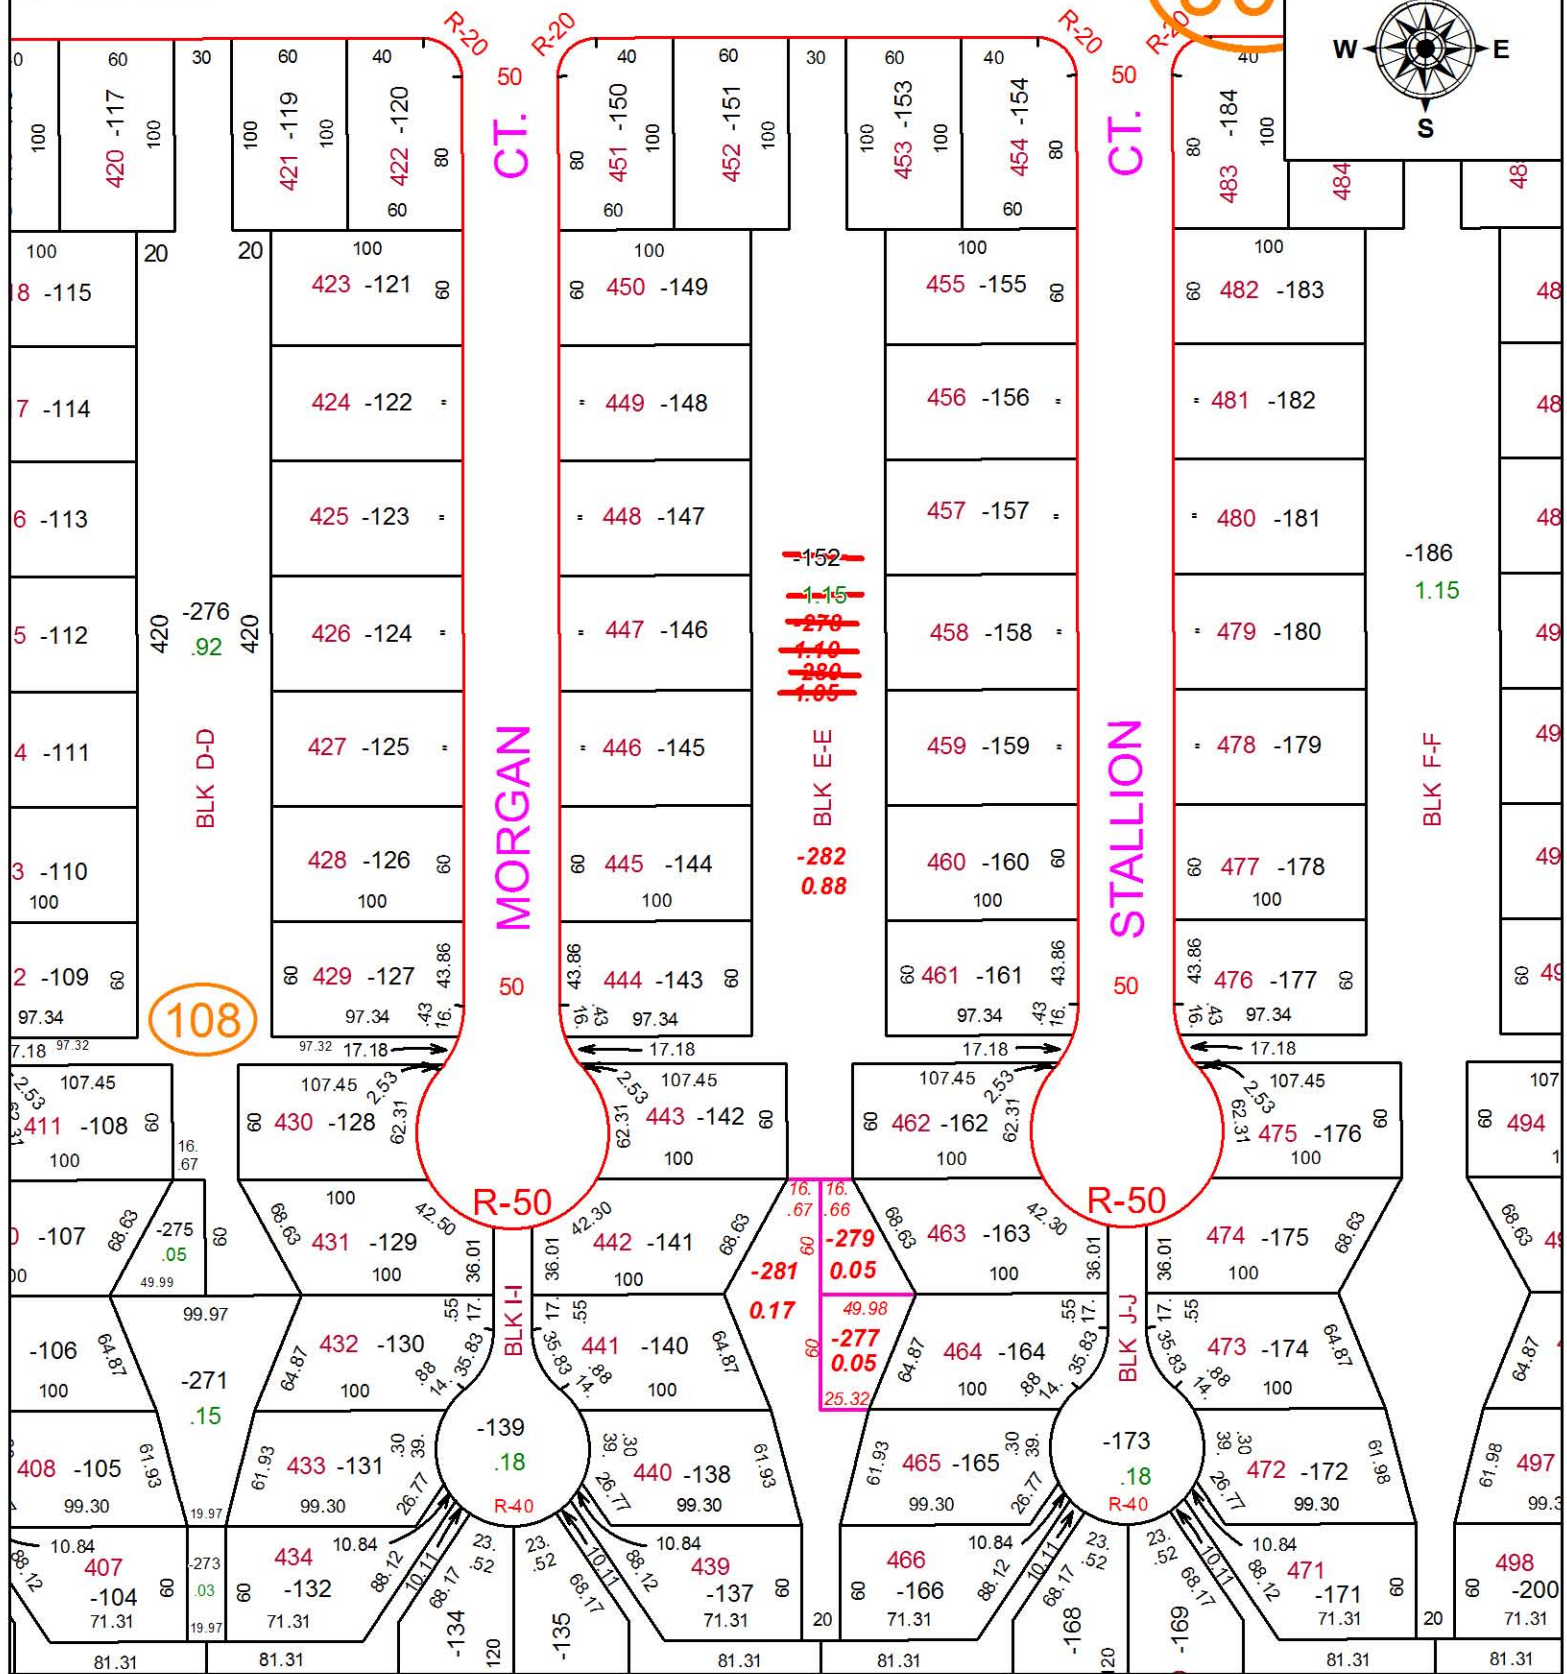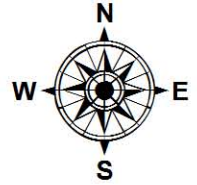

108


90

~~-152~~  
~~-115~~  
~~270~~  
~~110~~  
~~280~~  
~~105~~

-282  
0.88

-281  
0.17

-279  
0.05  
-277  
0.05  
25.32

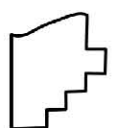

**SPLITS/DEEDS PROCESSED**

LORAIN COUNTY TAX MAP DEPARTMENT  
226 MIDDLE AVE. ELYRIA, OH

SURVEYED BY: THOMAS SIMON  
CLOSURE: 1:24,000  
MAP PAGE(S): 15-00-098  
APPROVED BY: JAH DATE: 1/29/2016  
SCALE: 1" = 100' PRIOR INSTRUMENT: 20150554268