


PARENT PARCEL: 04-00-013-000-341


CHILD PARCEL: 04-00-013-000-571, -572

STARTING POINT: Centerline of State Rt 83 & South Park Dr.

16-03479

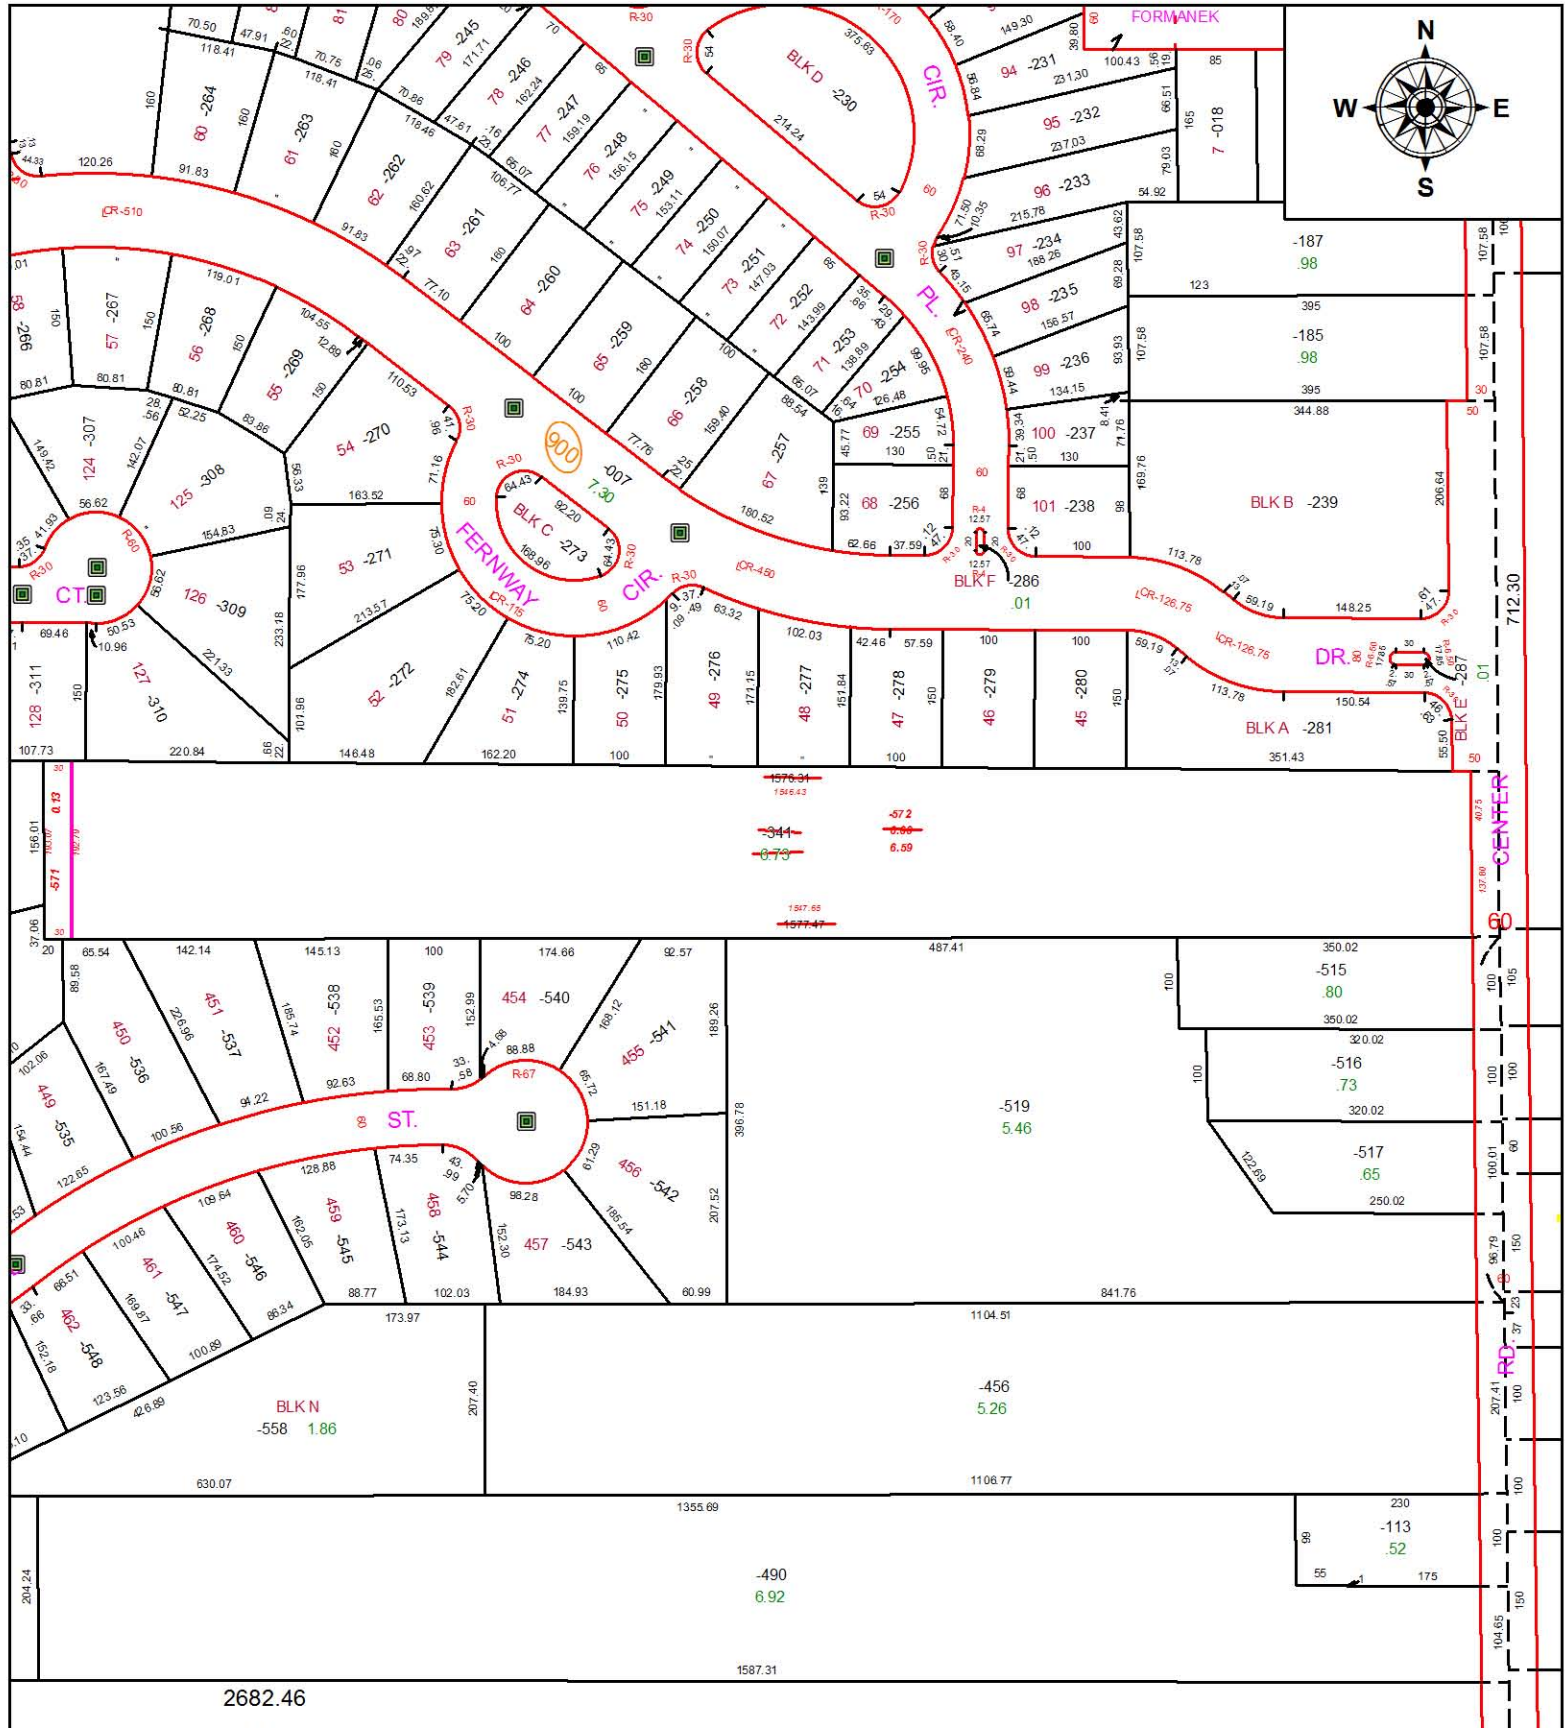

2682.46

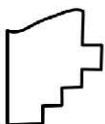

SPLITS/DEEDS PROCESSED

LORAIN COUNTY TAX MAP DEPARTMENT
226 MIDDLE AVE. ELYRIA, OH

SURVEYED BY: BRENT ANDERSON

CLOSURE: 1: 98,000

MAP PAGE(S): 04-00-013

APPROVED BY: JAH DATE: 2/1/2016

SCALE: 1 in = 208 ft PRIOR INSTRUMENT: 20000682125