


PARENT PARCEL: 03-00-030-109-002, -016 ** SEE BELOW


CHILD PARCEL: 03-00-030-109-019, 03-00-059-000-033, 03-00-060-000-050

STARTING POINT: INTERSECTIONS OF CENTERLINES OF LAKE BREEZE RD & ST RT 611

16-03483

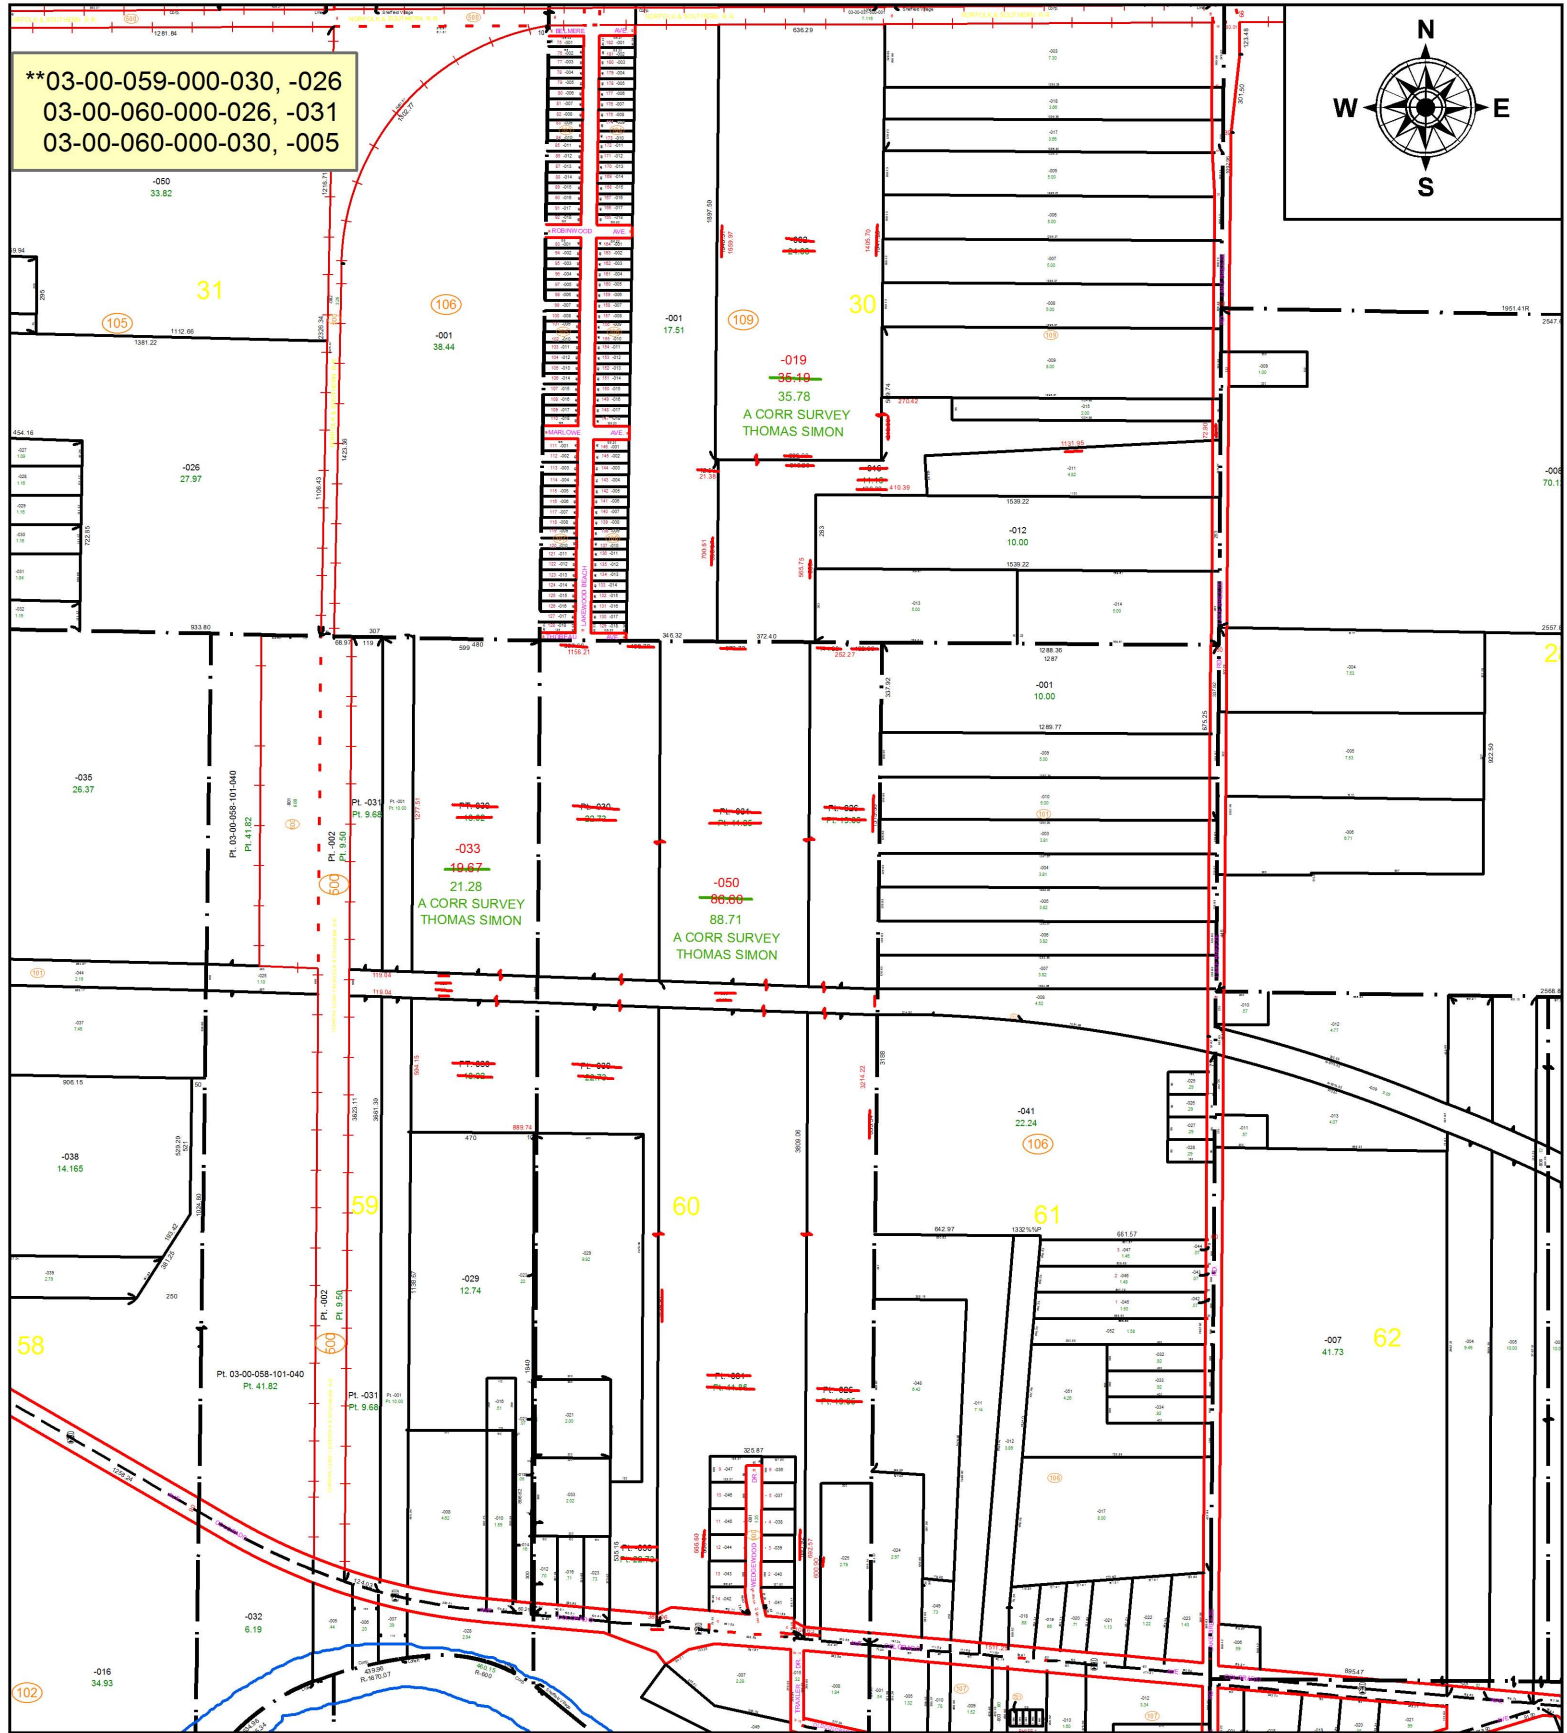

**03-00-059-000-030, -026
 03-00-060-000-026, -031
 03-00-060-000-030, -005

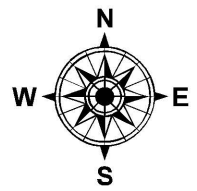

SPLITS/DEEDS PROCESSED
 LORAIN COUNTY TAX MAP DEPARTMENT
 226 MIDDLE AVE. ELYRIA, OH

SURVEYED BY: THOMAS SIMON
 CLOSURE: 1:824037
 MAP PAGE(S): 3-A
 APPROVED BY: JAH DATE: 2/25/2016
 SCALE: 1 in = 734 ft PRIOR INSTRUMENT: DV 1249/551