


PARENT PARCEL: 14-00-024-000-004, -003

CHILD PARCEL: 14-00-024-000-005


STARTING POINT: CENTERLINES OF HALLAUER RD & KIPTON-NICKLE PLATE RD

16-03484

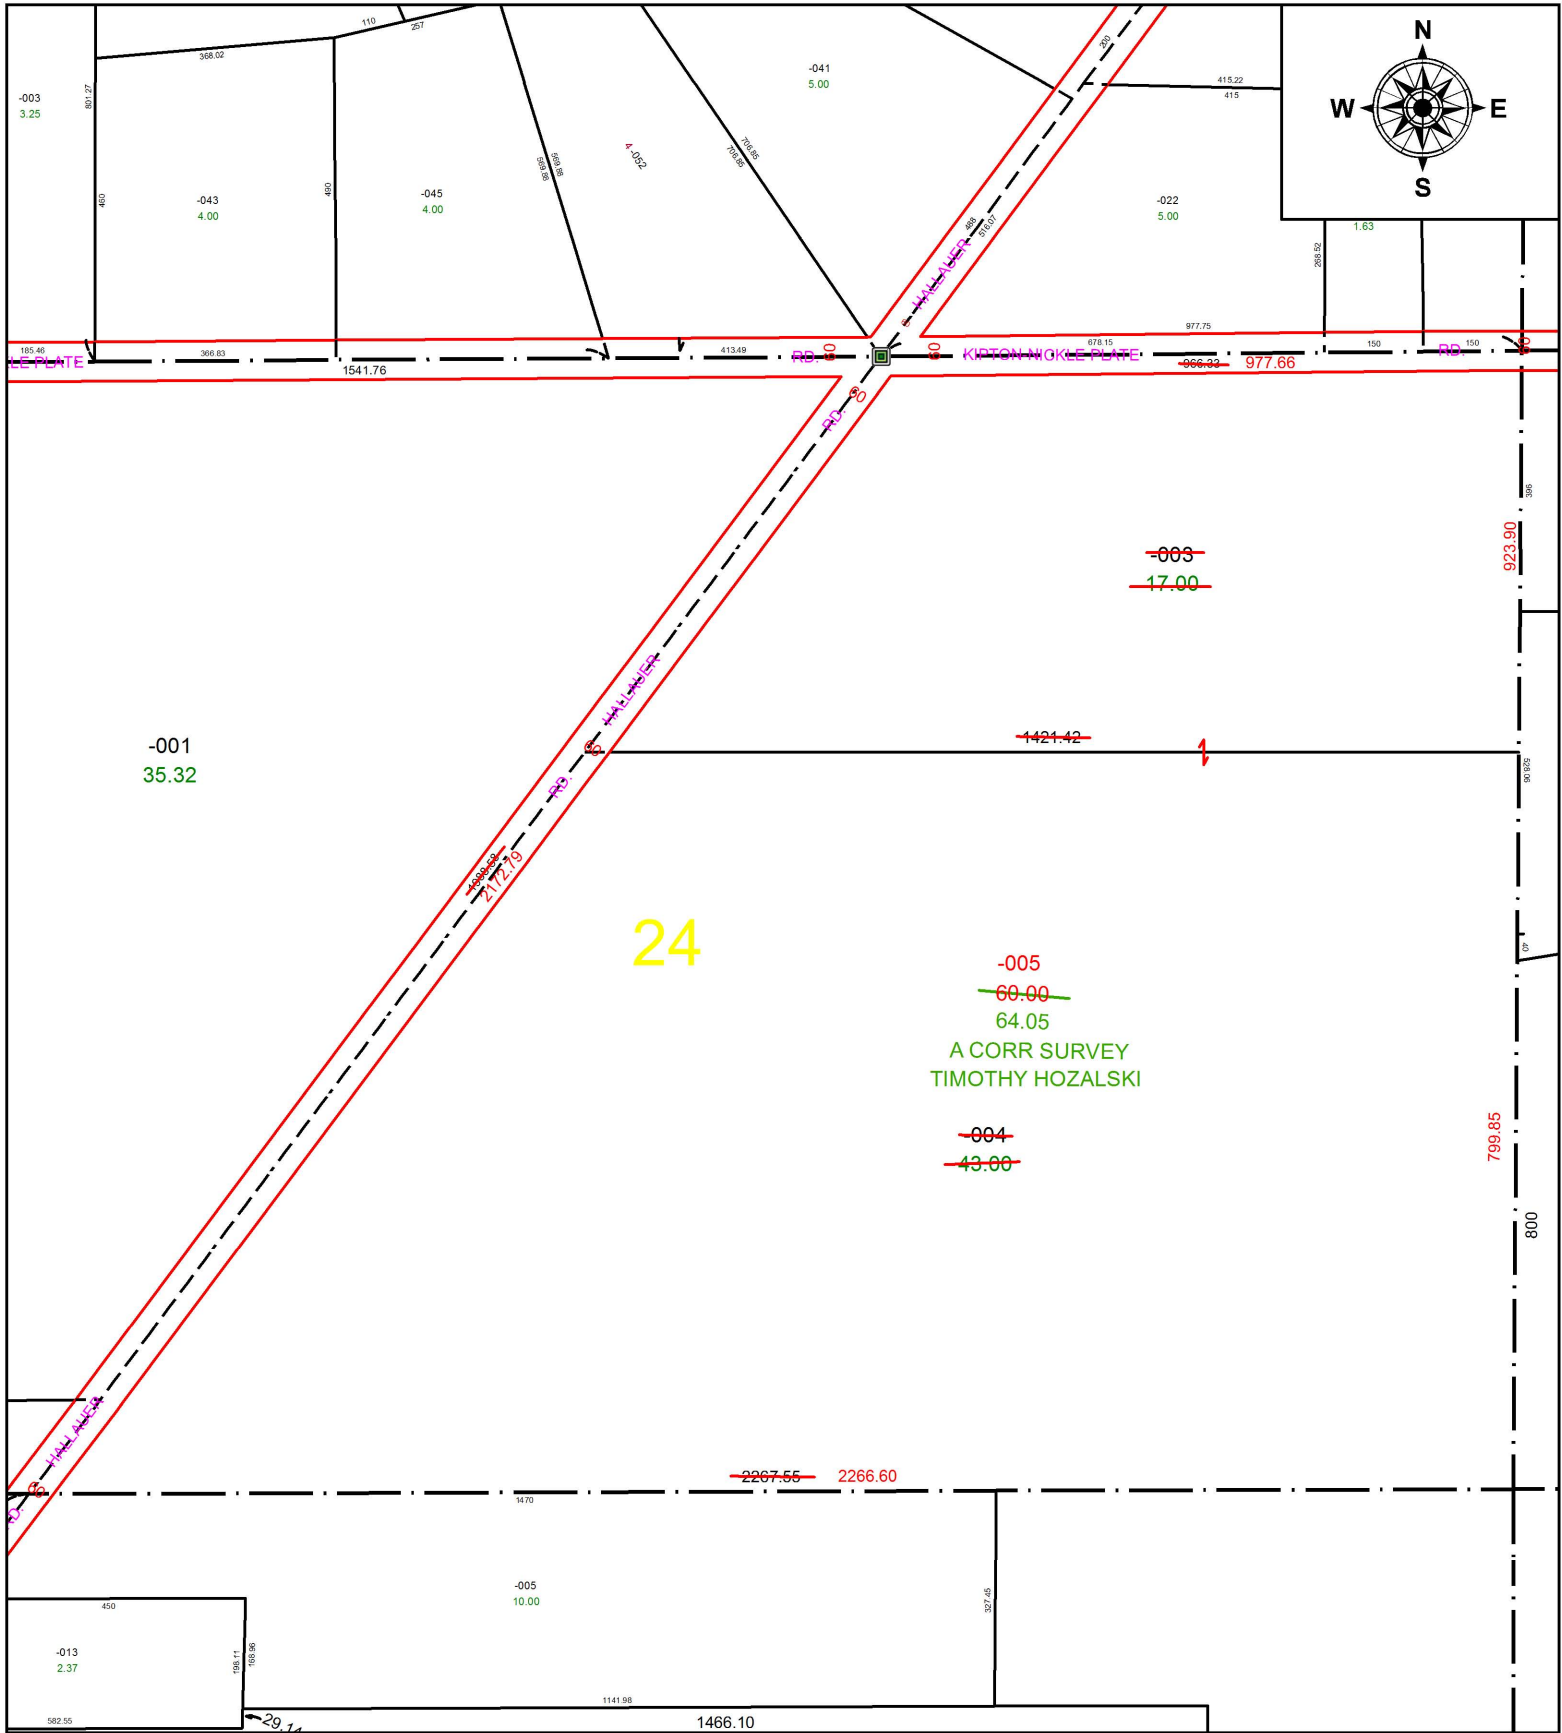

24

-005
~~60.00~~
 64.05
 A CORR SURVEY
 TIMOTHY HOZALSKI
~~004~~
~~43.00~~

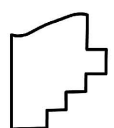

SPLITS/DEEDS PROCESSED
 LORAIN COUNTY TAX MAP DEPARTMENT
 226 MIDDLE AVE. ELYRIA, OH

SURVEYED BY: TIMOTHY HOZALSKI
 CLOSURE: 1:4192261
 MAP PAGE(S): 14-C
 APPROVED BY: JAH DATE: 3/16/2016
 SCALE: 1 in = 292 ft PRIOR INSTRUMENT: 20030904544