
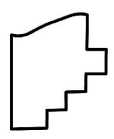
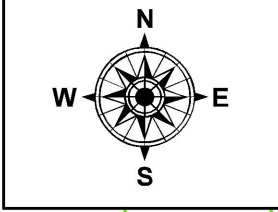


PARENT PARCEL: 06-25-001-000-197

CHILD PARCEL: XX-XX-XXX-XXX-XXX

STARTING POINT: NORTHEAST CORNER OF BENTLEY WOODS PH. 4

16-03487-A

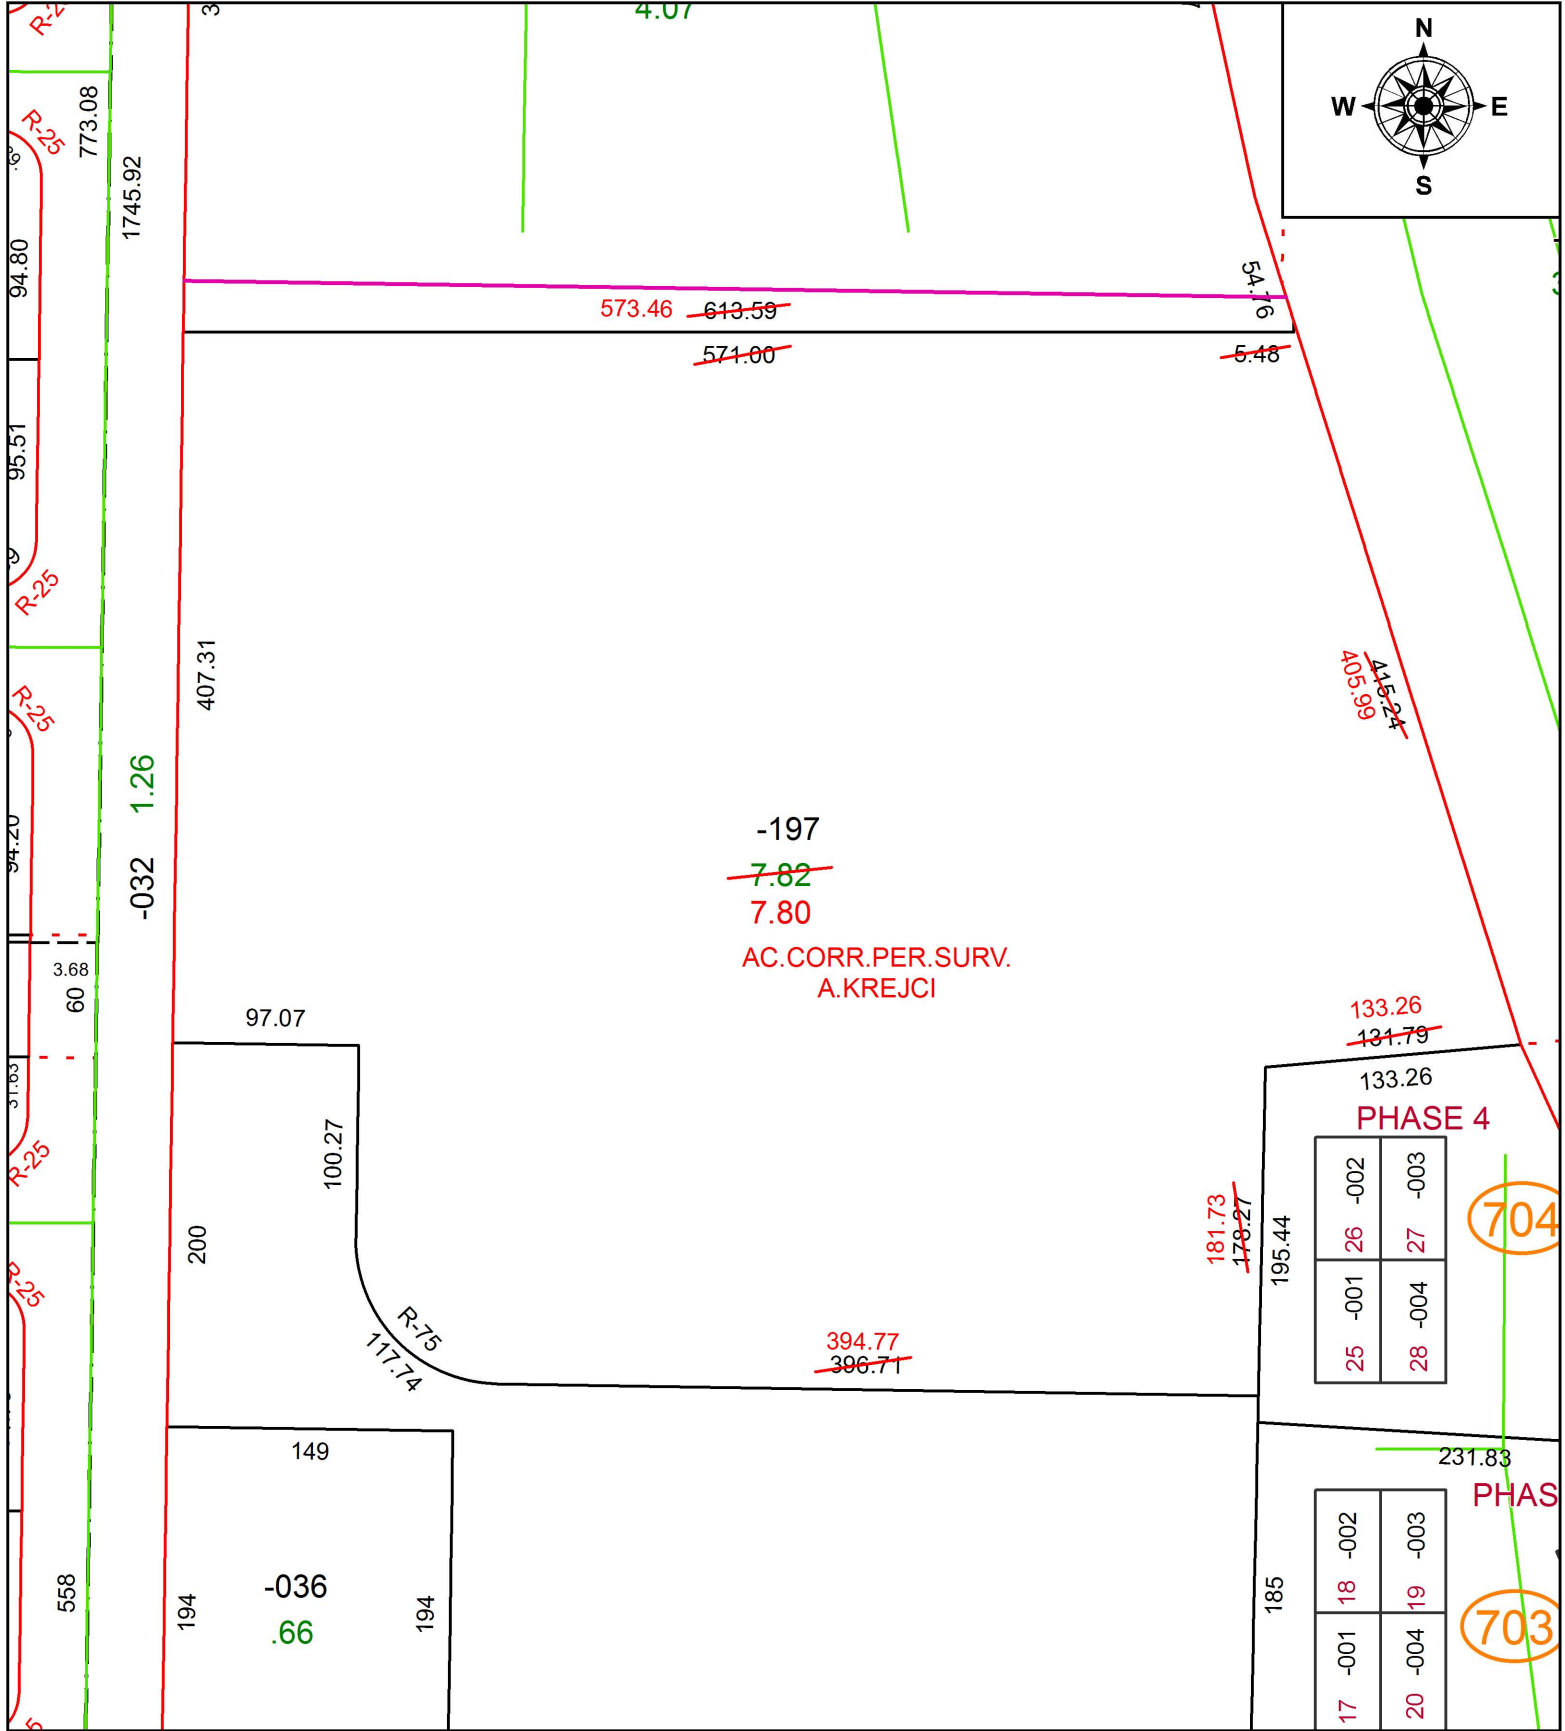

SPLITS/DEEDS PROCESSED
 LORAIN COUNTY TAX MAP DEPARTMENT
 226 MIDDLE AVE. ELYRIA, OH

SURVEYED BY: ALAINA J. KREJCI
 CLOSURE: 1: 266,393
 MAP PAGE(S): 6-143
 APPROVED BY: RRM DATE: 7-27-16
 SCALE: 1" = 100 PRIOR INSTRUMENT: 20020804878