
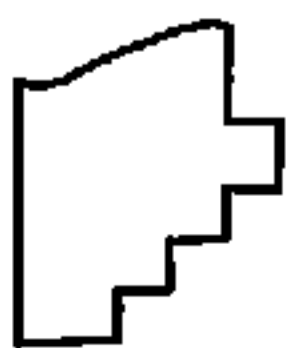


PARENT PARCEL: 15-00-098-108-284

CHILD PARCEL: 15-00-098-108-285, -286

STARTING POINT: NORTHWEST CORNER OF S/L 496 IN PHEASANT RUN VILL. SUBD NO 1

16-03487

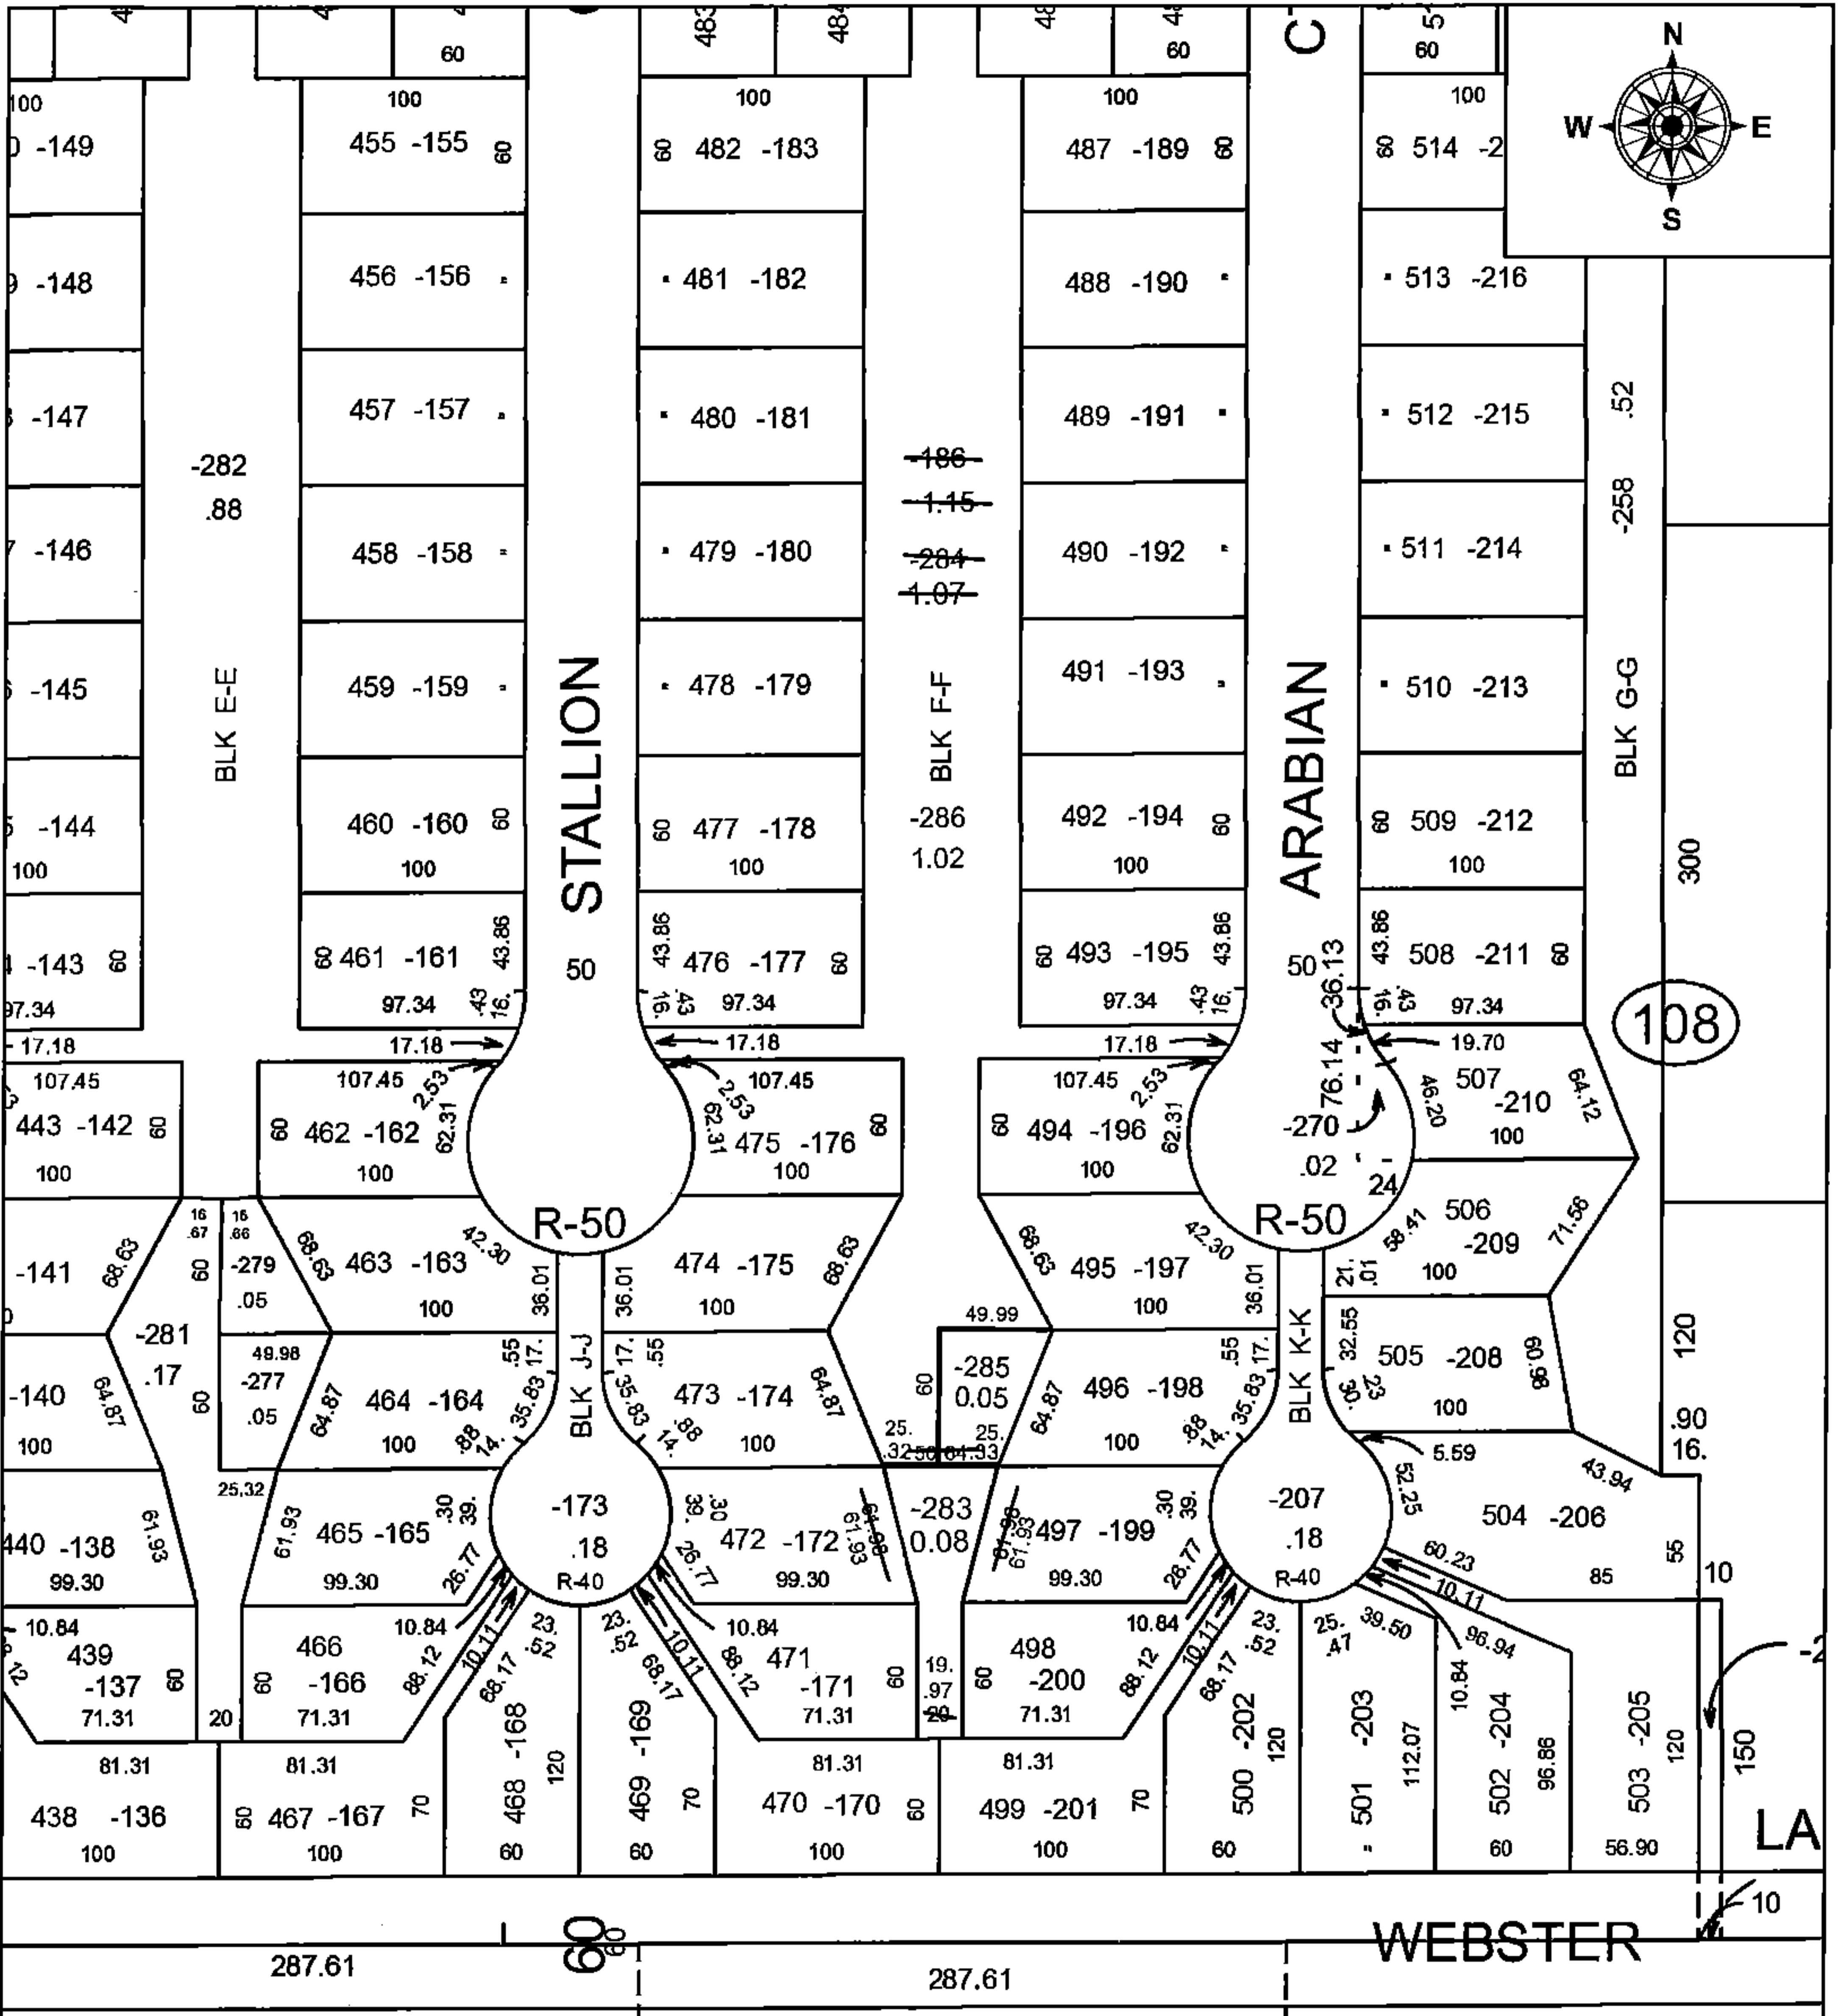

**SPLITS/DEEDS PROCESSED**

LORAIN COUNTY TAX MAP DEPARTMENT  
226 MIDDLE AVE. ELYRIA, OH

SURVEYED BY: THOMAS SIMON

CLOSURE: 1:87573

MAP PAGE(S): 15-00-098

APPROVED BY: JAH DATE: 03/07/2016

SCALE: 1 in = 100 ft PRIOR INSTRUMENT: 20150554268