
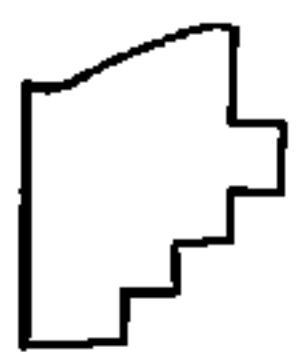


PARENT PARCEL: 19-03-003-000-008

CHILD PARCEL: 19-03-003-000-009, -010

STARTING POINT: CENTERLINE OF MEDINA-NORWALK RD & SE CORNER OF OL 5

16-03491

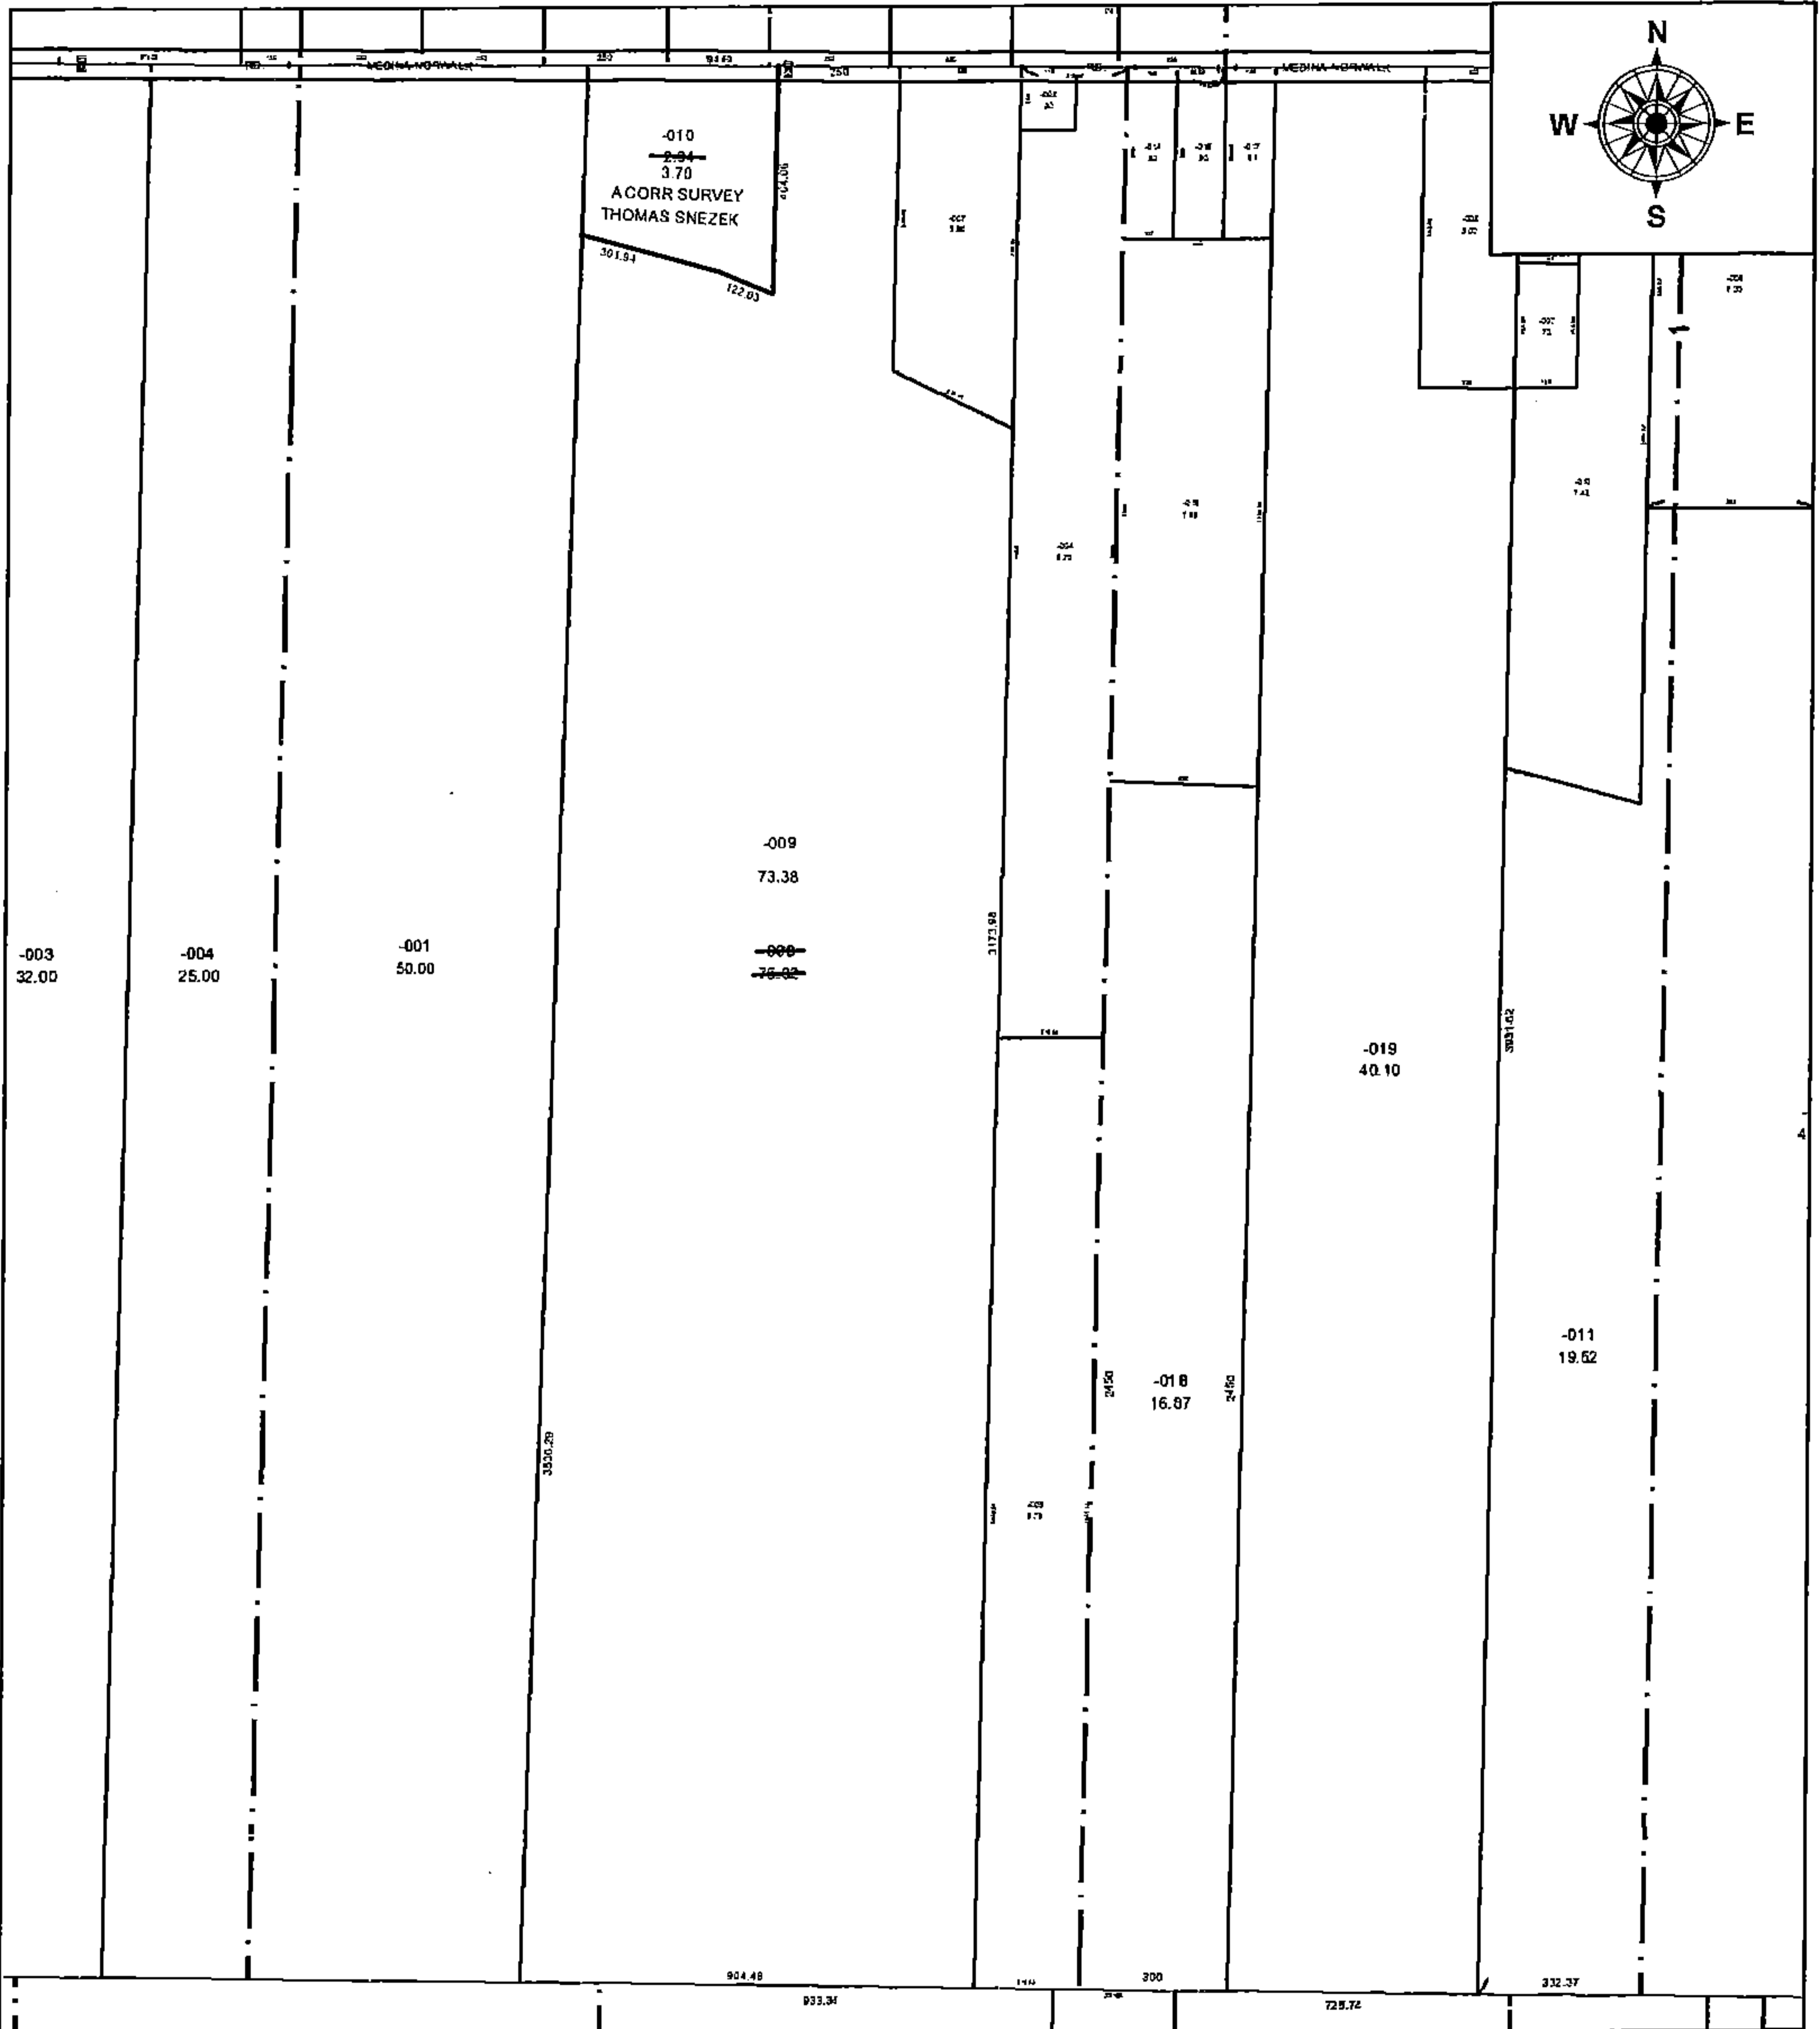

**SPLITS/DEEDS PROCESSED**  
 LORAIN COUNTY TAX MAP DEPARTMENT  
 226 MIDDLE AVE. ELYRIA, OH

SURVEYED BY: THOMAS SNEZEK  
 CLOSURE: 1:1089076  
 MAP PAGE(S): 19-03-003  
 APPROVED BY: JAH DATE: 03/14/2016  
 SCALE: 1 in = 458 ft PRIOR INSTRUMENT: 20030937049