
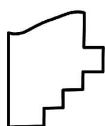


PARENT PARCEL: 09-00-095-106-023

CHILD PARCEL: XX-XX-XXX-XXX-XXX

STARTING POINT: DRILL HOLE SET, N.E. CORNER OF LOT 60 IN ELIPHALET FOLLET'S ADDITION TO VILLAGE OF OBERLIN PV. 2 PG. 1

16-03492-D

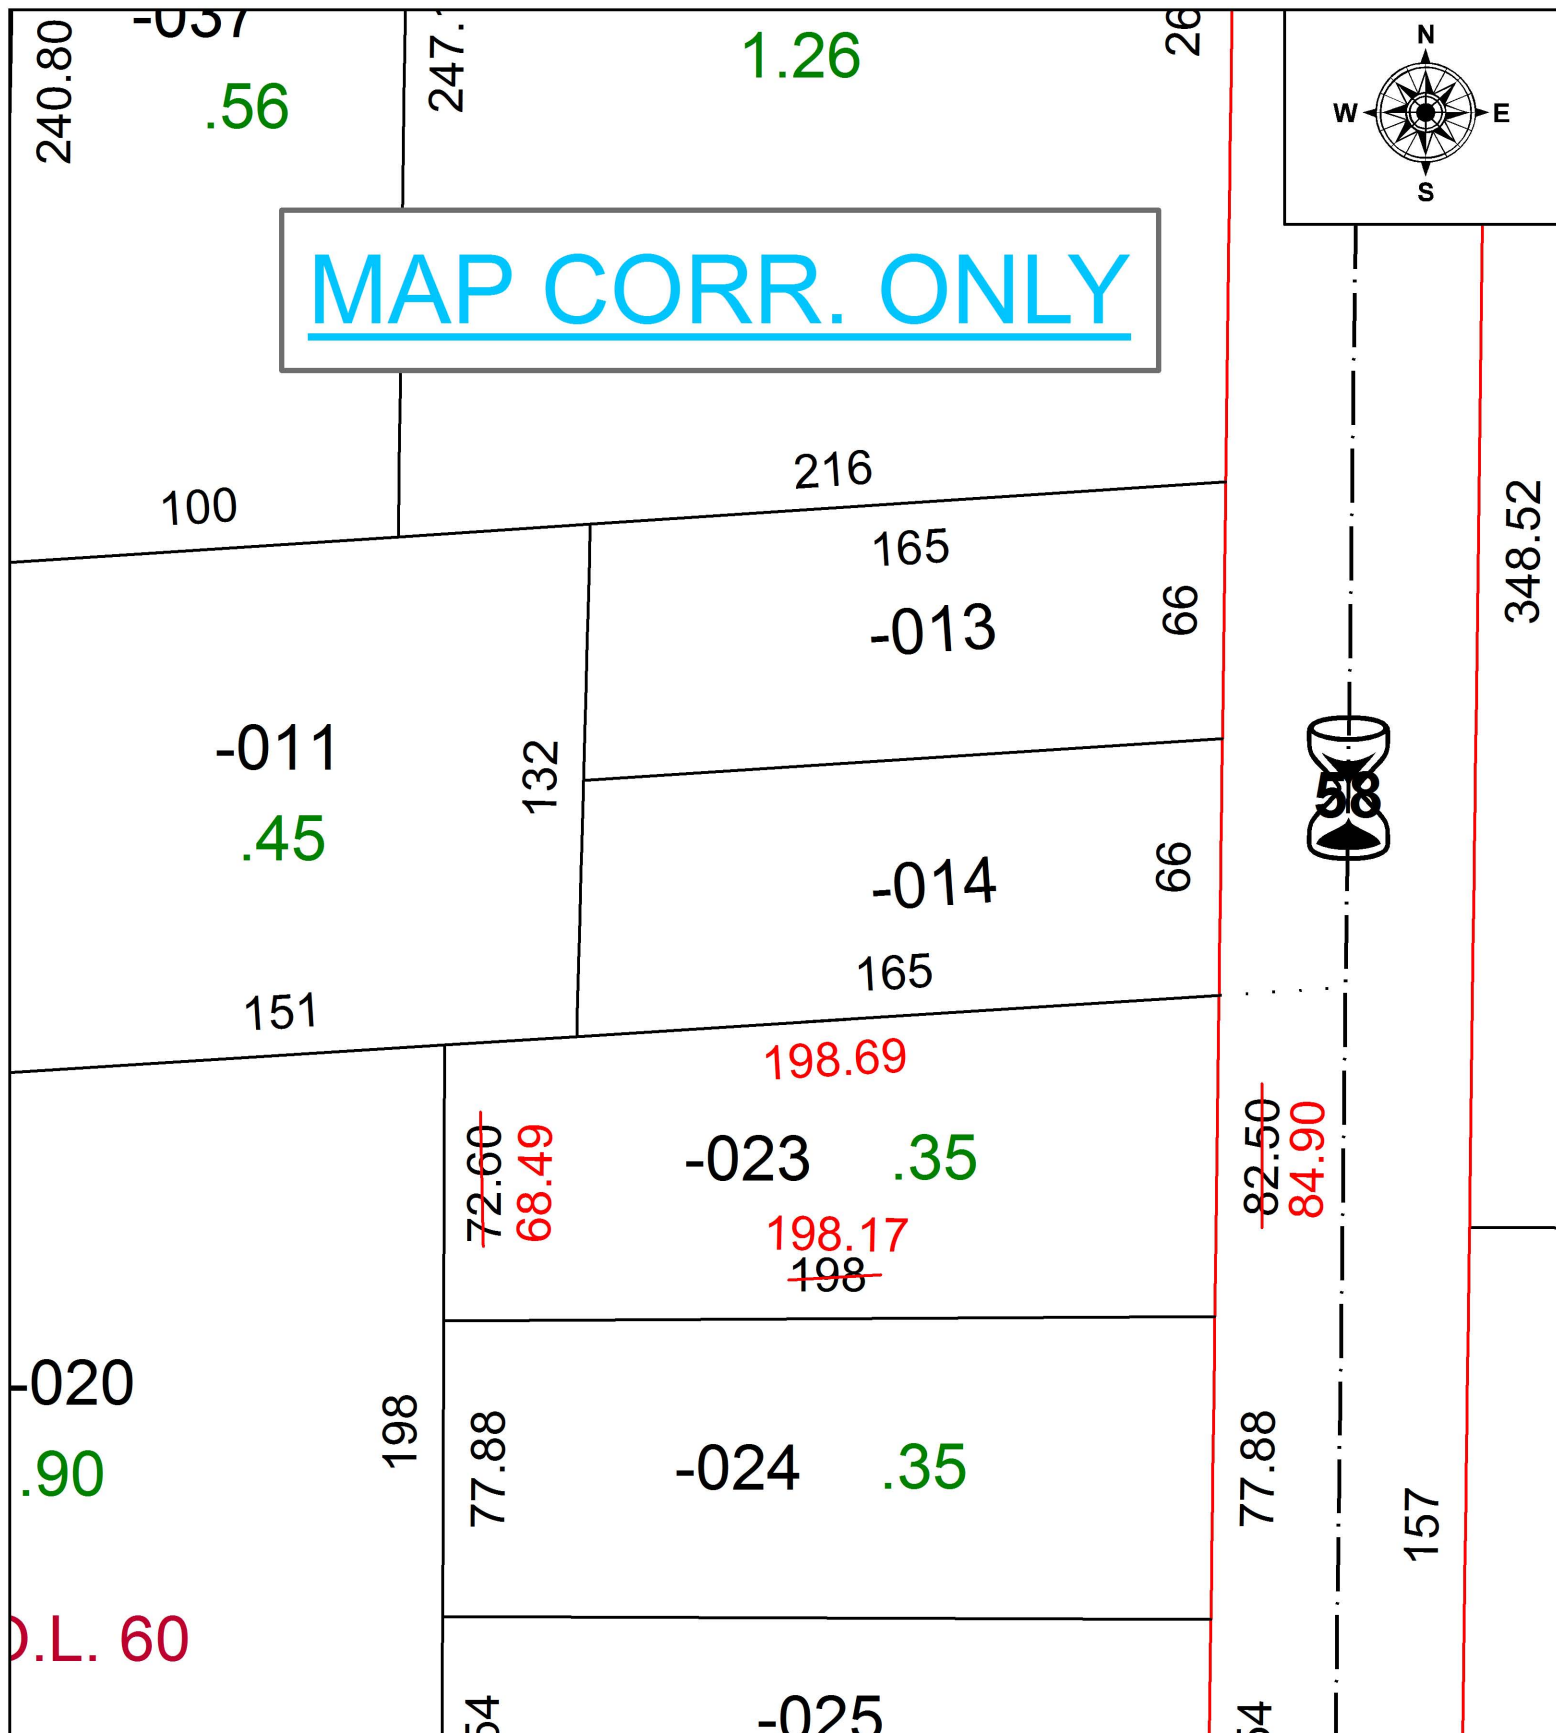

SPLITS/DEEDS PROCESSED
 LORAIN COUNTY TAX MAP DEPARTMENT
 226 MIDDLE AVE. ELYRIA, OH

SURVEYED BY: JAMES P. YURKSCHATT
 CLOSURE: 1: 33,000
 MAP PAGE(S): 12-00-033
 APPROVED BY: TJS DATE: 8/3/16
 SCALE: 1" = 50' PRIOR INSTRUMENT: