
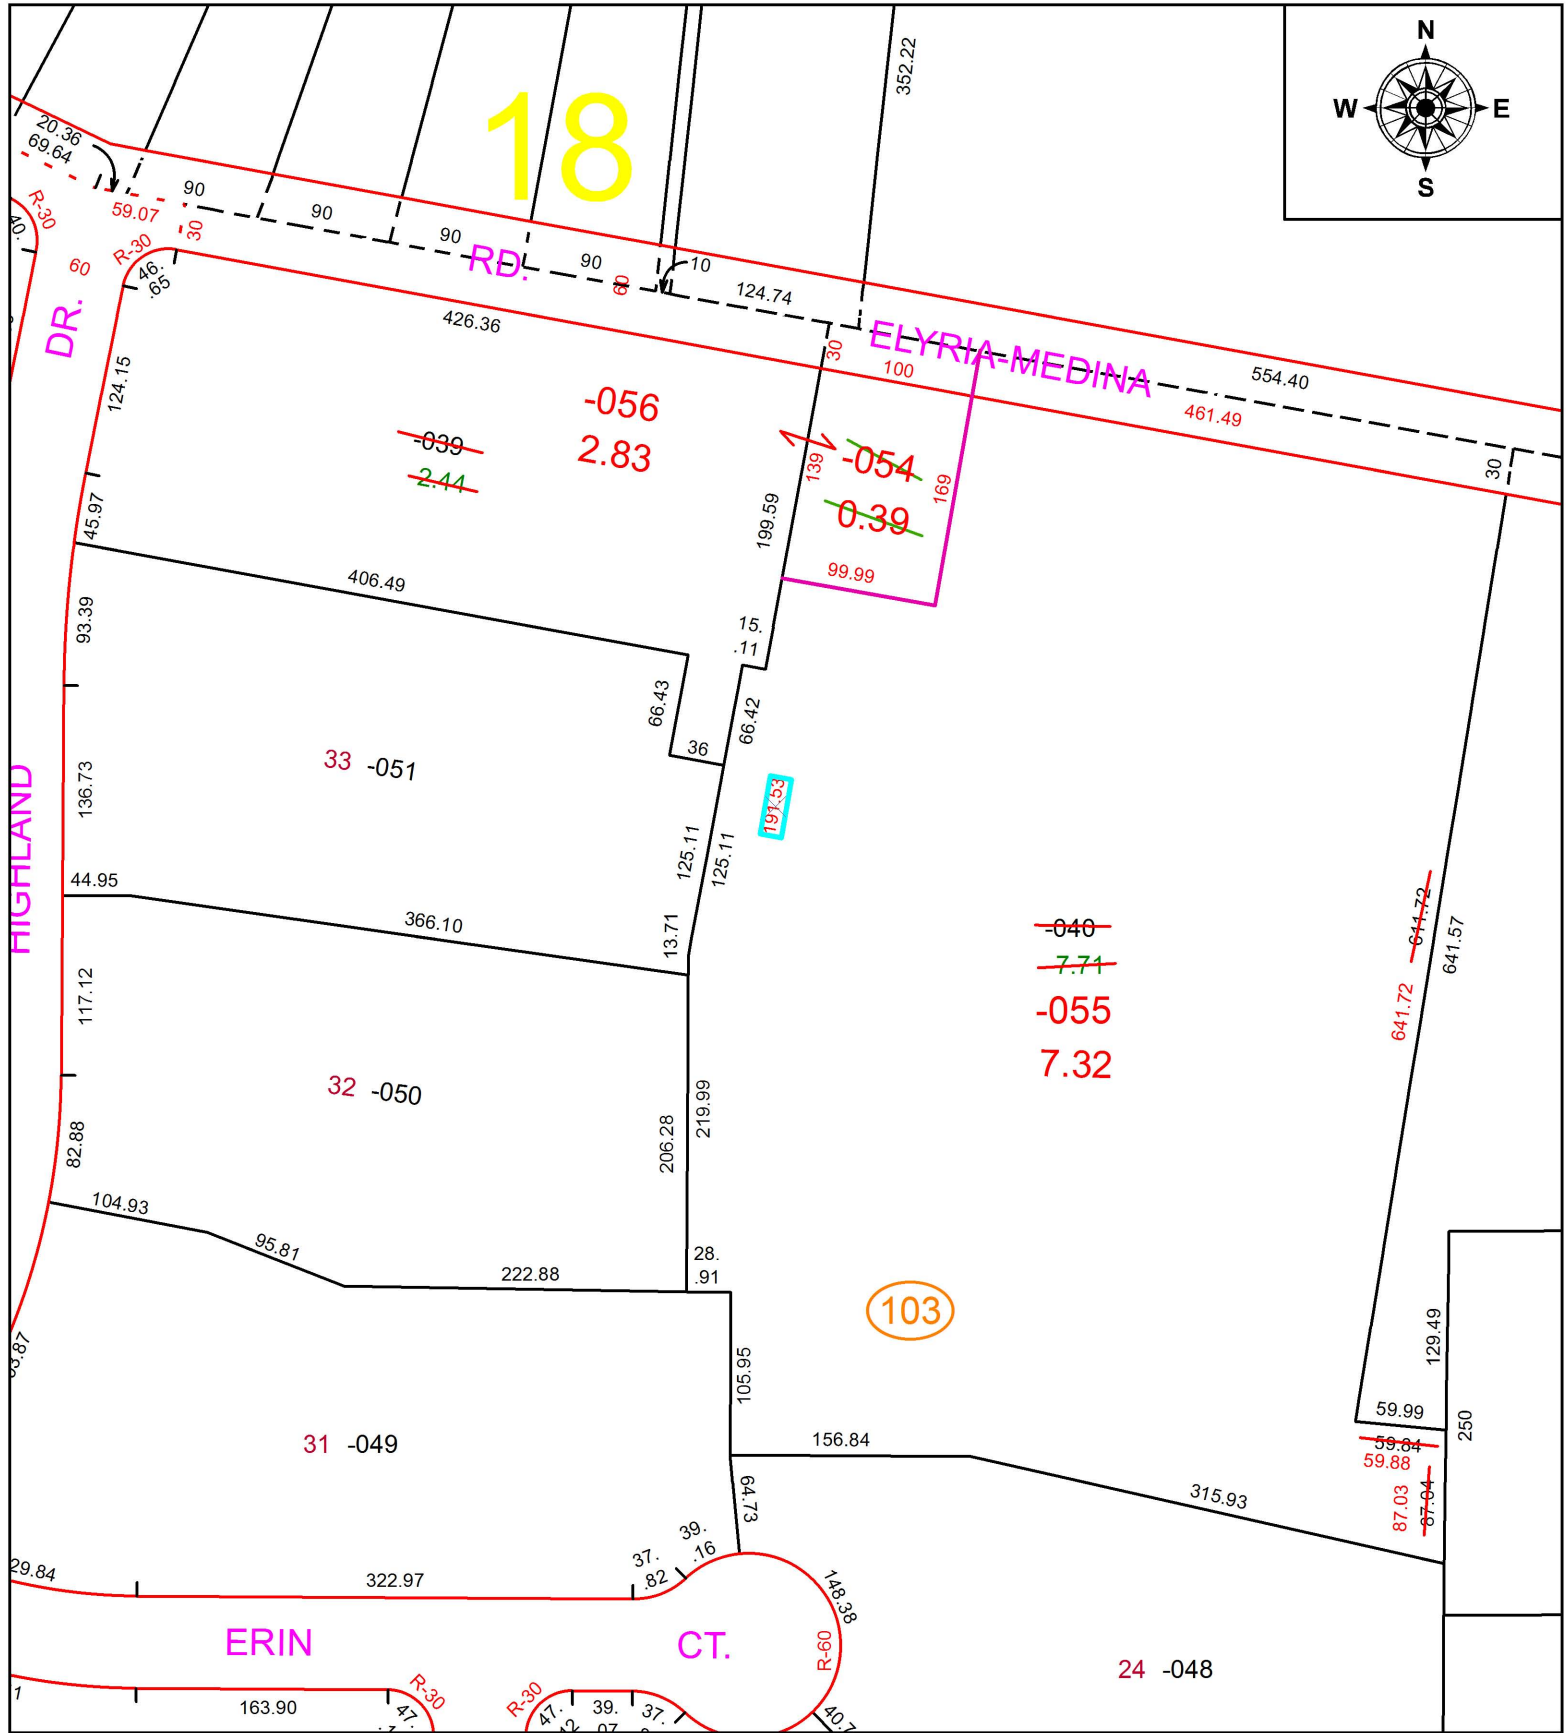


PARENT PARCEL: 16-00-018-103-039, -040

CHILD PARCEL: 16-00-018-103-054, -055, -056

STARTING POINT: CENTERLINE OF HIGHLAND DR & GRAFTON EASTERN RD

16-03492

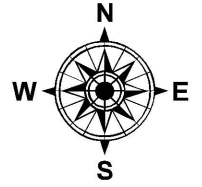

SPLITS/DEEDS PROCESSED
 LORAIN COUNTY TAX MAP DEPARTMENT
 226 MIDDLE AVE. ELYRIA, OH

SURVEYED BY: TIMOTHY FELLER
CLOSURE: 1:391075
MAP PAGE(S): 16-00-018
APPROVED BY: JAH **DATE:** 3/17/2016
SCALE: 1 in = 125 ft **PRIOR INSTRUMENT:** 20070214102