

PARENT PARCEL: 02-02-017-101-026

CHILD PARCEL: XX-XX-XXX-XXX-XXX

STARTING POINT: NORTH LINE OF 23RD ST. & S.W. CORNER OF S/L 26 IN PARK PLAN ALLOT. 1ST. ADDITION

16-03494-A


ACREAGE CORRECTION

02-02-017-107-026

~~50 X 164~~



0.26 A.

CORR. PER
DV 752/64

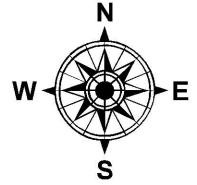

REEVES

W. 22

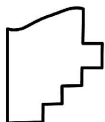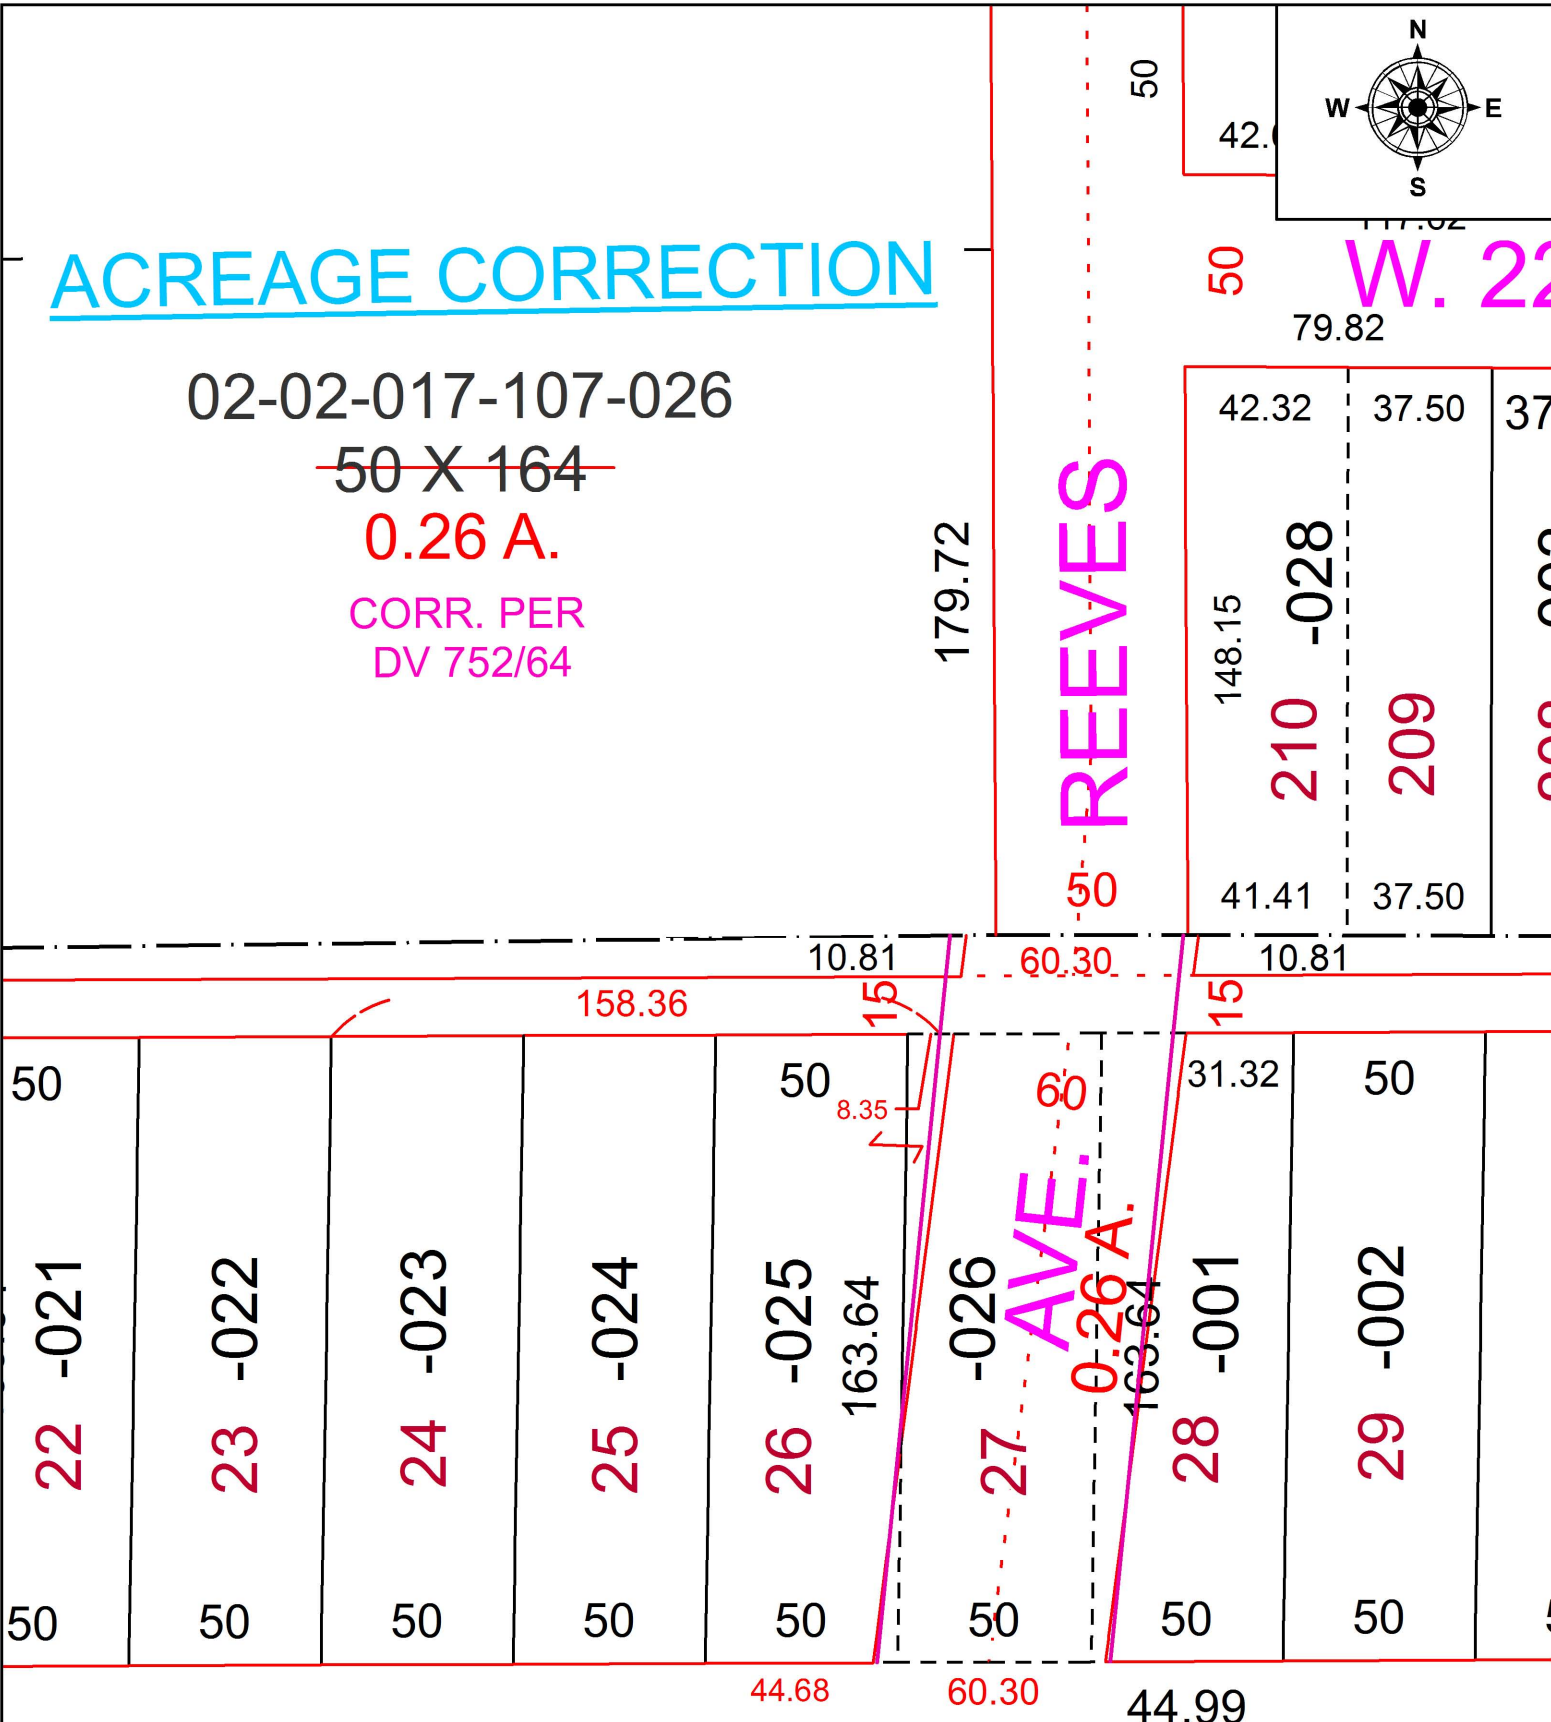

SPLITS/DEEDS PROCESSED
 LORAIN COUNTY TAX MAP DEPARTMENT
 226 MIDDLE AVE. ELYRIA, OH

SURVEYED BY: NA
 CLOSURE: NA
 MAP PAGE(S): 02-02-017
 APPROVED BY: TJS DATE: 8/5/16
 SCALE: 1" = 50 PRIOR INSTRUMENT: DV 752/64