


PARENT PARCEL: 18-00-020-000-134

CHILD PARCEL: XX-XX-XXX-XXX-XXX



STARTING POINT: CL OF ASHLAND-OBERLIN RD. (S.R. 58) & SOUTH LINE OF O.L. 20

16-03499-A

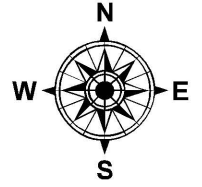

ACREAGE CORRECTION

~~-134~~
~~30.06~~
30.04 A.
CORR. PER SURV.
M.G. HURA
EXCEPTION: D. SEASLY
EXCEPTION: N. NIGH

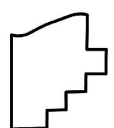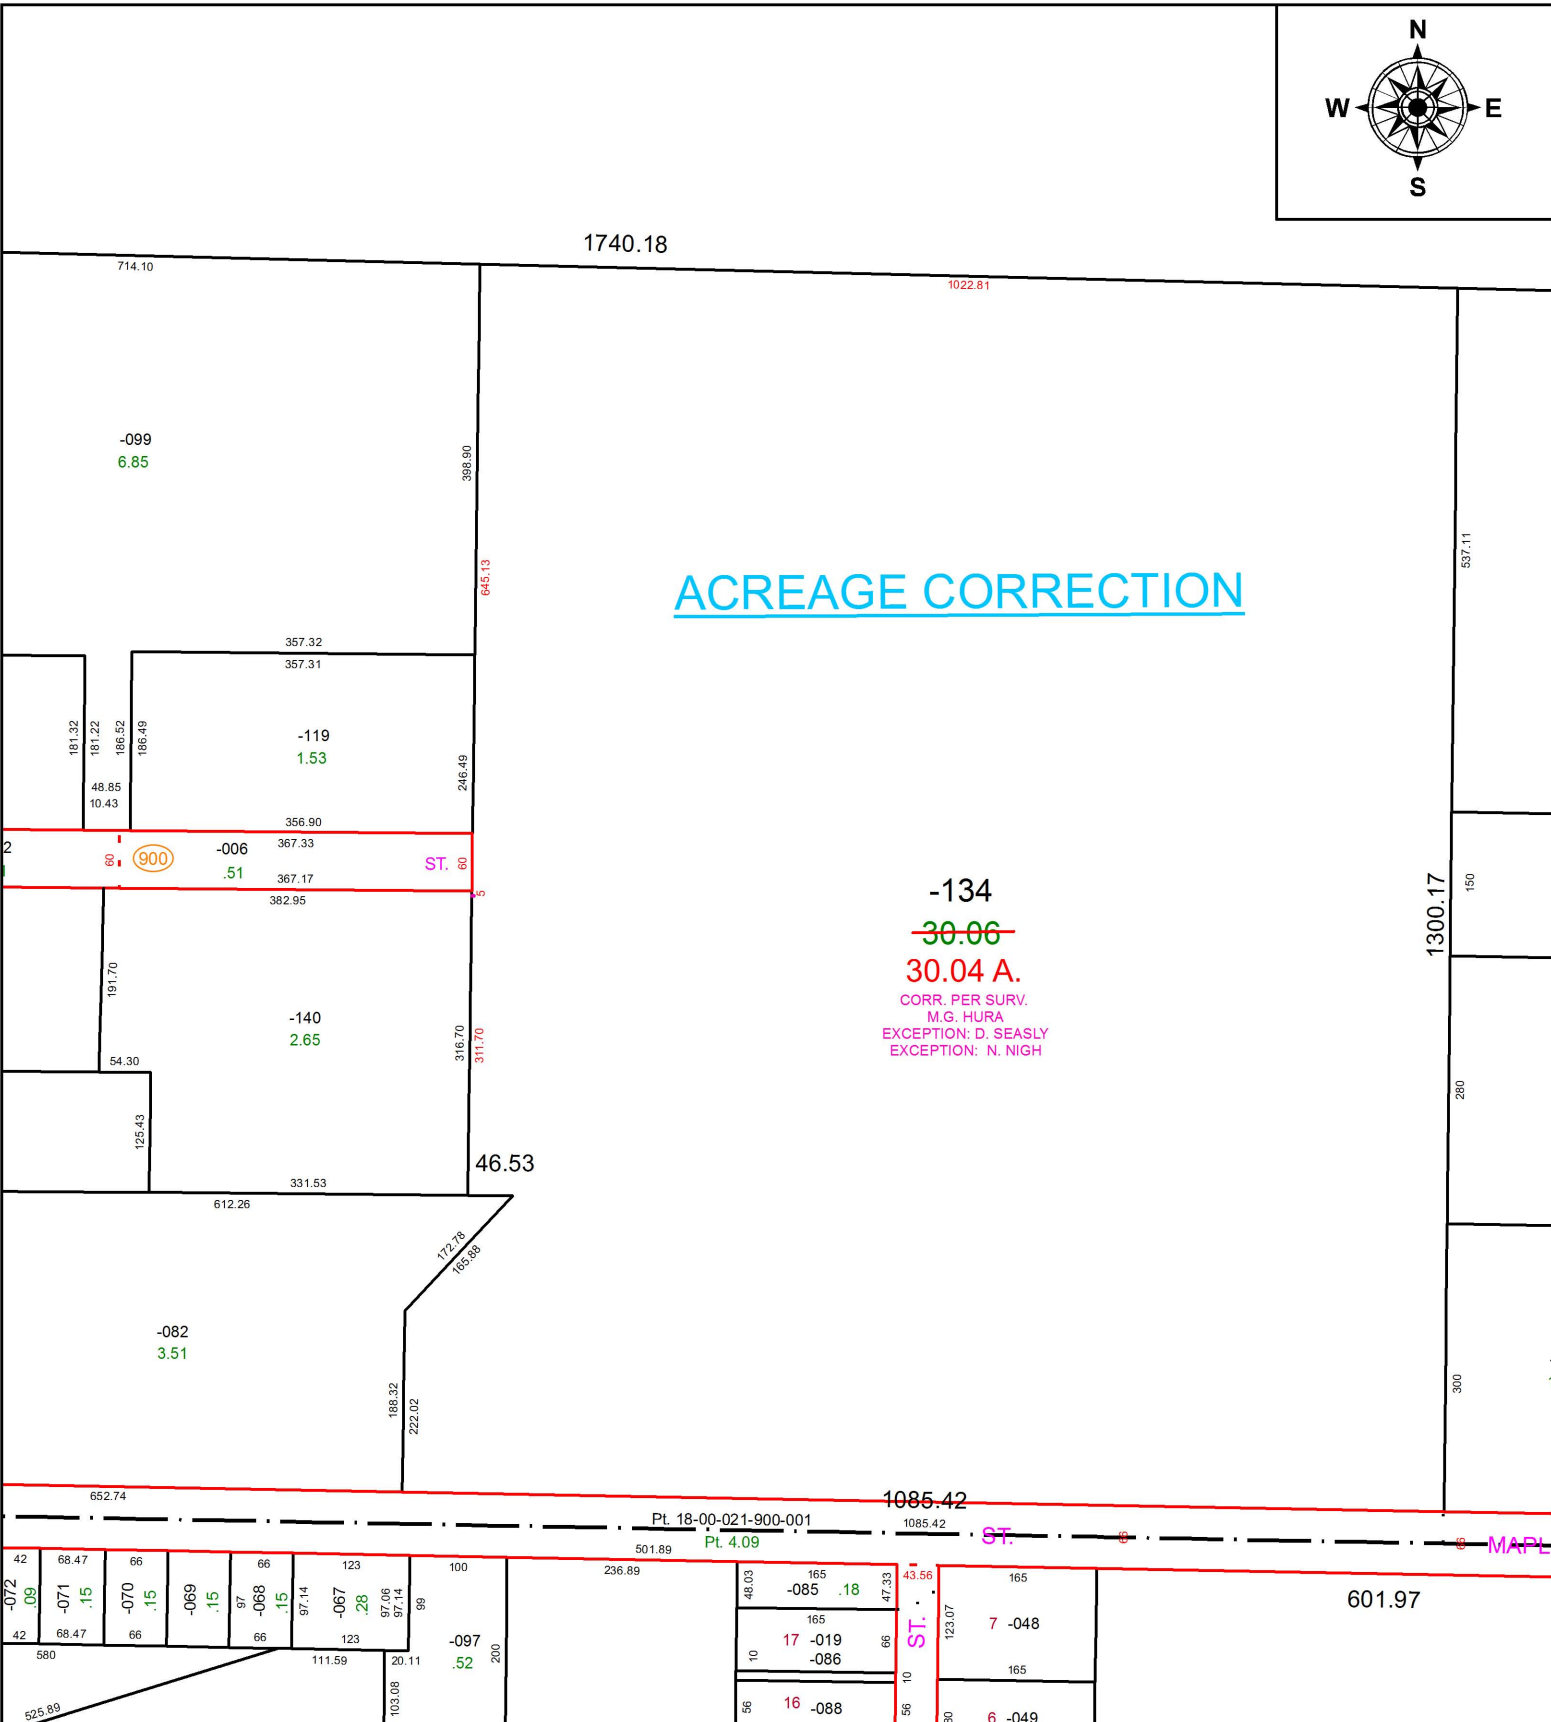

SPLITS/DEEDS PROCESSED
LORAIN COUNTY TAX MAP DEPARTMENT
226 MIDDLE AVE. ELYRIA, OH

SURVEYED BY: M.G. HURA
CLOSURE: 1: 33,000
MAP PAGE(S): 18-00-020
APPROVED BY: TJS DATE: 8/18/16
SCALE: 1" = 200 PRIOR INSTRUMENT: OR 204/488