


PARENT PARCEL: 04-00-017-103-021

CHILD PARCEL: 04-00-017-103-341


STARTING POINT: INTERSECTION OF C/L OF WALKER RD. AND EAST LINE OF EDWARD J. & GLADYS KEARNEY

16-03501-U

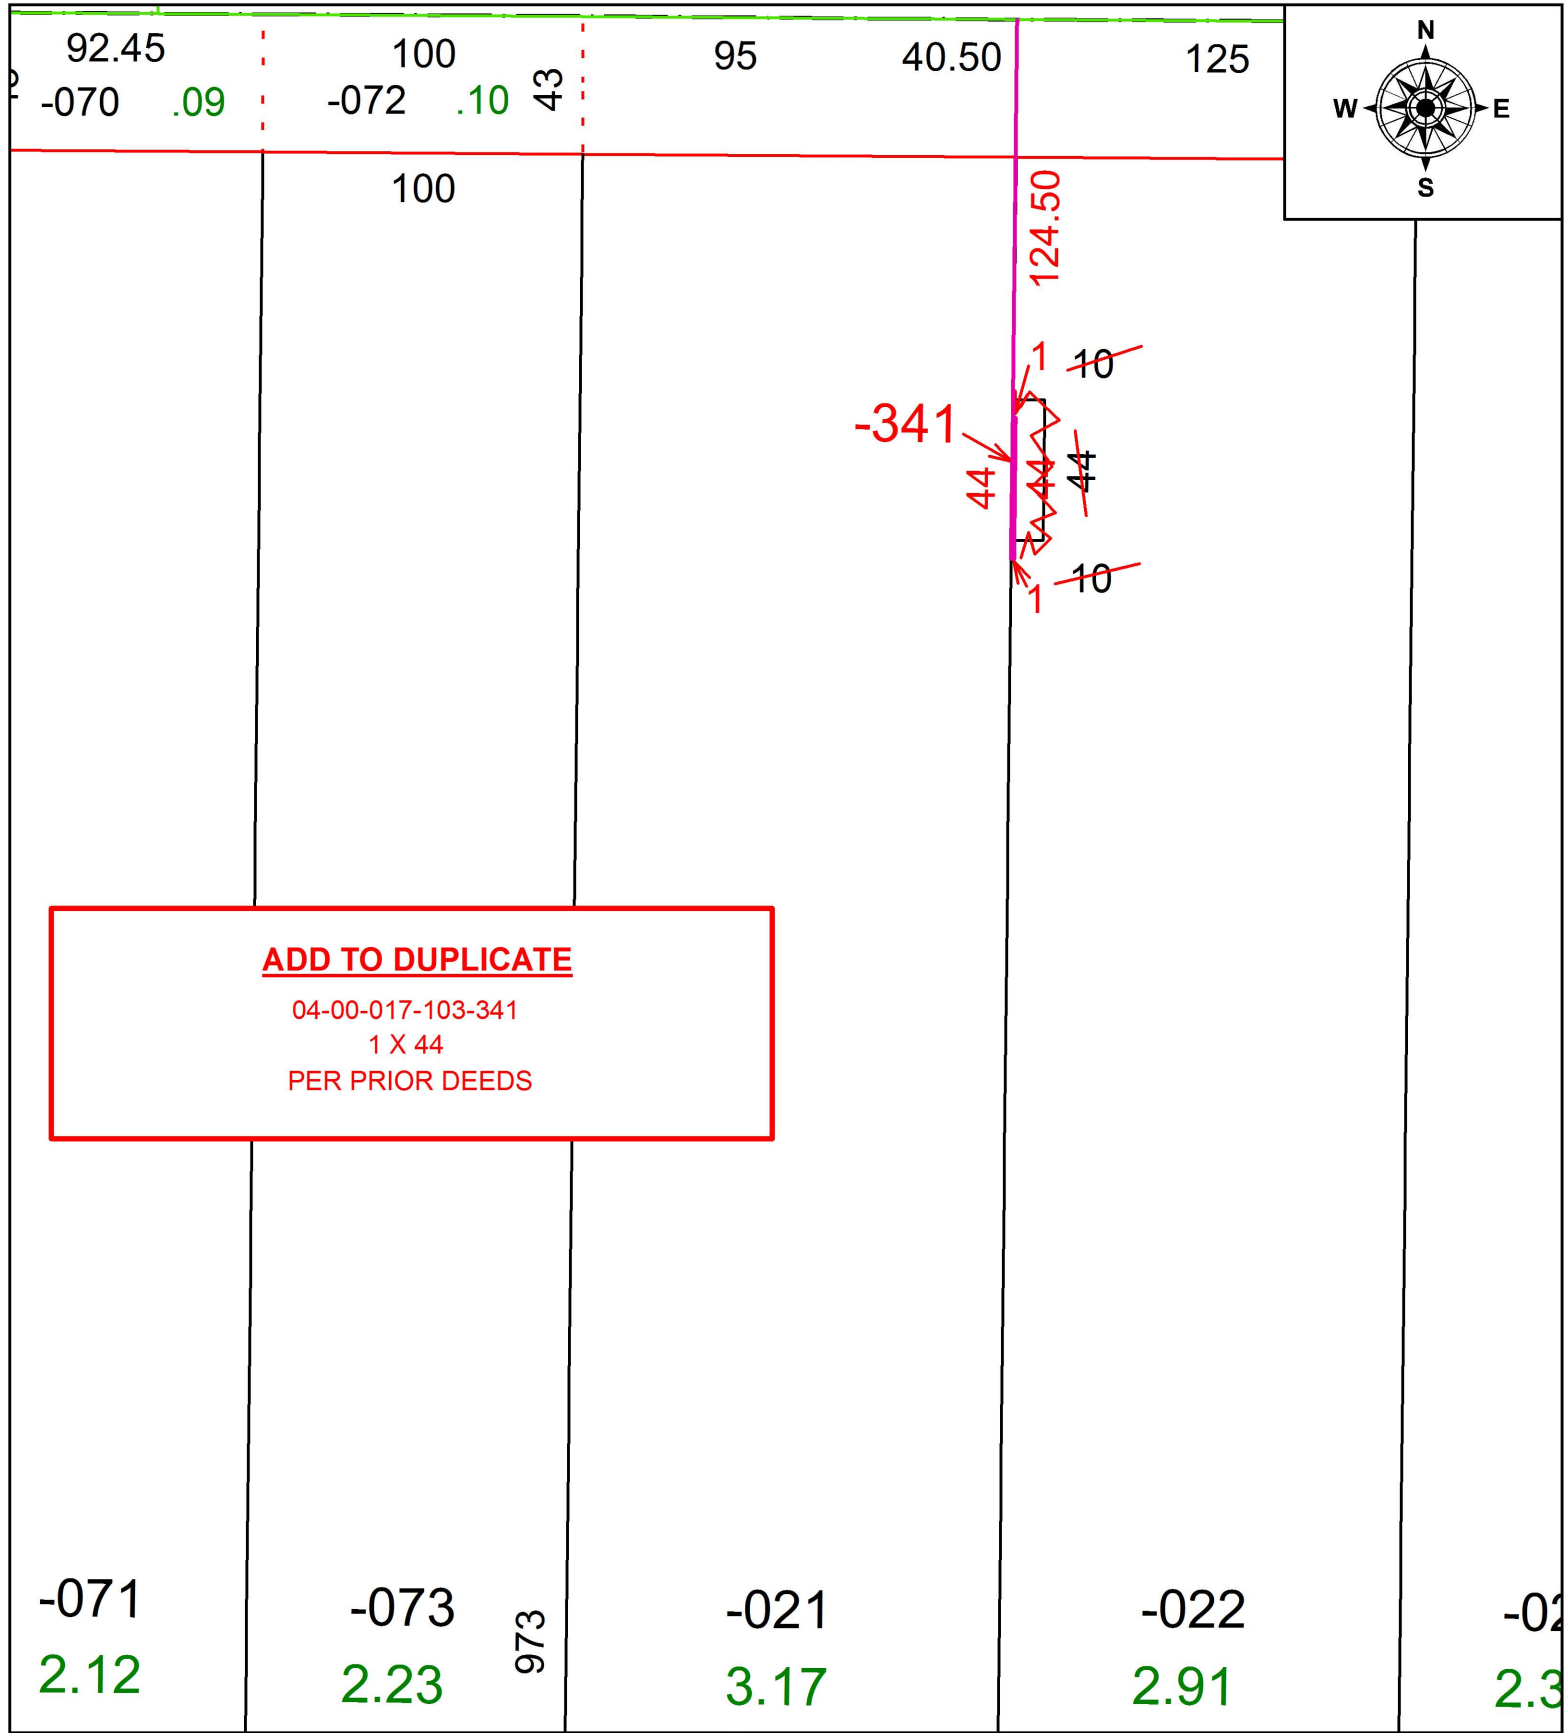

ADD TO DUPLICATE

04-00-017-103-341
1 X 44
PER PRIOR DEEDS

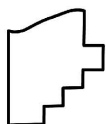

SPLITS/DEEDS PROCESSED
LORAIN COUNTY TAX MAP DEPARTMENT
226 MIDDLE AVE. ELYRIA, OH

SURVEYED BY:	N/A
CLOSURE:	N/A
MAP PAGE(S):	4-00-017
APPROVED BY:	RRM DATE: 8-23-16
SCALE:	1" = 60 PRIOR INSTRUMENT: 20040011848