
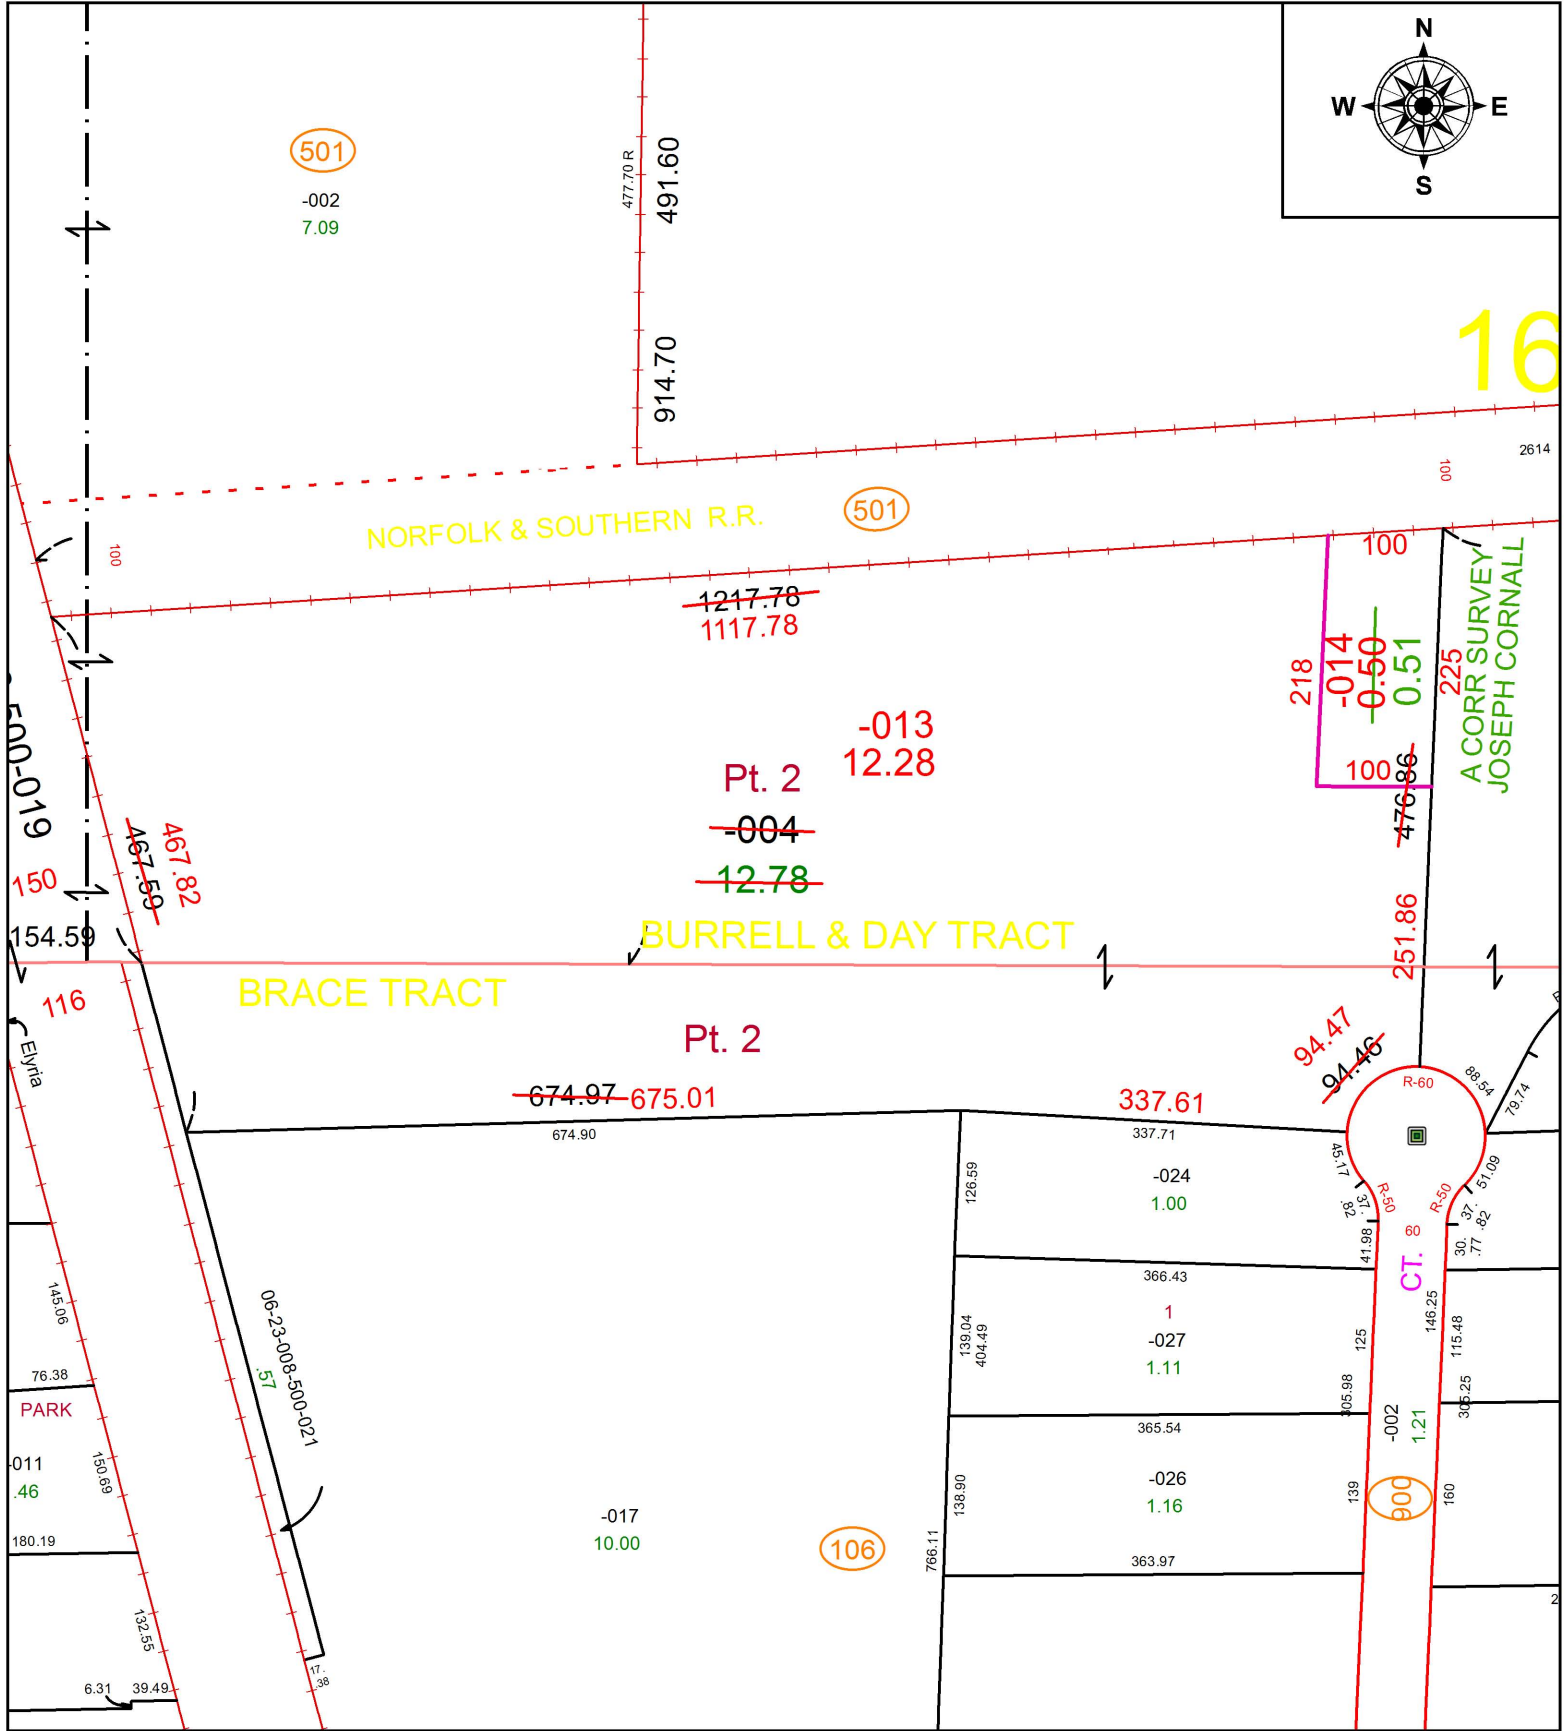


PARENT PARCEL: 06-22-016-000-004

CHILD PARCEL: 06-22-016-000-013, -014

STARTING POINT: NORTHEAST CORNER OF S/L 2 OF MIDWAY INDUSTRIAL PARK

16-03502

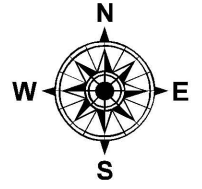

SPLITS/DEEDS PROCESSED
LORAIN COUNTY TAX MAP DEPARTMENT
226 MIDDLE AVE. ELYRIA, OH

SURVEYED BY: JOSEPH CORNALL

CLOSURE: 1:588323

MAP PAGE(S): 06-22

APPROVED BY: JAH DATE: 4/5/2016

SCALE: 1 in = 167 ft PRIOR INSTRUMENT: OR 248/764