
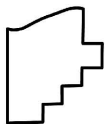


PARENT PARCEL: 01-00-023-000-046

CHILD PARCEL: 01-00-023-000-047, -048

STARTING POINT: CENTERLINE OF BAUMART RD & O.L. 23

16-03506

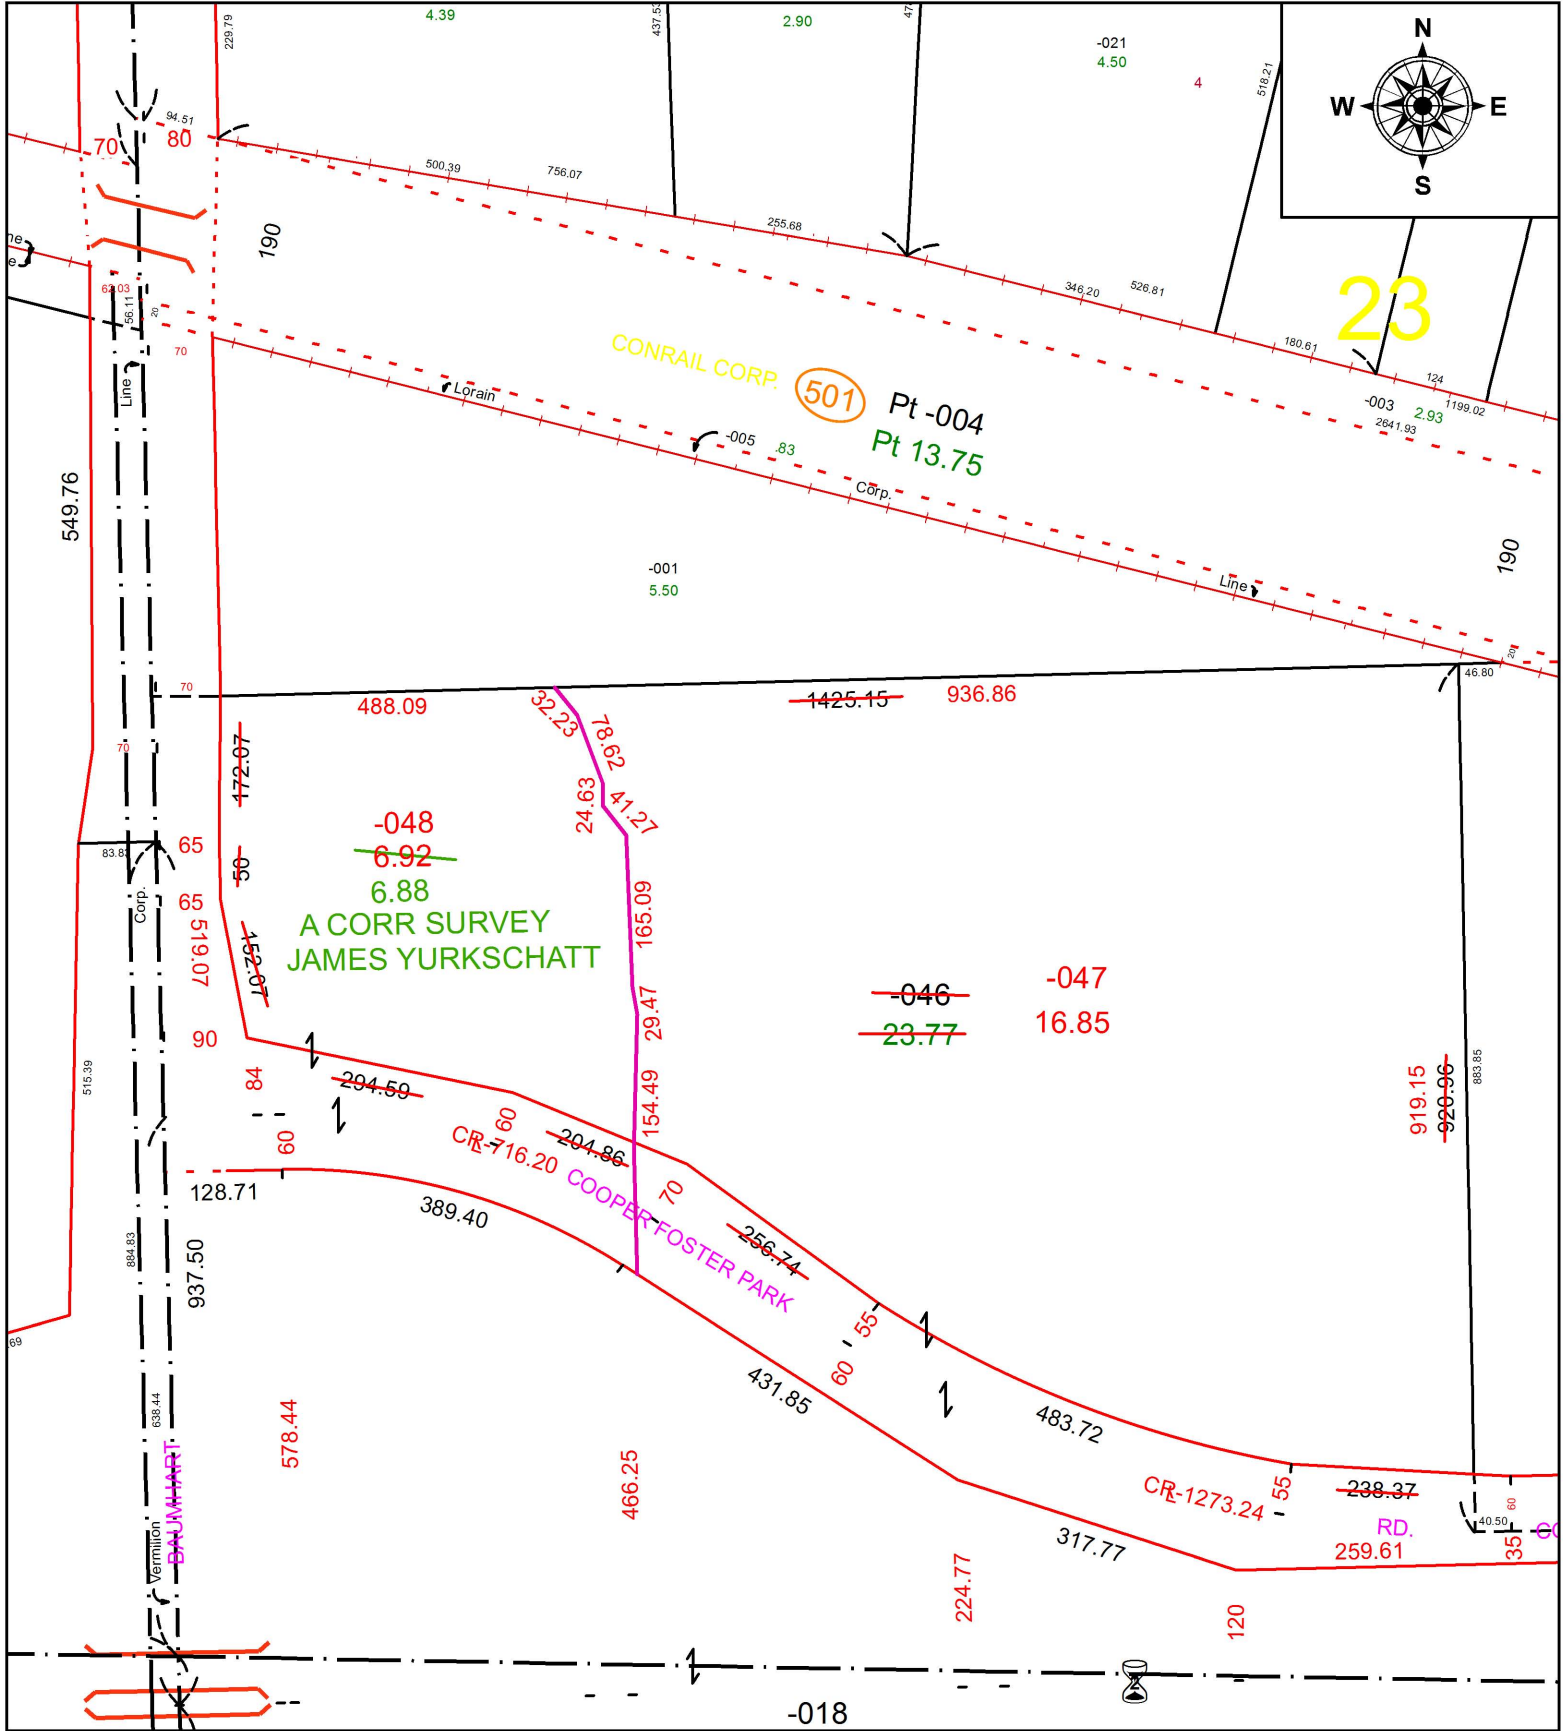

**SPLITS/DEEDS PROCESSED**  
 LORAIN COUNTY TAX MAP DEPARTMENT  
 226 MIDDLE AVE. ELYRIA, OH

**SURVEYED BY:** JAMES YURKSCHATT  
**CLOSURE:** 1:370236  
**MAP PAGE(S):** 01-00-023  
**APPROVED BY:** JAH **DATE:** 04-08-2016  
**SCALE:** 1 in = 208 ft **PRIOR INSTRUMENT:** 19990619990