


PARENT PARCEL: 04-00-029-000-895


CHILD PARCEL: 04-00-029-000-924 thru -927

STARTING POINT: CENTERLINE OF LEAR RD & NORFOLK & WESTERN RR

16-03507

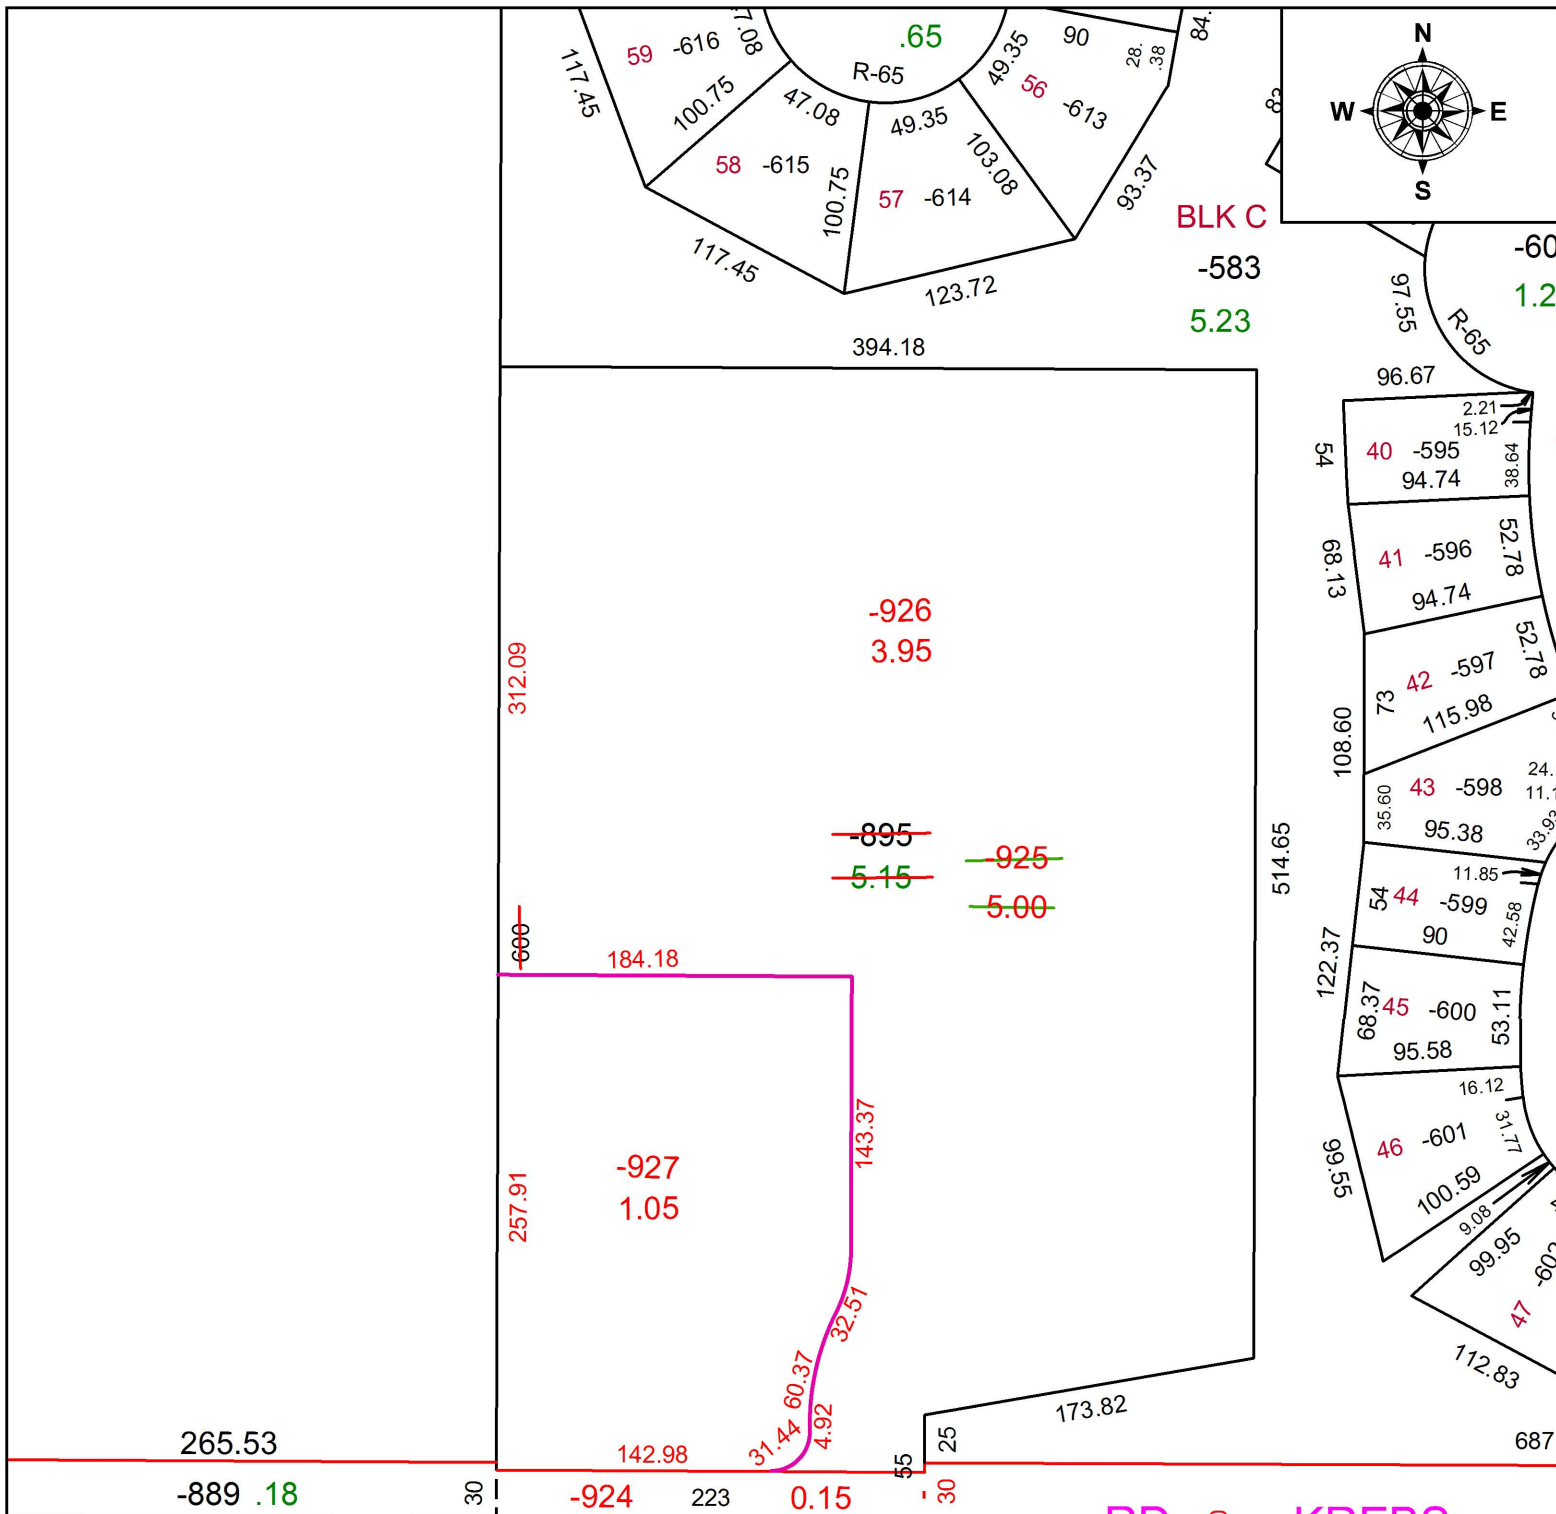

N.R.R. Corp. Line Avon Lake Corp. Line Avon

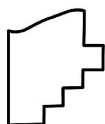

SPLITS/DEEDS PROCESSED
 LORAIN COUNTY TAX MAP DEPARTMENT
 226 MIDDLE AVE. ELYRIA, OH

SURVEYED BY: JAMES T SAYLER
 CLOSURE: 1:262153
 MAP PAGE(S): 04-00-029
 APPROVED BY: JAH DATE: 04/14/2016
 SCALE: 1 in = 100 ft PRIOR INSTRUMENT: 20080244761