
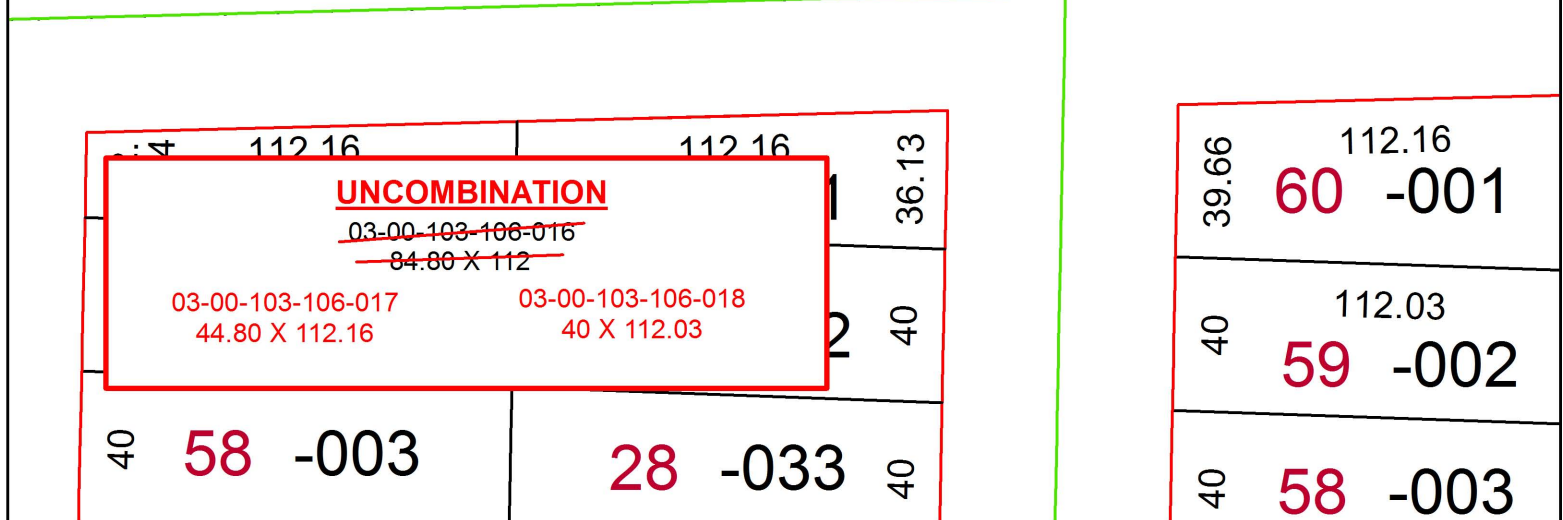


PARENT PARCEL: 03-00-103-106-016

CHILD PARCEL: 03-00-103-106-017, -018

STARTING POINT: S/L'S 1 & 2 IN BLOCK 5 OF CITY VIEW ALLOTMENT

16-03508-U

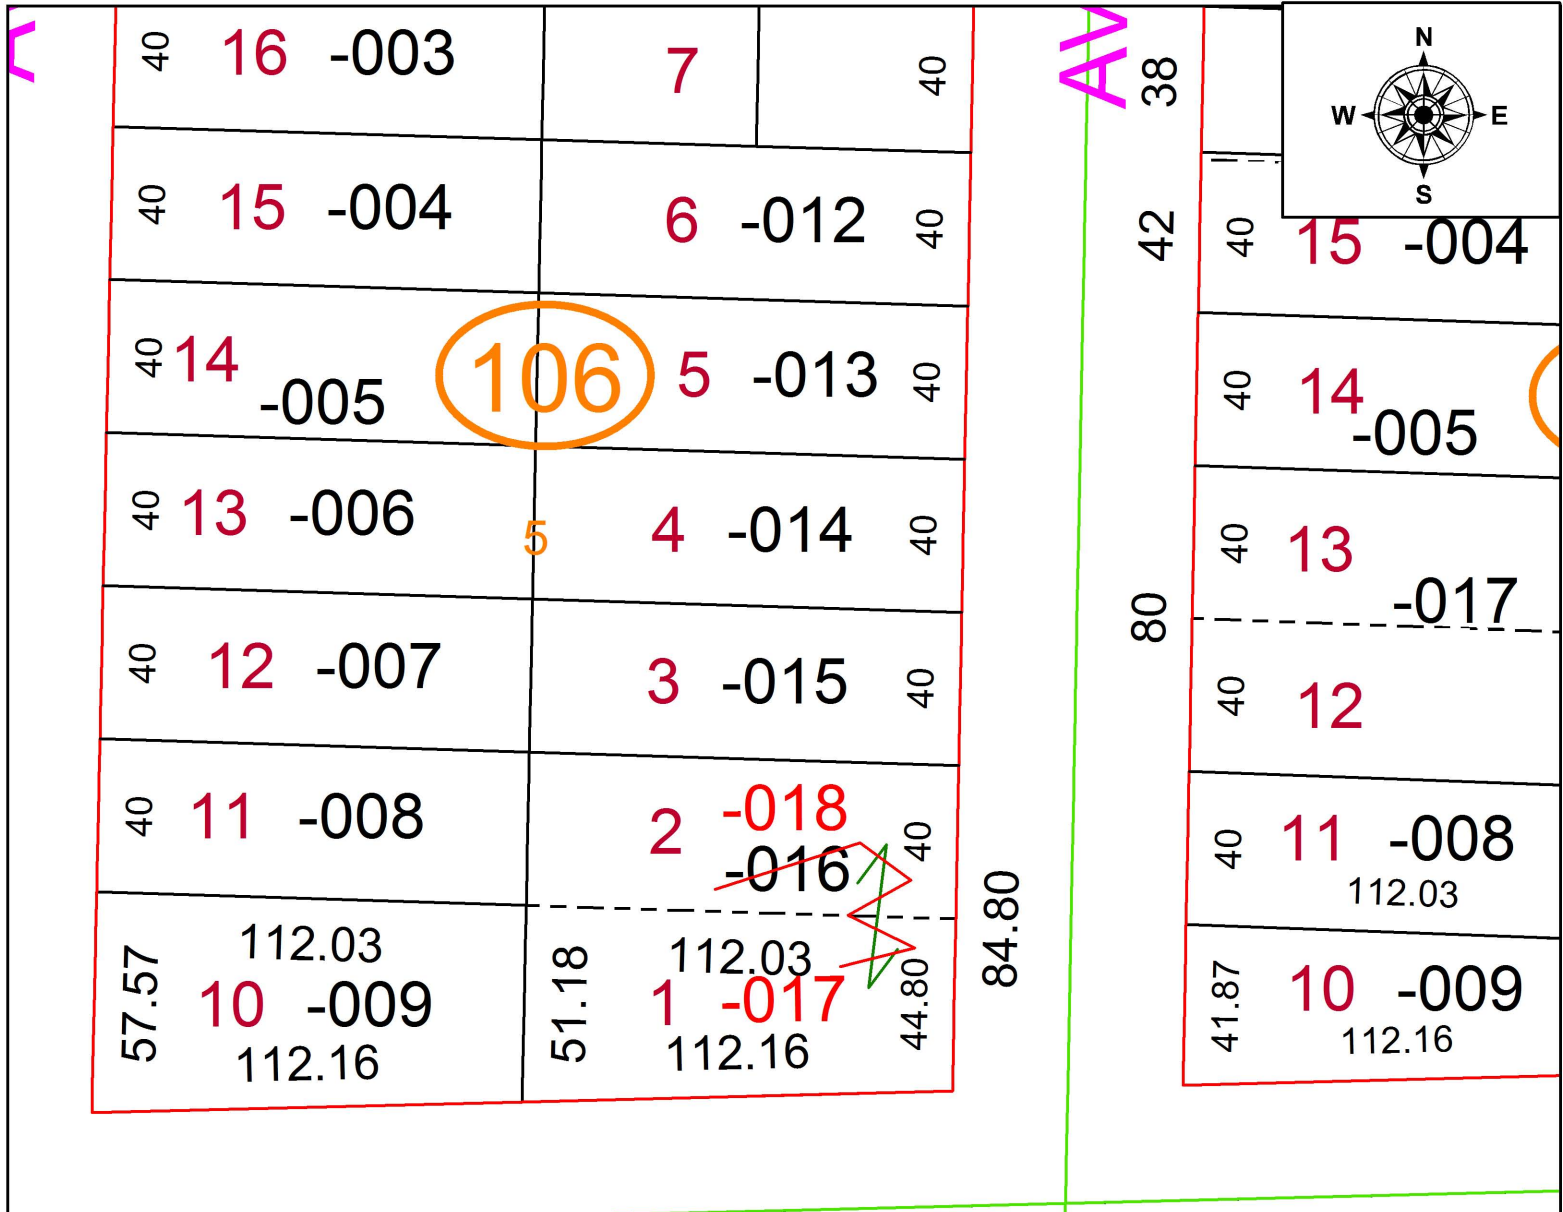

UNCOMBINATION
~~03-00-103-106-016~~
~~84.80 X 112~~
 03-00-103-106-017 03-00-103-106-018
 44.80 X 112.16 40 X 112.03

SPLITS/DEEDS PROCESSED
 LORAIN COUNTY TAX MAP DEPARTMENT
 226 MIDDLE AVE. ELYRIA, OH

SURVEYED BY: _____ N/A
 CLOSURE: _____ N/A
 MAP PAGE(S): _____ 3-00-103
 APPROVED BY: _____ RRM DATE: _____ 8-29-16
 SCALE: _____ 1" = 50 PRIOR INSTRUMENT: _____ 20120416201